



MOUNT MARGARET DEVELOPMENTS PTY LTD
MOUNT MARGARET, ALICE RIVER
STAGE 6B
AS-CONSTRUCTED




SCHEDULE OF DRAWINGS	
DRAWING No.	DESCRIPTION
967192-CI-1600	COVER SHEET
967192-CI-1601	EARTHWORKS LAYOUT PLAN SHEET 1 OF 2
967192-CI-1602	EARTHWORKS LAYOUT PLAN SHEET 2 OF 2
967192-CI-1603	ROADWORKS LONGITUDINAL SECTION BANJO STREET - ROAD H
967192-CI-1604	ROADWORKS CROSS SECTIONS BANJO STREET - ROAD H SHEET 1 OF 2
967192-CI-1605	ROADWORKS CROSS SECTIONS BANJO STREET - ROAD H SHEET 2 OF 2
967192-CI-1606	ROADWORKS LONGITUDINAL SECTION CRYSTAL CRESCENT - ROAD F
967192-CI-1607	ROADWORKS CROSS SECTIONS CRYSTAL CRESCENT - ROAD F
967192-CI-1608	INTERSECTION DETAILS PLAN
967192-CI-1609	WATER RETICULATION LAYOUT PLAN SHEET 1 OF 2
967192-CI-1610	WATER RETICULATION LAYOUT PLAN SHEET 2 OF 2
967192-CI-1611	SOIL EROSION & SEDIMENT CONTROL PLAN SHEET 1 OF 2
967192-CI-1612	SOIL EROSION & SEDIMENT CONTROL PLAN SHEET 2 OF 2

CARDNO (QLD) PTY LTD HEREBY CERTIFY THAT THE WORKS AS SHOWN ON THE AS CONSTRUCTED DRAWINGS REFLECT ANY CHANGES THAT WERE MADE DURING THE COURSE OF CONSTRUCTION.

[Signature]RPEQ
10801RPEQ NO.
06/11/2020DATE

DATE PLOTTED: 6 November 2020 12:41 PM BY: LACHLAN LANDY

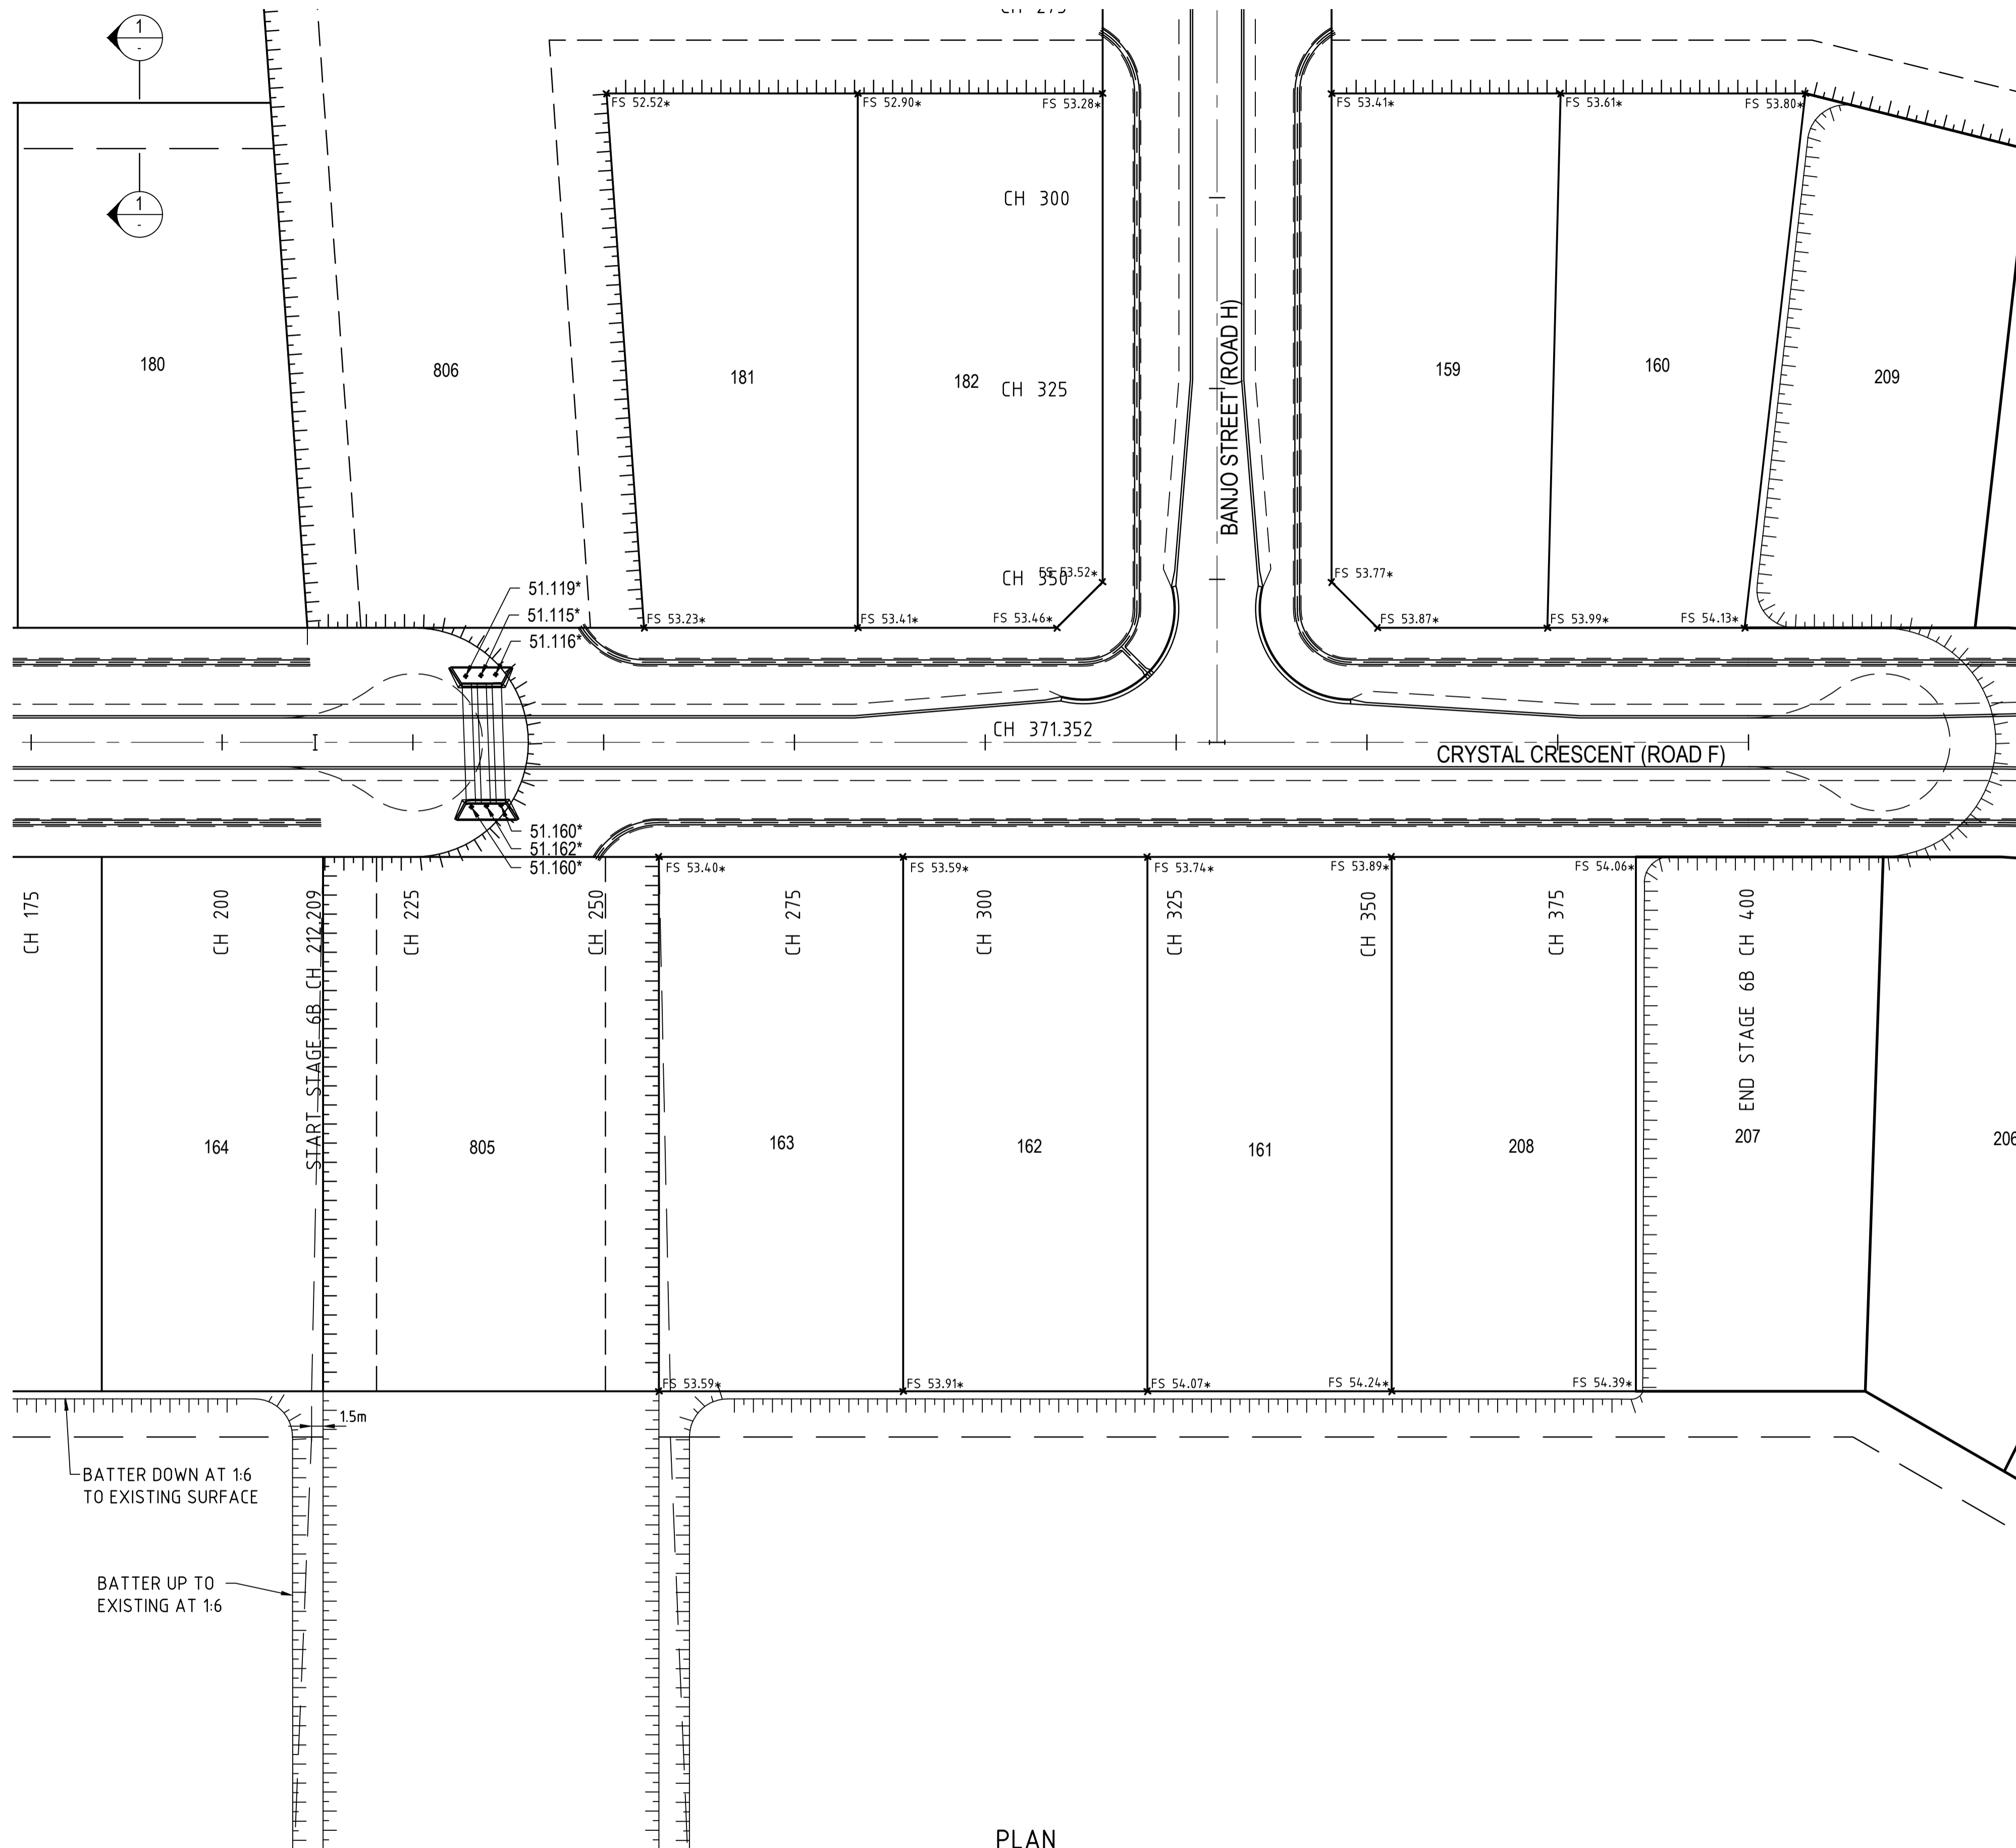

NOTES

1. THIS DRAWING IS TO BE READ IN CONJUNCTION WITH COUNCIL STANDARD ROADWORKS AND STORMWATER DRAWINGS.
2. ALL BACKFILL IS COMPACTED TO NOT LESS THAN 95% OF THE STANDARD MAXIMUM DRY DENSITY TO AS1289 IN MAXIMUM 150mm LAYERS UNLESS NOTED OTHERWISE.
3. ALL CHAINAGES SHOWN ARE PEGGED CHAINAGES UNLESS SHOWN OTHERWISE.
4. ALLOTMENTS ARE GRADED EVENLY BETWEEN LEVELS SHOWN. CONSTRUCTED LOT GRADE IS MINIMUM 1:4.00.
5. ALL BATTERS WITHIN ALLOTMENTS ARE MAXIMUM 1 : 6 UNLESS NOTED OTHERWISE.

LEGEND

- FS 11.05* CERTIFIED FINISHED ALLOTMENT LEVEL
- TOP OF BATTER
- BOTTOM OF BATTER

AS CONSTRUCTED

Rowlands Surveys Pty Ltd (ACN 010 025 260) hereby certify that the works detailed on this drawing, denoted *, have been constructed to the dimensions and levels shown

Date : 9/11/2020

Laurence John Nolan
Director / Registered Surveyor

CARDNO (QLD) PTY LTD HEREBY CERTIFY THAT THE WORKS AS SHOWN ON THE AS CONSTRUCTED DRAWINGS REFLECT ANY CHANGES THAT WERE MADE DURING THE COURSE OF CONSTRUCTION.

[Signature] RPEQ
10801 RPEQ NO.
06/11/2020 DATE

Q50 LEVELS

CRYSTAL CRESCENT (ROAD F)		
CHAINAGE	LHS LEVEL	RHS LEVEL
25	53.4	53.5
50	53.4	53.4
75	53.4	53.4
100	53.3	53.4
125	53.1	53.4
150	53.1	53.3
175	53.0	53.3
200	52.9	53.2
225	51.9	53.2
250	51.9	53.2
275	53.0	53.4
300	53.2	53.5
325	53.3	53.6
350	53.5	53.7
375	53.6	53.8
400	53.7	54.0



Q50 LEVELS

BANJO STREET (ROAD H)		
CHAINAGE	LHS LEVEL	RHS LEVEL
89.105	52.1	52.0
100	52.1	52.1
125	52.3	52.2
150	52.4	52.3
175	52.5	52.3
200	52.6	52.3
225	52.7	52.2
250	52.7	51.9
275	52.7	51.9
300	53.1	53.0
325	53.2	53.0
350	53.4	53.3

BATTER DOWN AT 1:6 TO EXISTING SURFACE

BATTER UP TO EXISTING AT 1:6

PLAN
SCALE 1500 @ A1

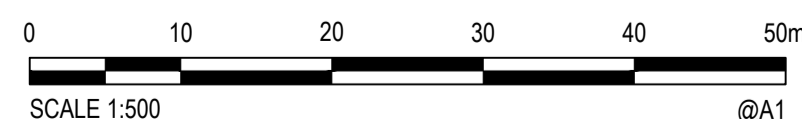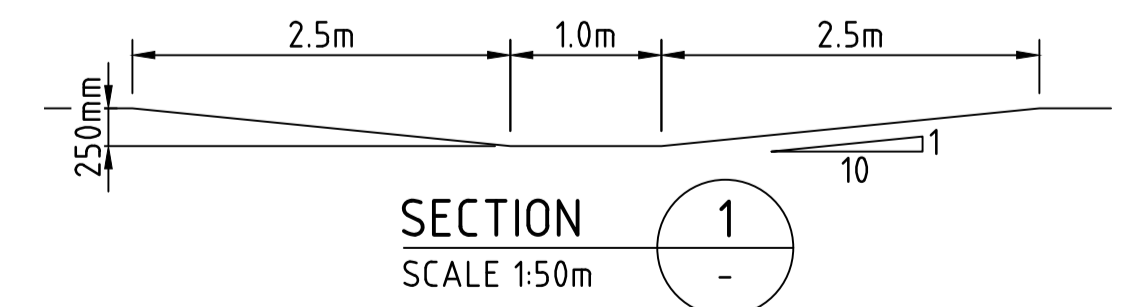

© Cardno Limited All Rights Reserved.
This document is produced by Cardno Limited solely for the benefit of and use by the client in accordance with the terms of the retainer. Cardno Limited does not and shall not assume any responsibility or liability whatsoever to any third party arising out of any use or reliance by third party on the content of this document.

Cardno (Qld) Pty Ltd | ABN 57 051 074 992
Level 1, 520 Flinders Street
Townsville, QLD 4810
Tel: 07 4772 1166 Fax: 07 4721 2508
Web: www.cardno.com.au

Drawn LL	Date 6/11/2020
Checked JW	Date 6/11/2020
Designed JN	Date 6/11/2020
Verified JW	Date 6/11/2020
Approved <i>[Signature]</i>	Date 10801
MB	DATE: 6/11/2020

Client	MOUNT MARGARET DEVELOPMENTS PTY LTD
Project	MOUNT MARGARET, ALICE RIVER
Stage	STAGE 6B AS-CONSTRUCTED
Title	EARTHWORKS LAYOUT PLAN SHEET 1 OF 2


Status	AS CONSTRUCTED			
Datum	Date	Scale	Size	Revision
A.H.D	6/11/2020	As Shown	A1	
Drawing Number	967192-CI-1601			Revision
				A

XREFS: XR-967192-CADASTRAL; XR-967192-DESIGN-CONTOURS-STG6; XR-967192-EXISTING-CONTOURS-STG678
CAD File: S:\PROJECTS\TOWNSVILLE OFFICE\9600\96719671-92 - Mount Margaret\ENGINEERING\AS CONSTRUCTED\STAGE 6\STAGE 6B\967192-CI-1601.dwg

Rev.	Date	Description	Des.	Verif.	Appd.
A	6/11/2020	AS-CONSTRUCTED ISSUE	LL	JW	MB

DATE PLOTTED: 6 November 2020 12:42 PM BY: LACHLAN LINDY

XREFS: XR-967192-CADASTRAL; XR-967192-DESIGN-CONTOURS-STG6; XR-967192-EXISTING-CONTOURS-STG6; XR-967192-MASTER; XR-967192-MASTER AC
 CAD File: S:\PROJECTS\TOWNSVILLE OFFICE\967192-02 - Mount Margaret\ENGINEERING\AS CONSTRUCTED\STAGE 6\STAGE 6B\967192-CI-1602.dwg

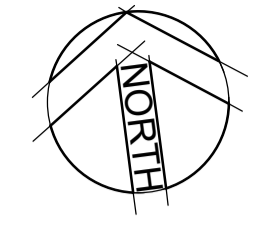

AS CONSTRUCTED

Rowlands Surveys Pty Ltd (ACN 010 025 260) hereby certify that the works detailed on this drawing, denoted *, have been constructed to the dimensions and levels shown

Date: 9/11/2020

Laurence John Nolan
 Director / Registered Surveyor

CARDNO (QLD) PTY LTD HEREBY CERTIFY THAT THE WORKS AS SHOWN ON THE AS CONSTRUCTED DRAWINGS REFLECT ANY CHANGES THAT WERE MADE DURING THE COURSE OF CONSTRUCTION.


[Signature] RPEQ
 10801 RPEQ NO.
 06/11/2020 DATE

NOTES

- THIS DRAWING IS TO BE READ IN CONJUNCTION WITH COUNCIL STANDARD ROADWORKS AND STORMWATER DRAWINGS.
- ALL BACKFILL TO BE COMPACTED TO NOT LESS THAN 95% OF THE STANDARD MAXIMUM DRY DENSITY TO AS1289 IN MAXIMUM 150mm LAYERS UNLESS NOTED OTHERWISE.
- ALL CHAINAGES SHOWN ARE PEGGED CHAINAGES UNLESS SHOWN OTHERWISE.
- ALLOTMENTS TO BE GRADED EVENLY BETWEEN LEVELS SHOWN. CONSTRUCTED LOT GRADE TO BE MINIMUM 1:4.00.
- ALL BATTERS WITHIN ALLOTMENTS TO BE MAXIMUM 1:6 UNLESS NOTED OTHERWISE.
- TOPSOIL TO FOOTPATHS TO FINISH 30mm BELOW TOP OF KERB OR INVERT LEVEL. REFER DETAIL ON DRAWING 967192-CI-627.

LEGEND


- FS 11.05* CERTIFIED FINISHED ALLOTMENT LEVEL
- TOP OF BATTER
- BOTTOM OF BATTER

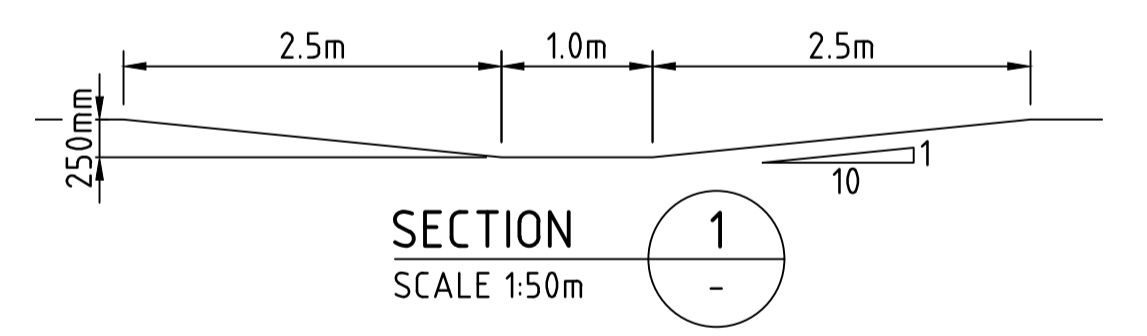

JOINS 967192-CI-604

PLAN
 SCALE 1:500 @ A1

Rev.	Date	Description	Des.	Verif.	Appd.
A	6/11/2020	AS-CONSTRUCTED ISSUE	LL	JW	MB

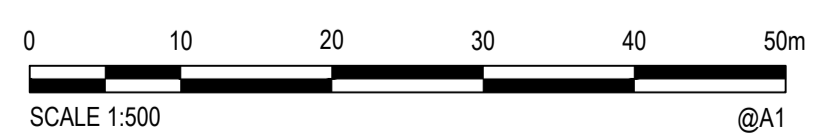

© Cardno Limited All Rights Reserved.
 This document is produced by Cardno Limited solely for the benefit of and use by the client in accordance with the terms of the retainer. Cardno Limited does not and shall not assume any responsibility or liability whatsoever to any third party arising out of any use or reliance by third party on the content of this document.






Cardno
 Shaping the Future
 Cardno (Qld) Pty Ltd | ABN 57 051 074 992
 Level 1, 520 Flinders Street
 Townsville, QLD 4810
 Tel: 07 4772 1166 Fax: 07 4721 2508
 Web: www.cardno.com.au

Drawn	LL	Date	6/11/2020
Checked	JW	Date	6/11/2020
Designed	JN	Date	6/11/2020
Verified	JW	Date	6/11/2020
Approved	<i>[Signature]</i>	Date	10801
MB		DATE:	6/11/2020

Client	MOUNT MARGARET DEVELOPMENTS PTY LTD
Project	MOUNT MARGARET, ALICE RIVER
	STAGE 6B
	AS-CONSTRUCTED
Title	EARTHWORKS LAYOUT PLAN
	SHEET 2 OF 2

Status	AS CONSTRUCTED						
Datum	A.H.D	Date	6/11/2020	Scale	As Shown	Size	A1
Drawing Number	967192-CI-1602			Revision	A		

DATE PLOTTED: 6 November 2020 12:42 PM BY: LACHLAN LANDY

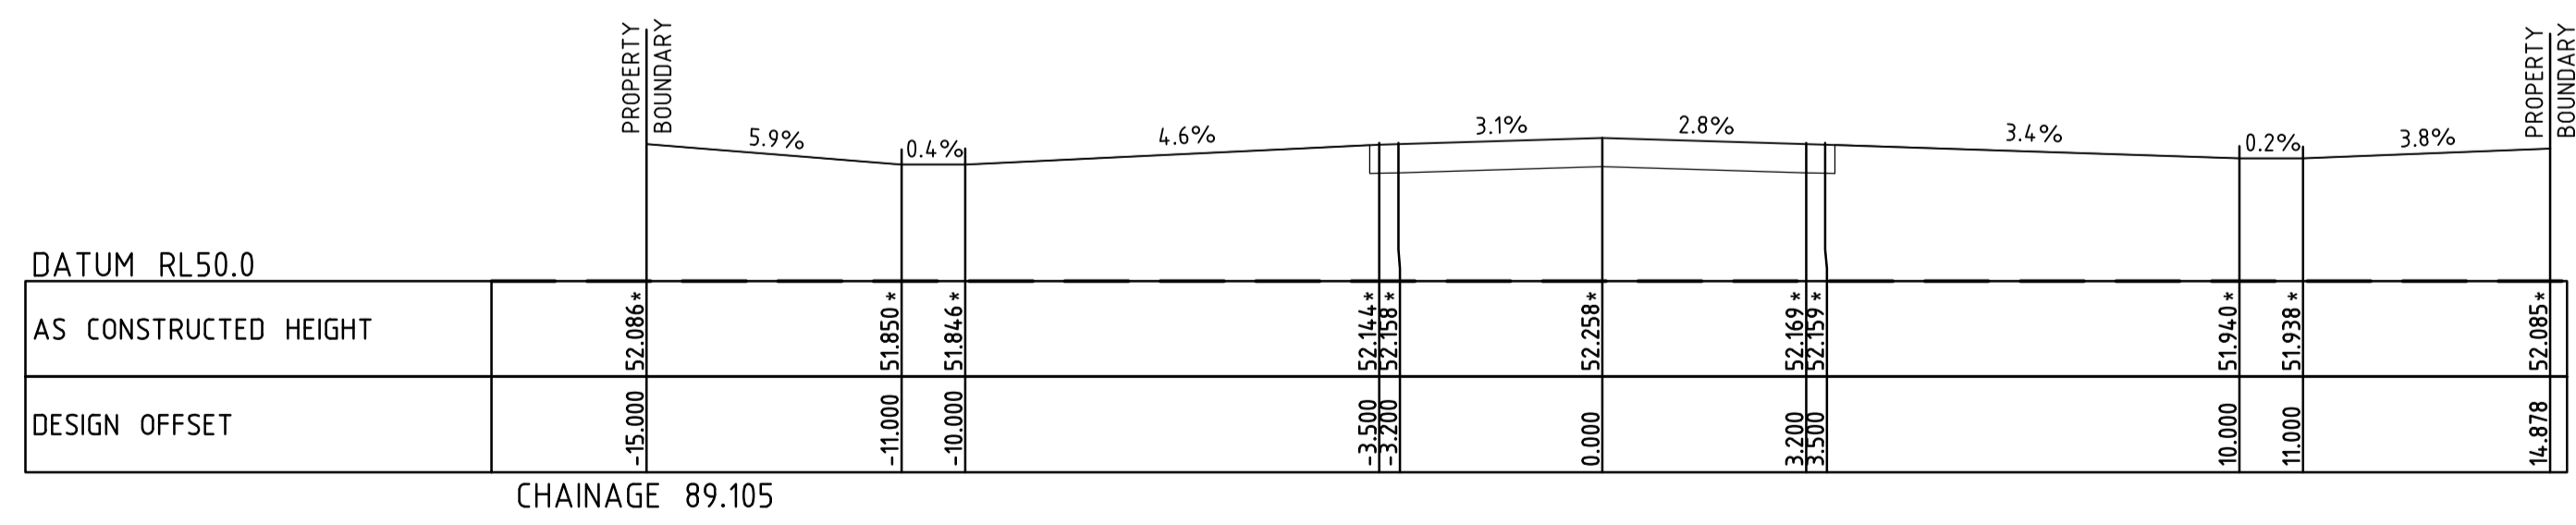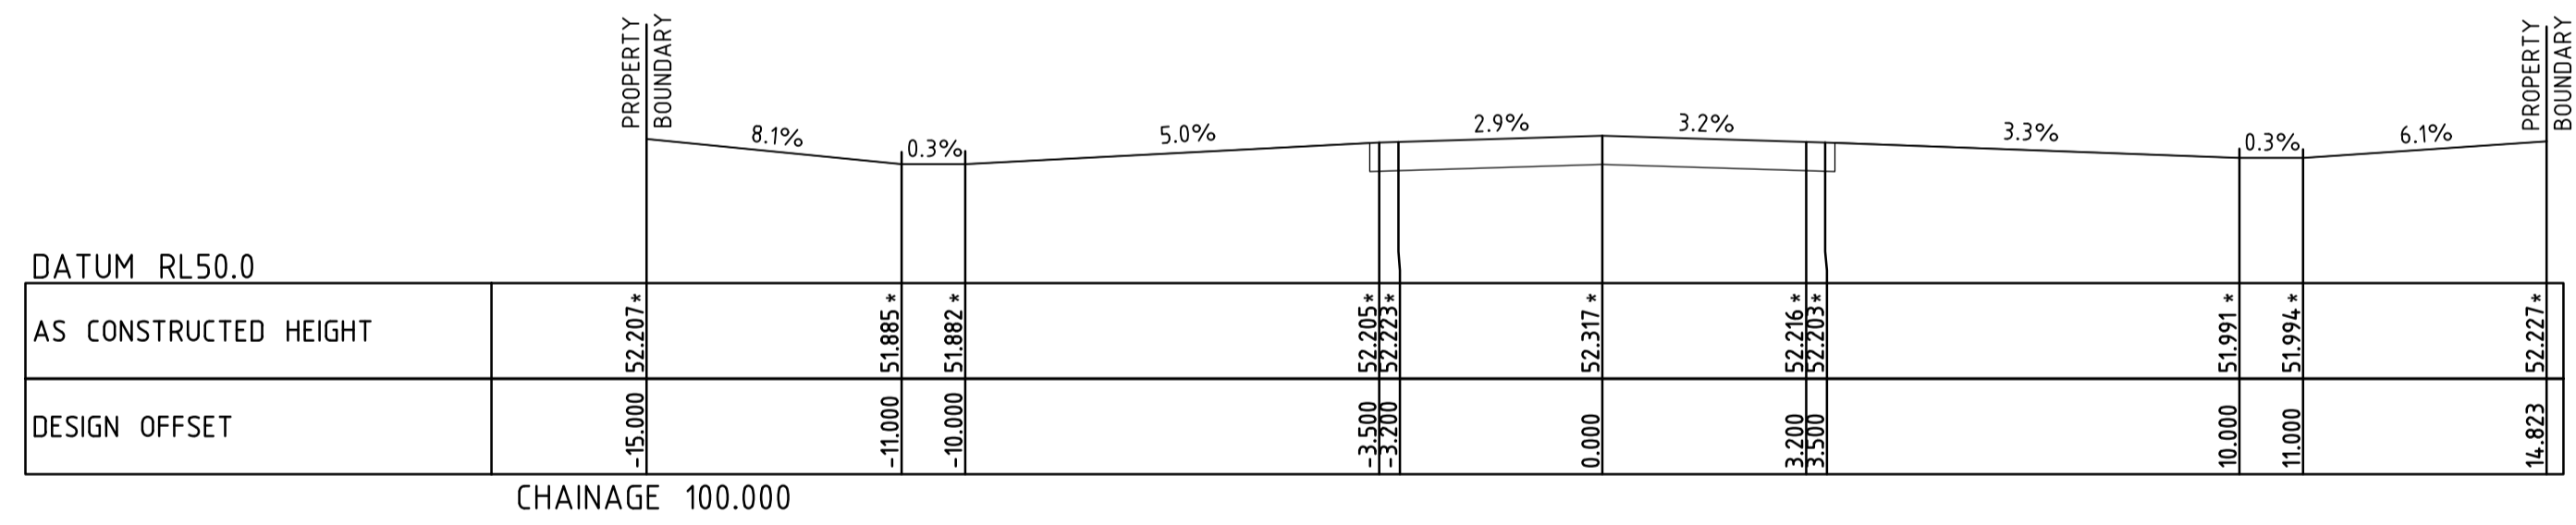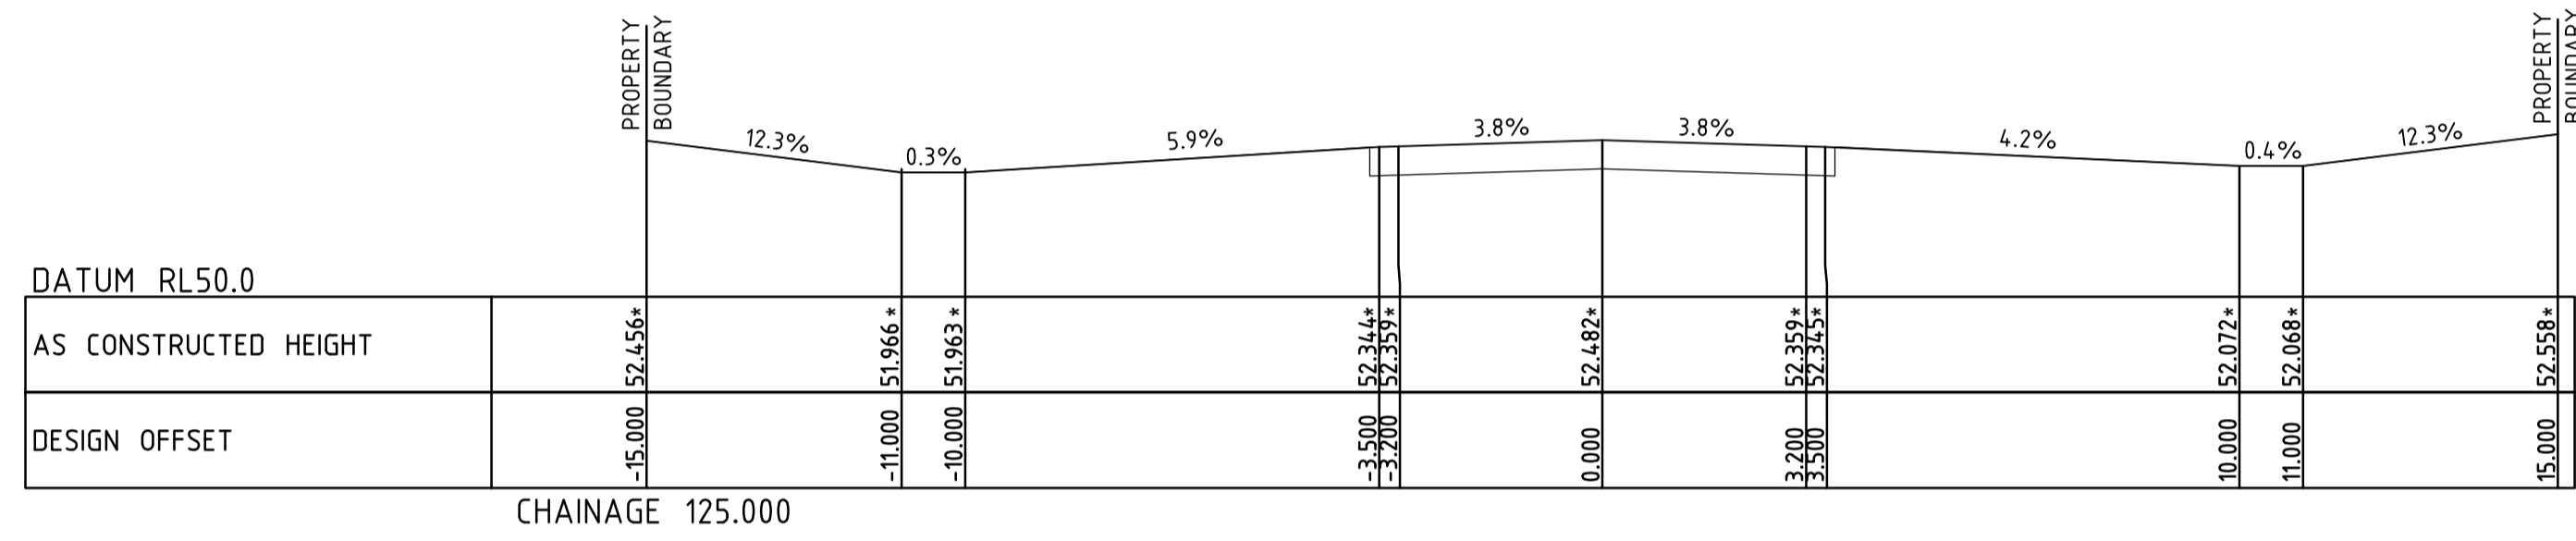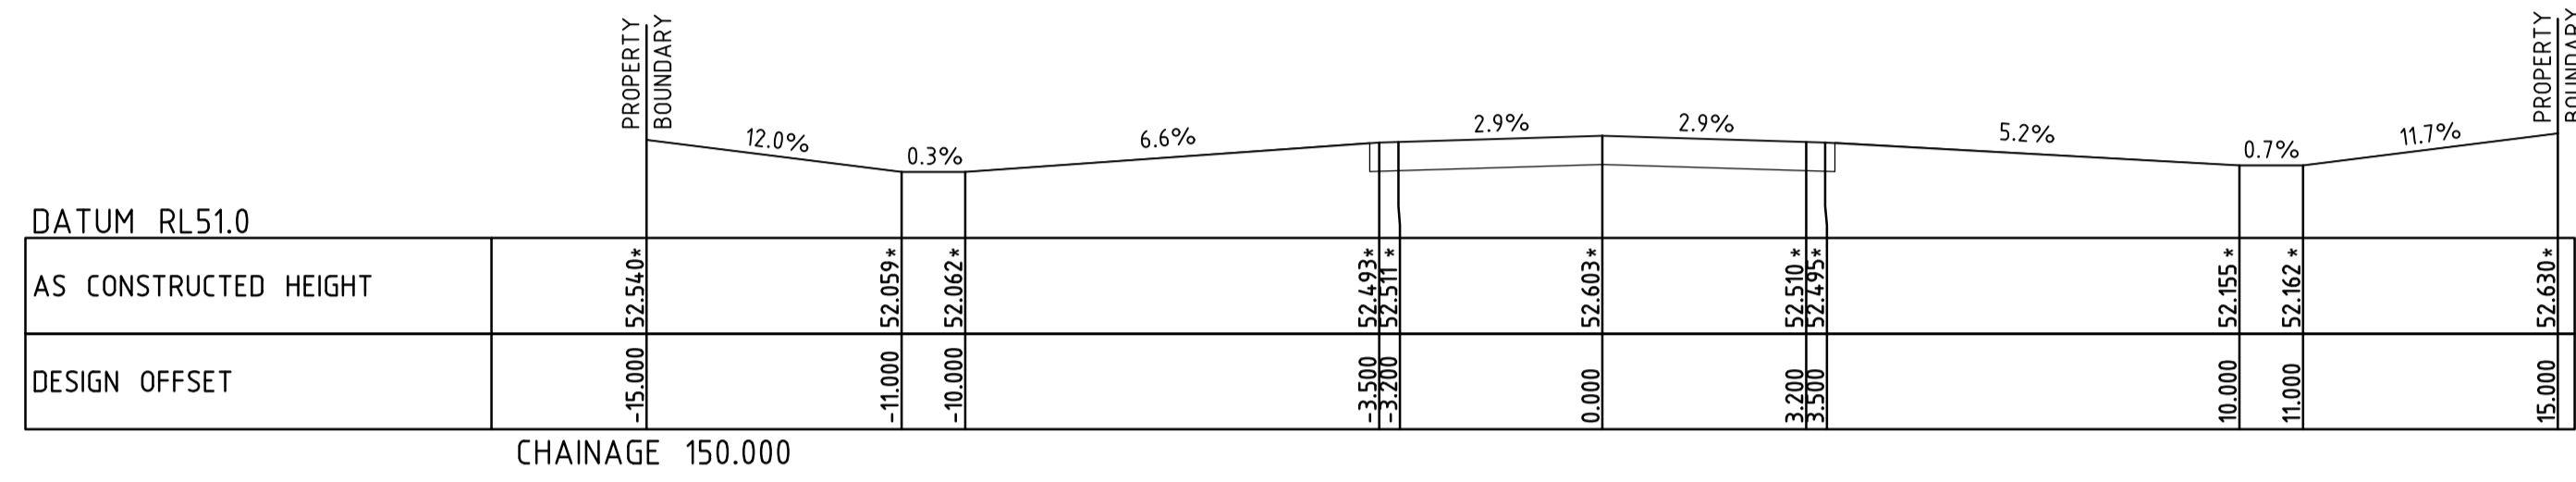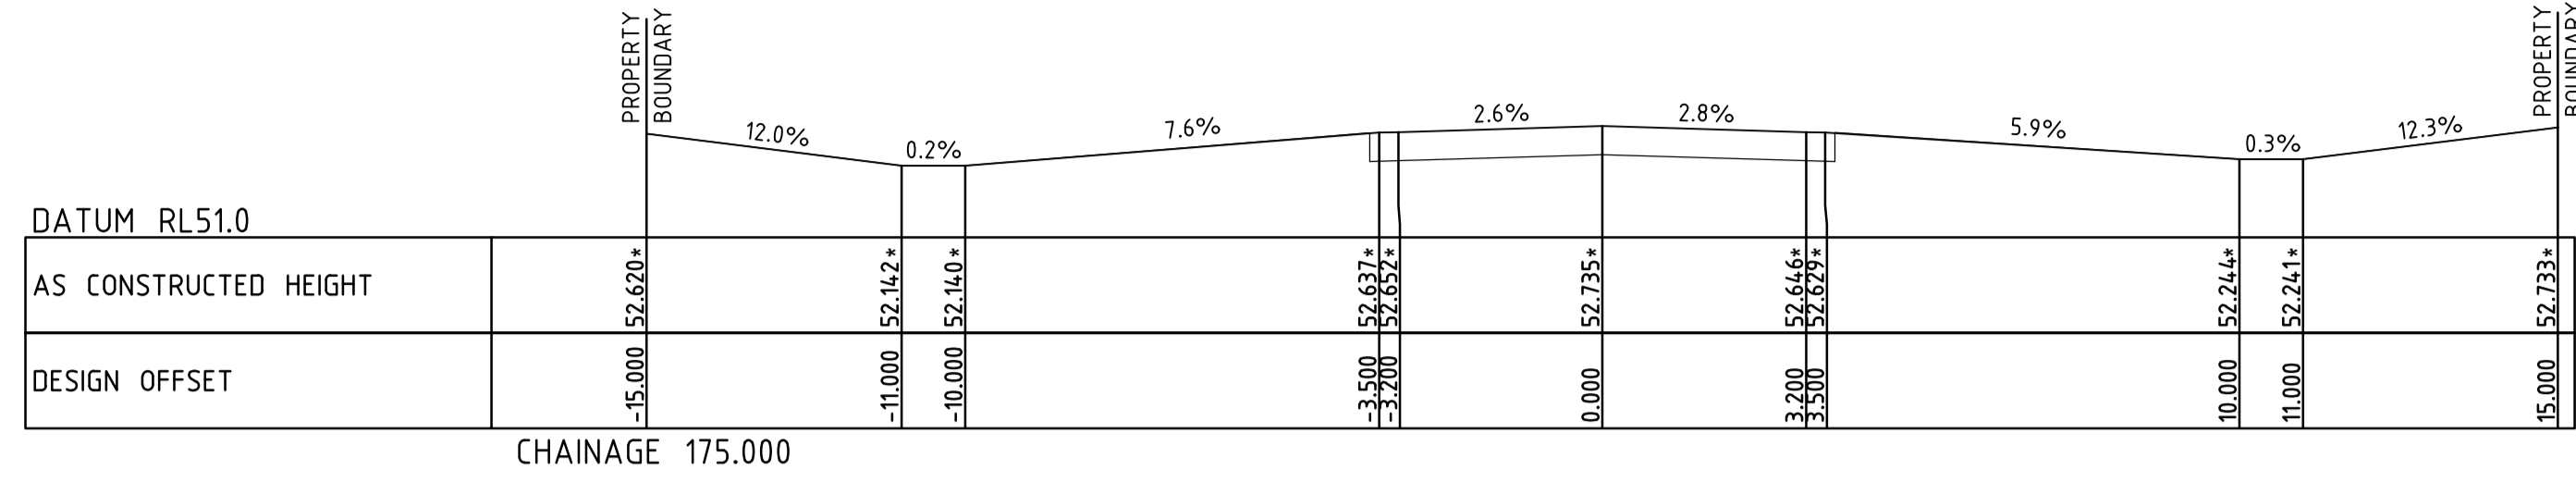

AS CONSTRUCTED





Rowlands Surveys Pty Ltd (ACN 010 025 260) hereby certify that the works detailed on this drawing, denoted *, have been constructed to the dimensions and levels shown

CARDNO (QLD) PTY LTD HEREBY CERTIFY THAT THE WORKS AS SHOWN ON THE AS CONSTRUCTED DRAWINGS REFLECT ANY CHANGES THAT WERE MADE DURING THE COURSE OF CONSTRUCTION.

Laurence John Nolan
Director / Registered Surveyor


Date: 9/11/2020

10801 RPEQ NO.
06/11/2020 DATE

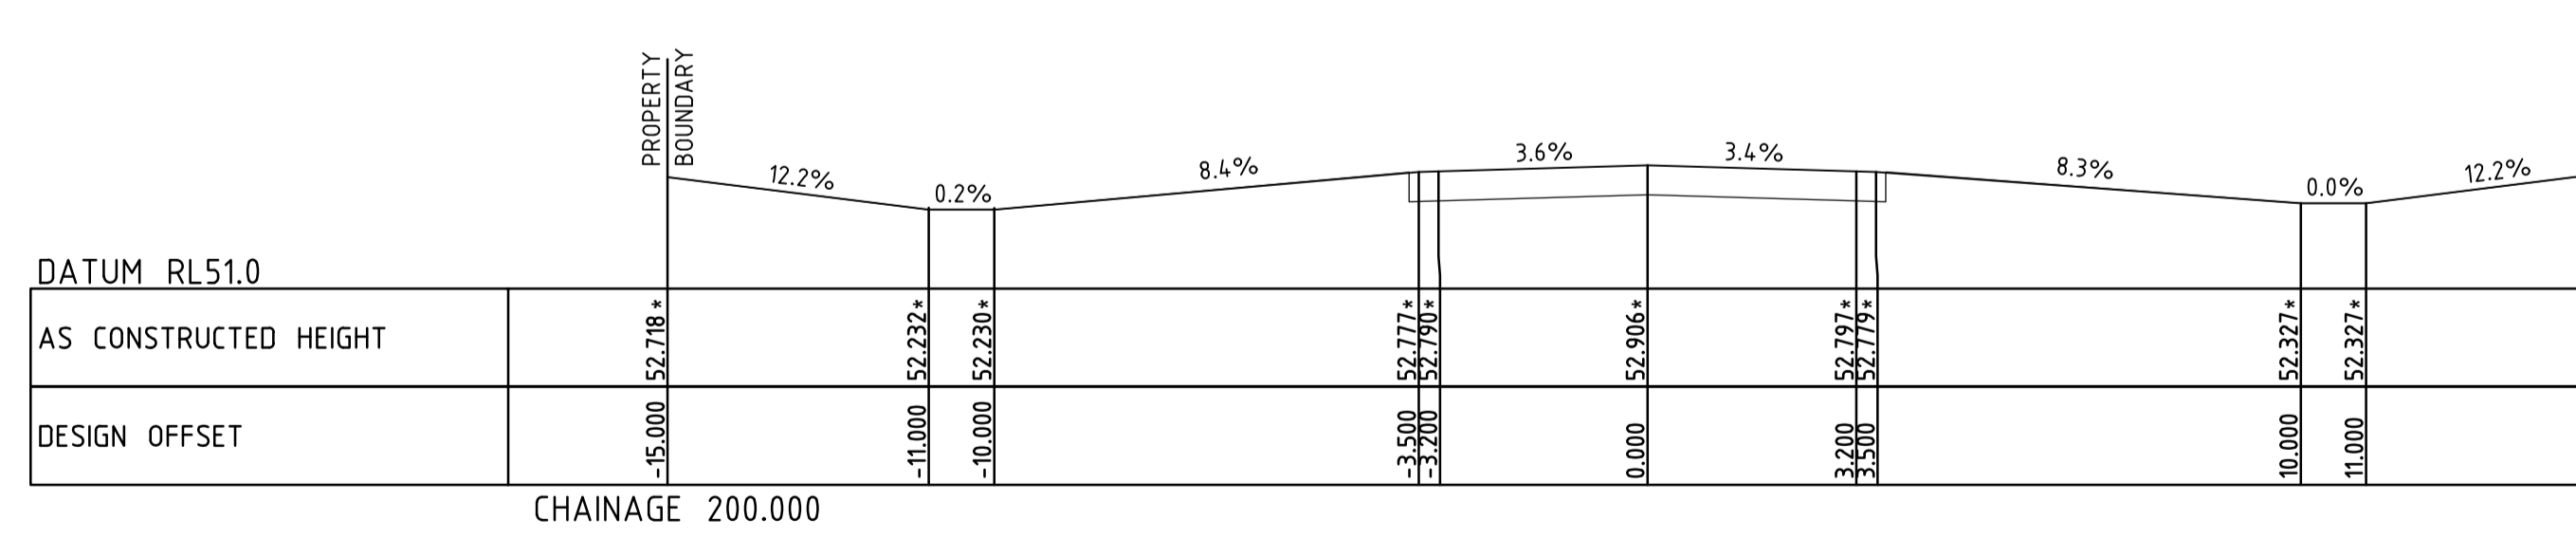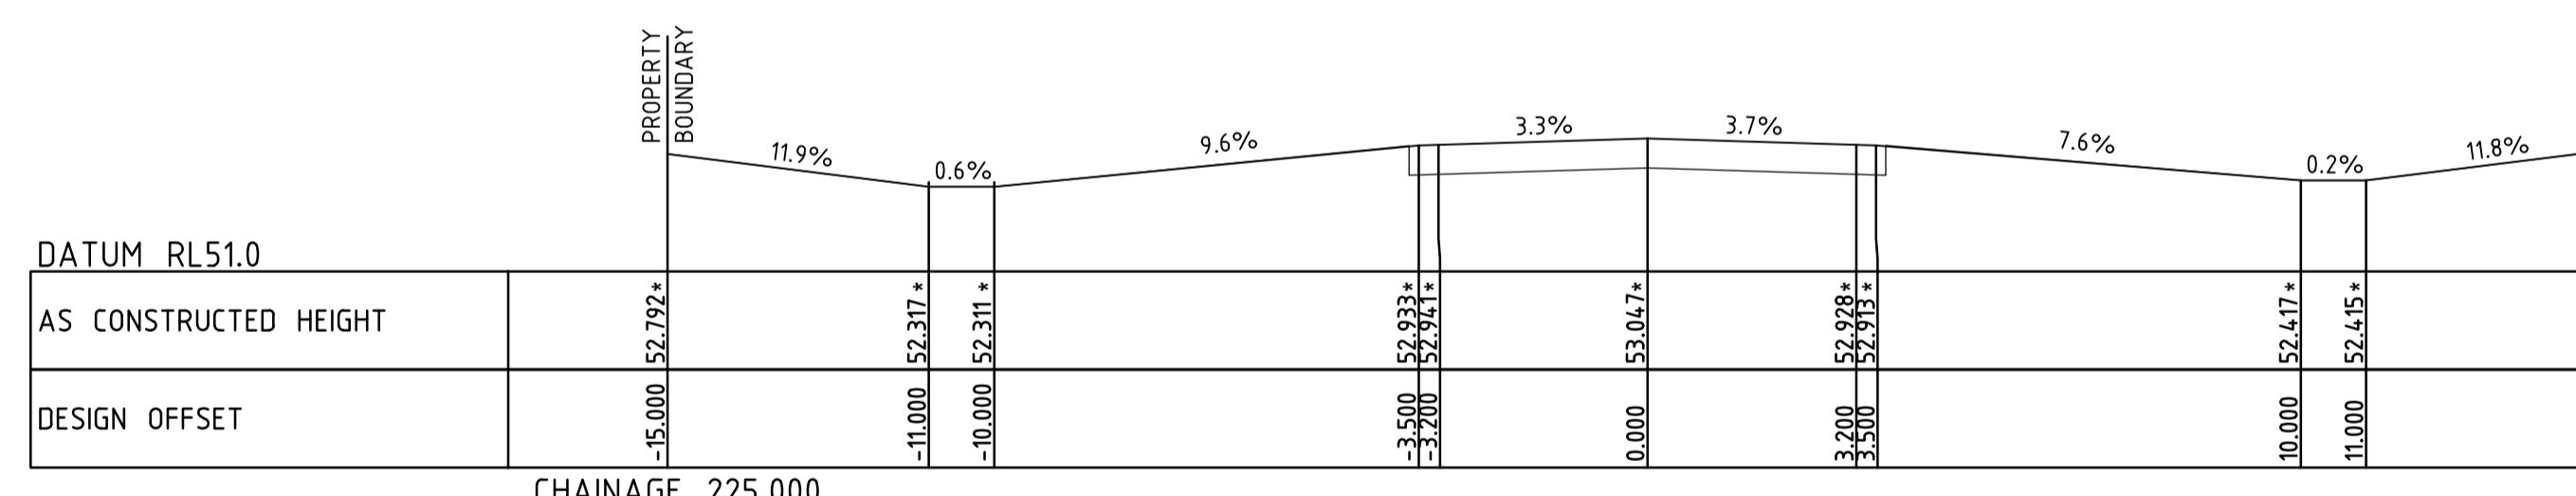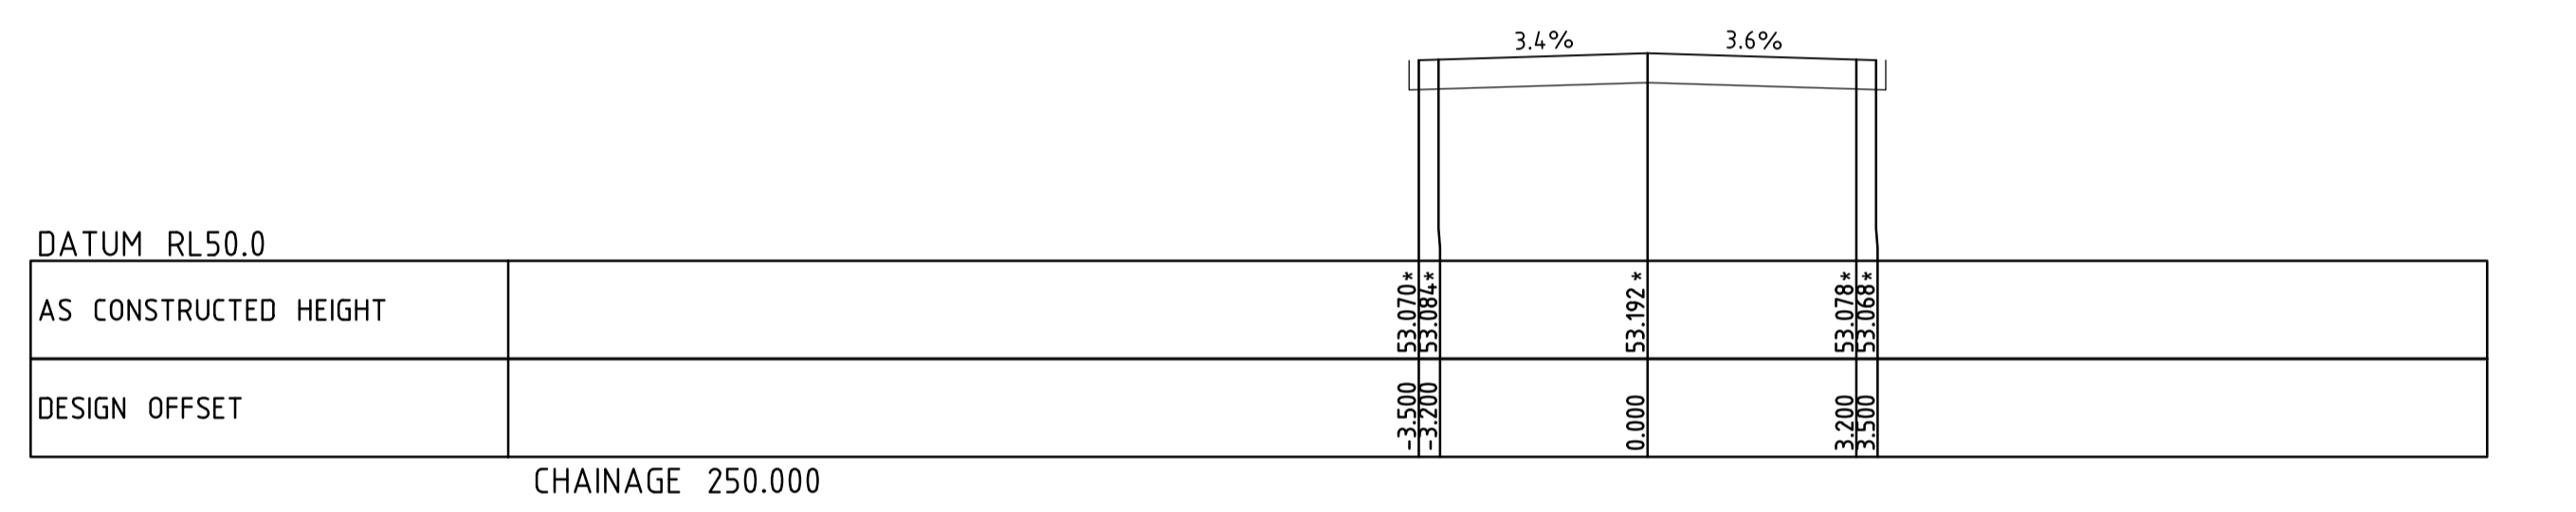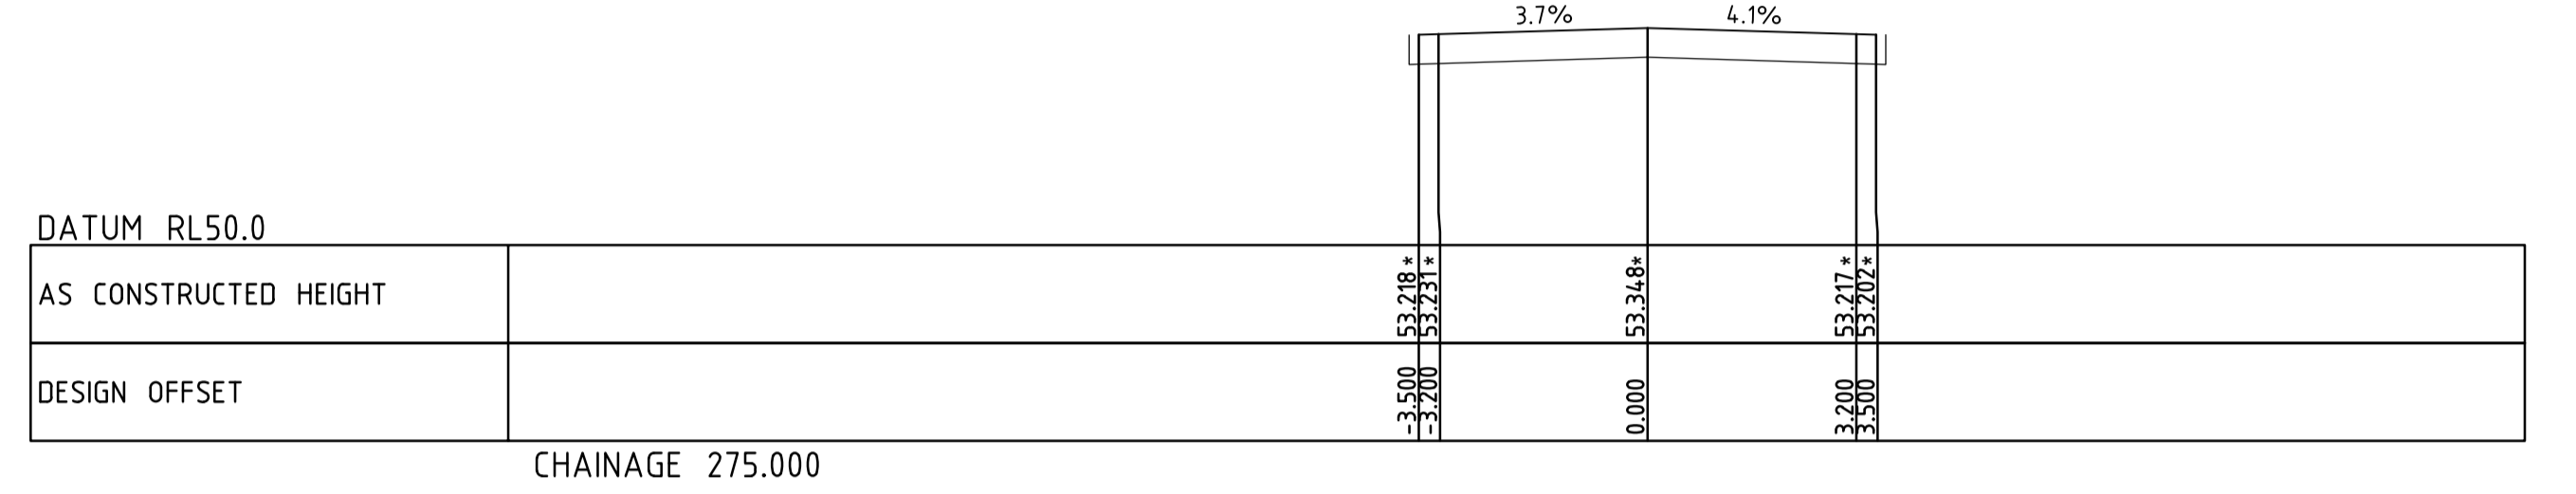

XREFs: XR-967192-ROADH-CS
CAD File: S:\PROJECTS\TOWNSVILLE OFFICE\9600\967192-CI-1604.dwg

Rev.	Date	Description	Des.	Verif.	Appd.
A	6/11/2020	AS-CONSTRUCTED ISSUE	LL	JW	MB

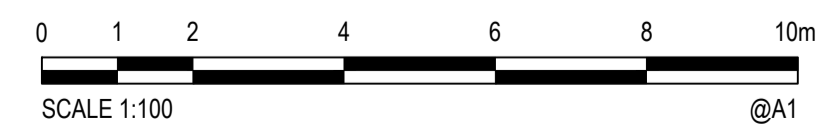

© Cardno Limited All Rights Reserved.
This document is produced by Cardno Limited solely for the benefit of and use by the client in accordance with the terms of the retainer. Cardno Limited does not and shall not assume any responsibility or liability whatsoever to any third party arising out of any use or reliance by third party on the content of this document.

Cardno (Qld) Pty Ltd | ABN 57 051 074 992
Level 1, 520 Flinders Street
Townsville, QLD 4810
Tel: 07 4772 1166 Fax: 07 4721 2508
Web: www.cardno.com.au

Drawn LL	Date 6/11/2020
Checked JW	Date 6/11/2020
Designed JN	Date 6/11/2020
Verified JW	Date 6/11/2020
Approved MB	Date 10/801

Client MOUNT MARGARET DEVELOPMENTS PTY LTD
Project MOUNT MARGARET, ALICE RIVER
STAGE 6B
AS-CONSTRUCTED
Title ROADWORKS CROSS SECTIONS
BANJO STREET - ROAD H
SHEET 1 OF 2

Status AS CONSTRUCTED			
Datum A.H.D	Date 6/11/2020	Scale As Shown	Size A1
Drawing Number 967192-CI-1604			Revision A

DATE PLOTTED: 6 November 2020 12:42 PM BY: LACHLAN LINDY

AS CONSTRUCTED




Rowlands Surveys Pty Ltd (ACN 010 025 260) hereby certify that the works detailed on this drawing, demoted *, have been constructed to the dimensions and levels shown

Laurence John Nolan
Director / Registered Surveyor

Date: 9/11/2020


CARDNO (QLD) PTY LTD HEREBY CERTIFY THAT THE WORKS AS SHOWN ON THE AS CONSTRUCTED DRAWINGS REFLECT ANY CHANGES THAT WERE MADE DURING THE COURSE OF CONSTRUCTION.

[Signature] RPEQ
10801 RPEQ NO.
06/11/2020 DATE

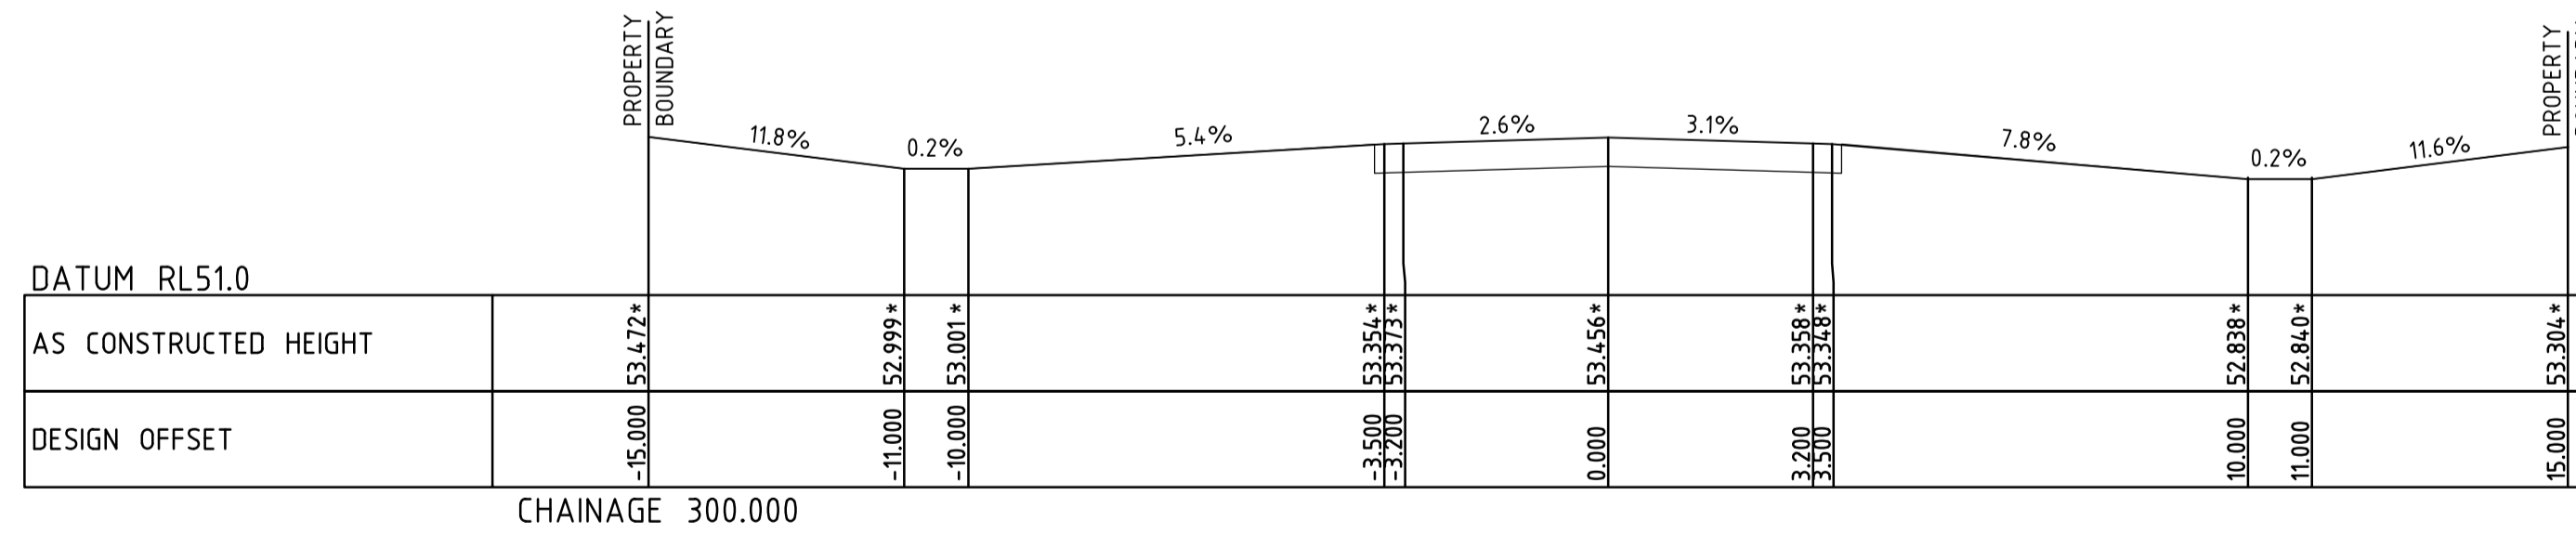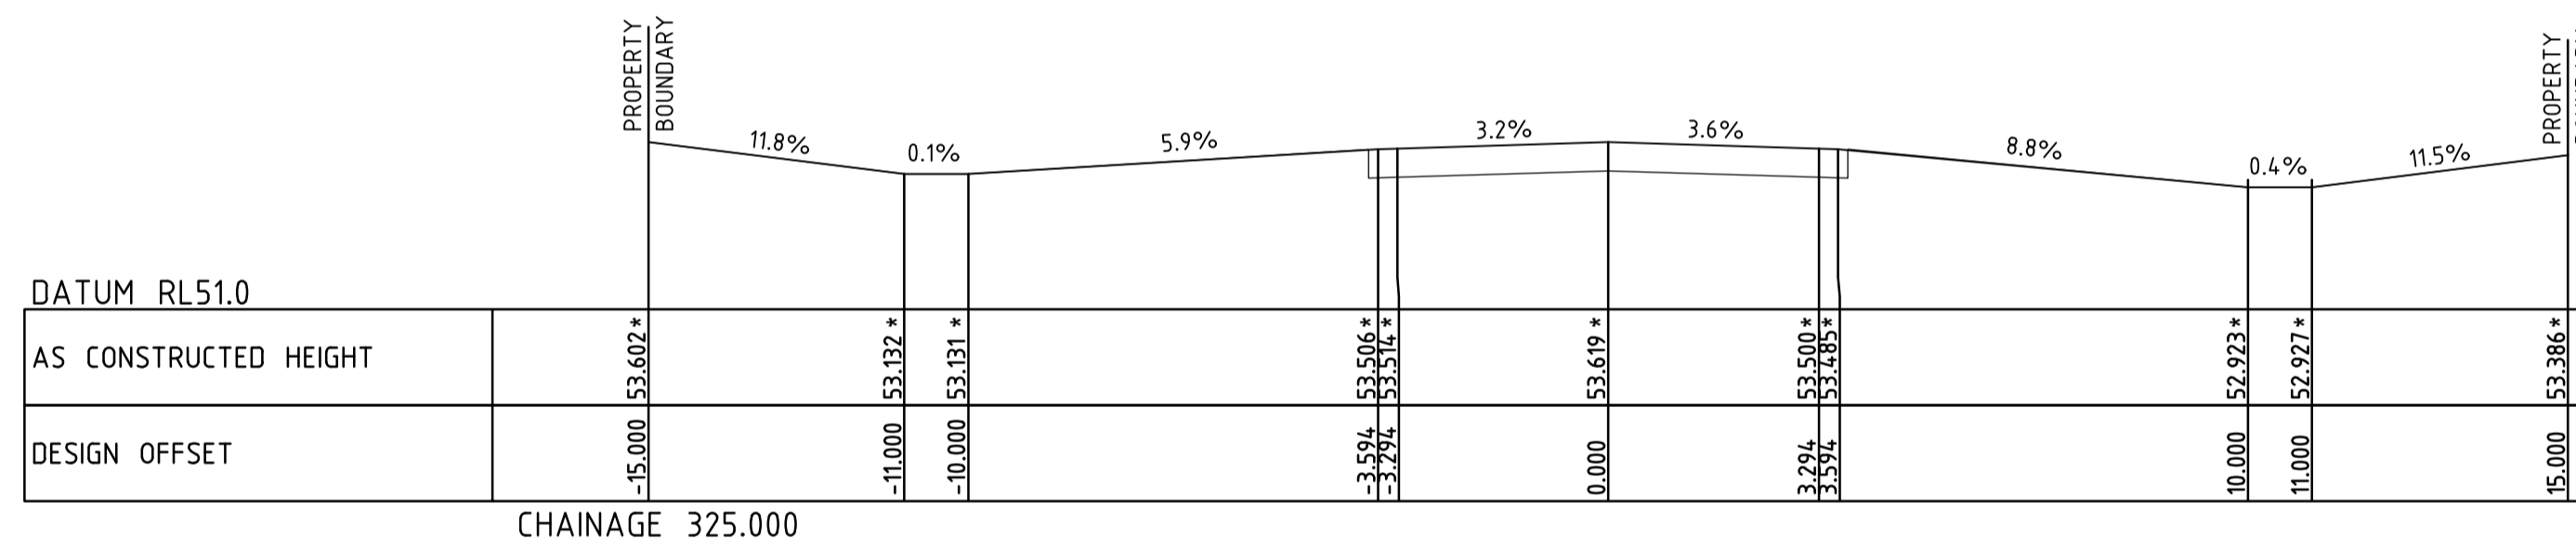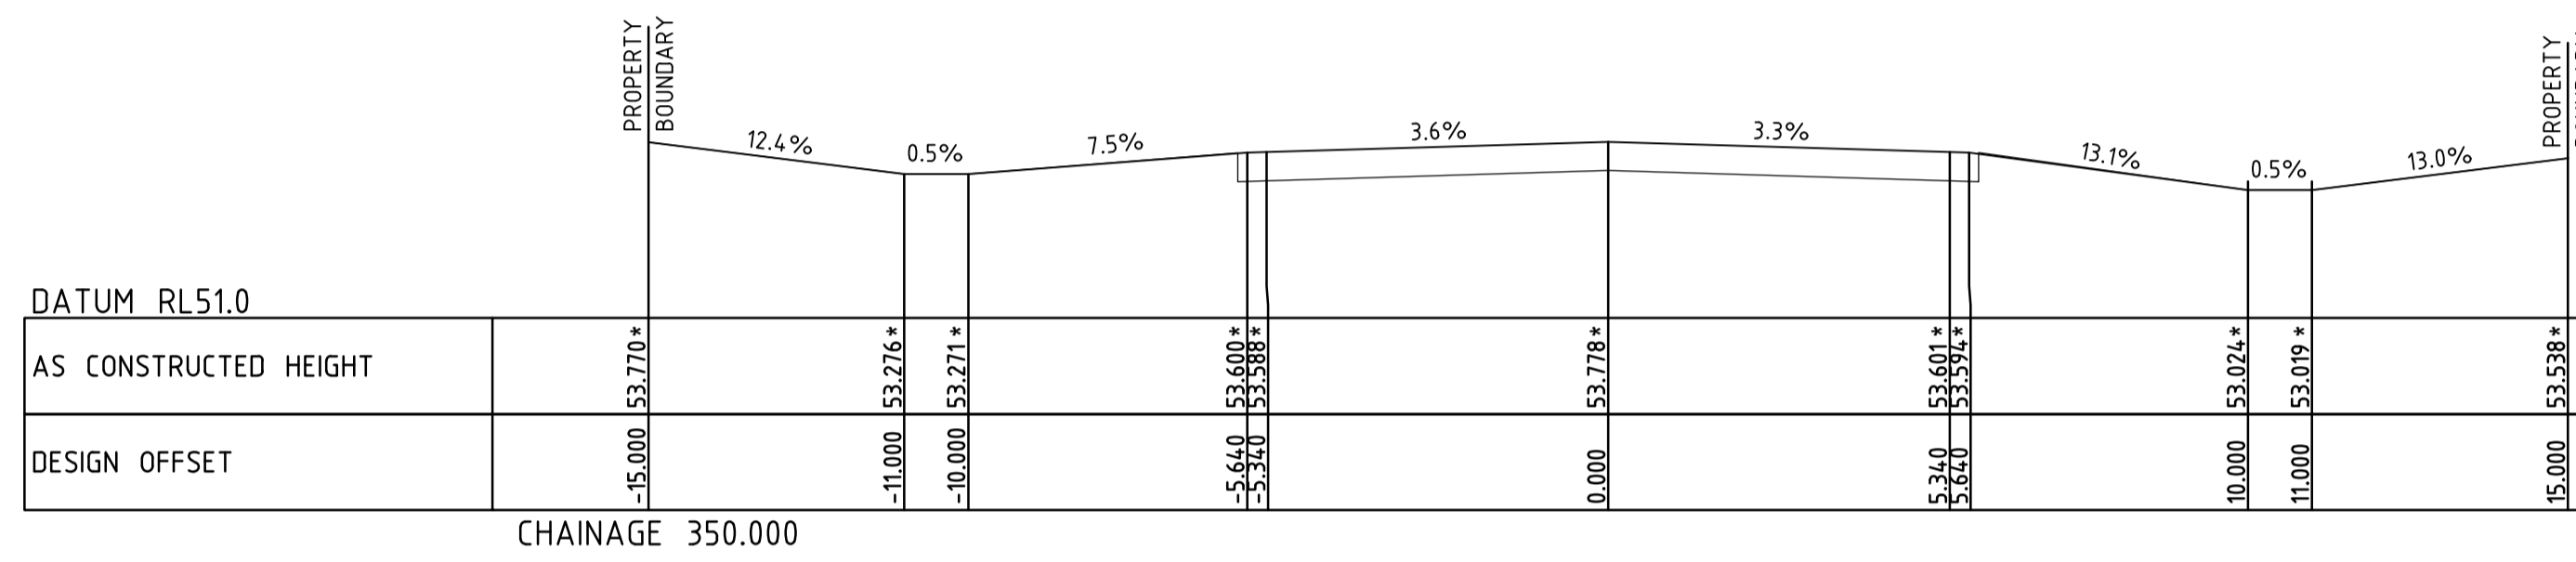

XREF: SR-967192-ROADH-CS
CAD File: S:\PROJECTS\TOWNSVILLE OFFICE\96600\96719671-92 - Mount Margaret\ENGINEERING\AS CONSTRUCTED\STAGE 6\STAGE 6B\967192-CI-1605.dwg

Rev.	Date	Description	Des.	Verif.	Appd.
A	6/11/2020	AS-CONSTRUCTED ISSUE	LL	JW	MB

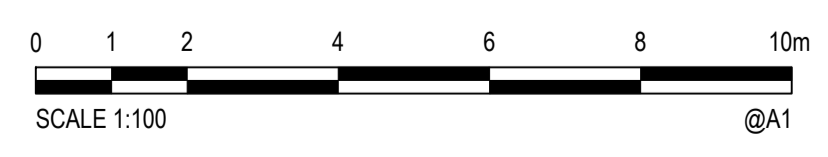

© Cardno Limited All Rights Reserved.
This document is produced by Cardno Limited solely for the benefit of and use by the client in accordance with the terms of the retainer. Cardno Limited does not and shall not assume any responsibility or liability whatsoever to any third party arising out of any use or reliance by third party on the content of this document.

Cardno (Qld) Pty Ltd | ABN 57 051 074 992
Level 1, 520 Flinders Street
Townsville, QLD 4810
Tel: 07 4772 1166 Fax: 07 4721 2508
Web: www.cardno.com.au

Drawn	LL	Date	6/11/2020
Checked	JW	Date	6/11/2020
Designed	JN	Date	6/11/2020
Verified	JW	Date	6/11/2020
Approved	<i>[Signature]</i>	Date	10801
MB		DATE:	6/11/2020

Client	MOUNT MARGARET DEVELOPMENTS PTY LTD
Project	MOUNT MARGARET, ALICE RIVER
Stage	STAGE 6B
Title	AS-CONSTRUCTED
Title	ROADWORKS CROSS SECTIONS
Title	BANJO STREET - ROAD H
Title	SHEET 2 OF 2

Status	AS CONSTRUCTED						
Datum	A.H.D	Date	6/11/2020	Scale	As Shown	Size	A1
Drawing Number	967192-CI-1605			Revision	A		


DATE PLOTTED: 6 November 2020 1:46 PM BY: LACHLAN LINDY

CRYSTAL CRESCENT (ROAD F)
 ROAD TYPE: ACCESS SHEET
 DESIGN SPEED: 50km/h (NOT INCLUDING INTERSECTION)


PAVEMENT DESIGN
 TWO COAT BITUMEN SEAL (14mm/7mm)
 • PRIME COAT - AMC00 @ 0.8 L/m²
 • SEAL COAT 1 - CL170 @ 1.5L/m²
 • 14mm AGG. @ 95m²/m³
 • SEAL COAT 2 - CL170 @ 1.1L/m²
 • 7mm AGG. @ 120m²/m³
 150mm BASE (DTMR TYPE 2.1)
 190mm SUB BASE (DTMR TYPE 2.3)

AS CONSTRUCTED
 Rowlands Surveys Pty Ltd (ACN 010 025 260) hereby certify that the works detailed on this drawing, denoted *, have been constructed to the dimensions and levels shown.
 Date: 9/11/2020
 Laurence John Nolan
 Director / Registered Surveyor

CARDNO (QLD) PTY LTD HEREBY CERTIFY THAT THE WORKS AS SHOWN ON THE AS CONSTRUCTED DRAWINGS REFLECT ANY CHANGES THAT WERE MADE DURING THE COURSE OF CONSTRUCTION.
 [Signature] RPEQ
 10801 RPEQ NO.
 06/11/2020 DATE

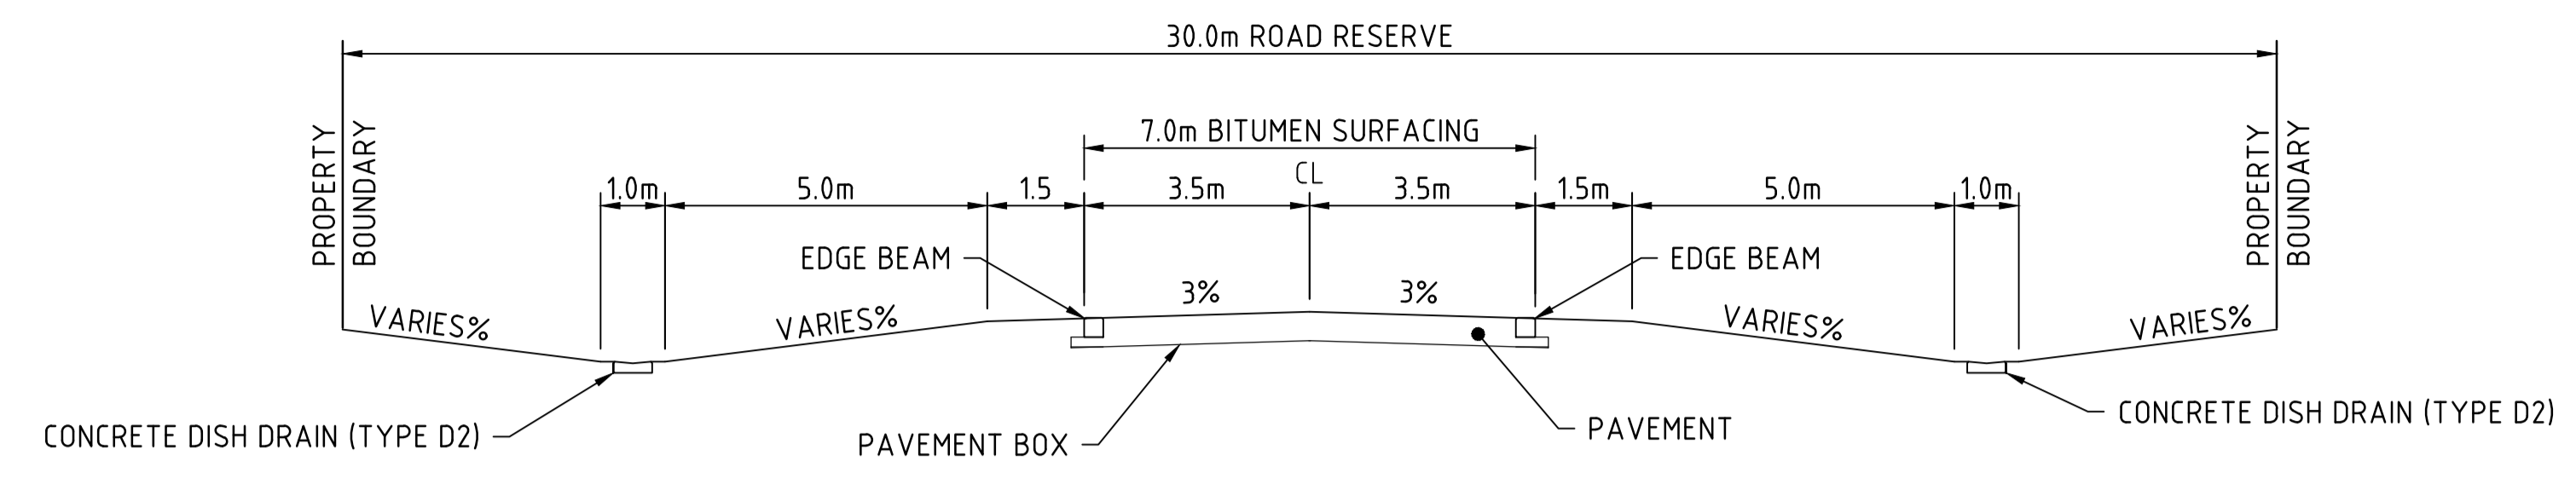

TYPICAL CROSS SECTION
 SCALE 1:100 @ A1

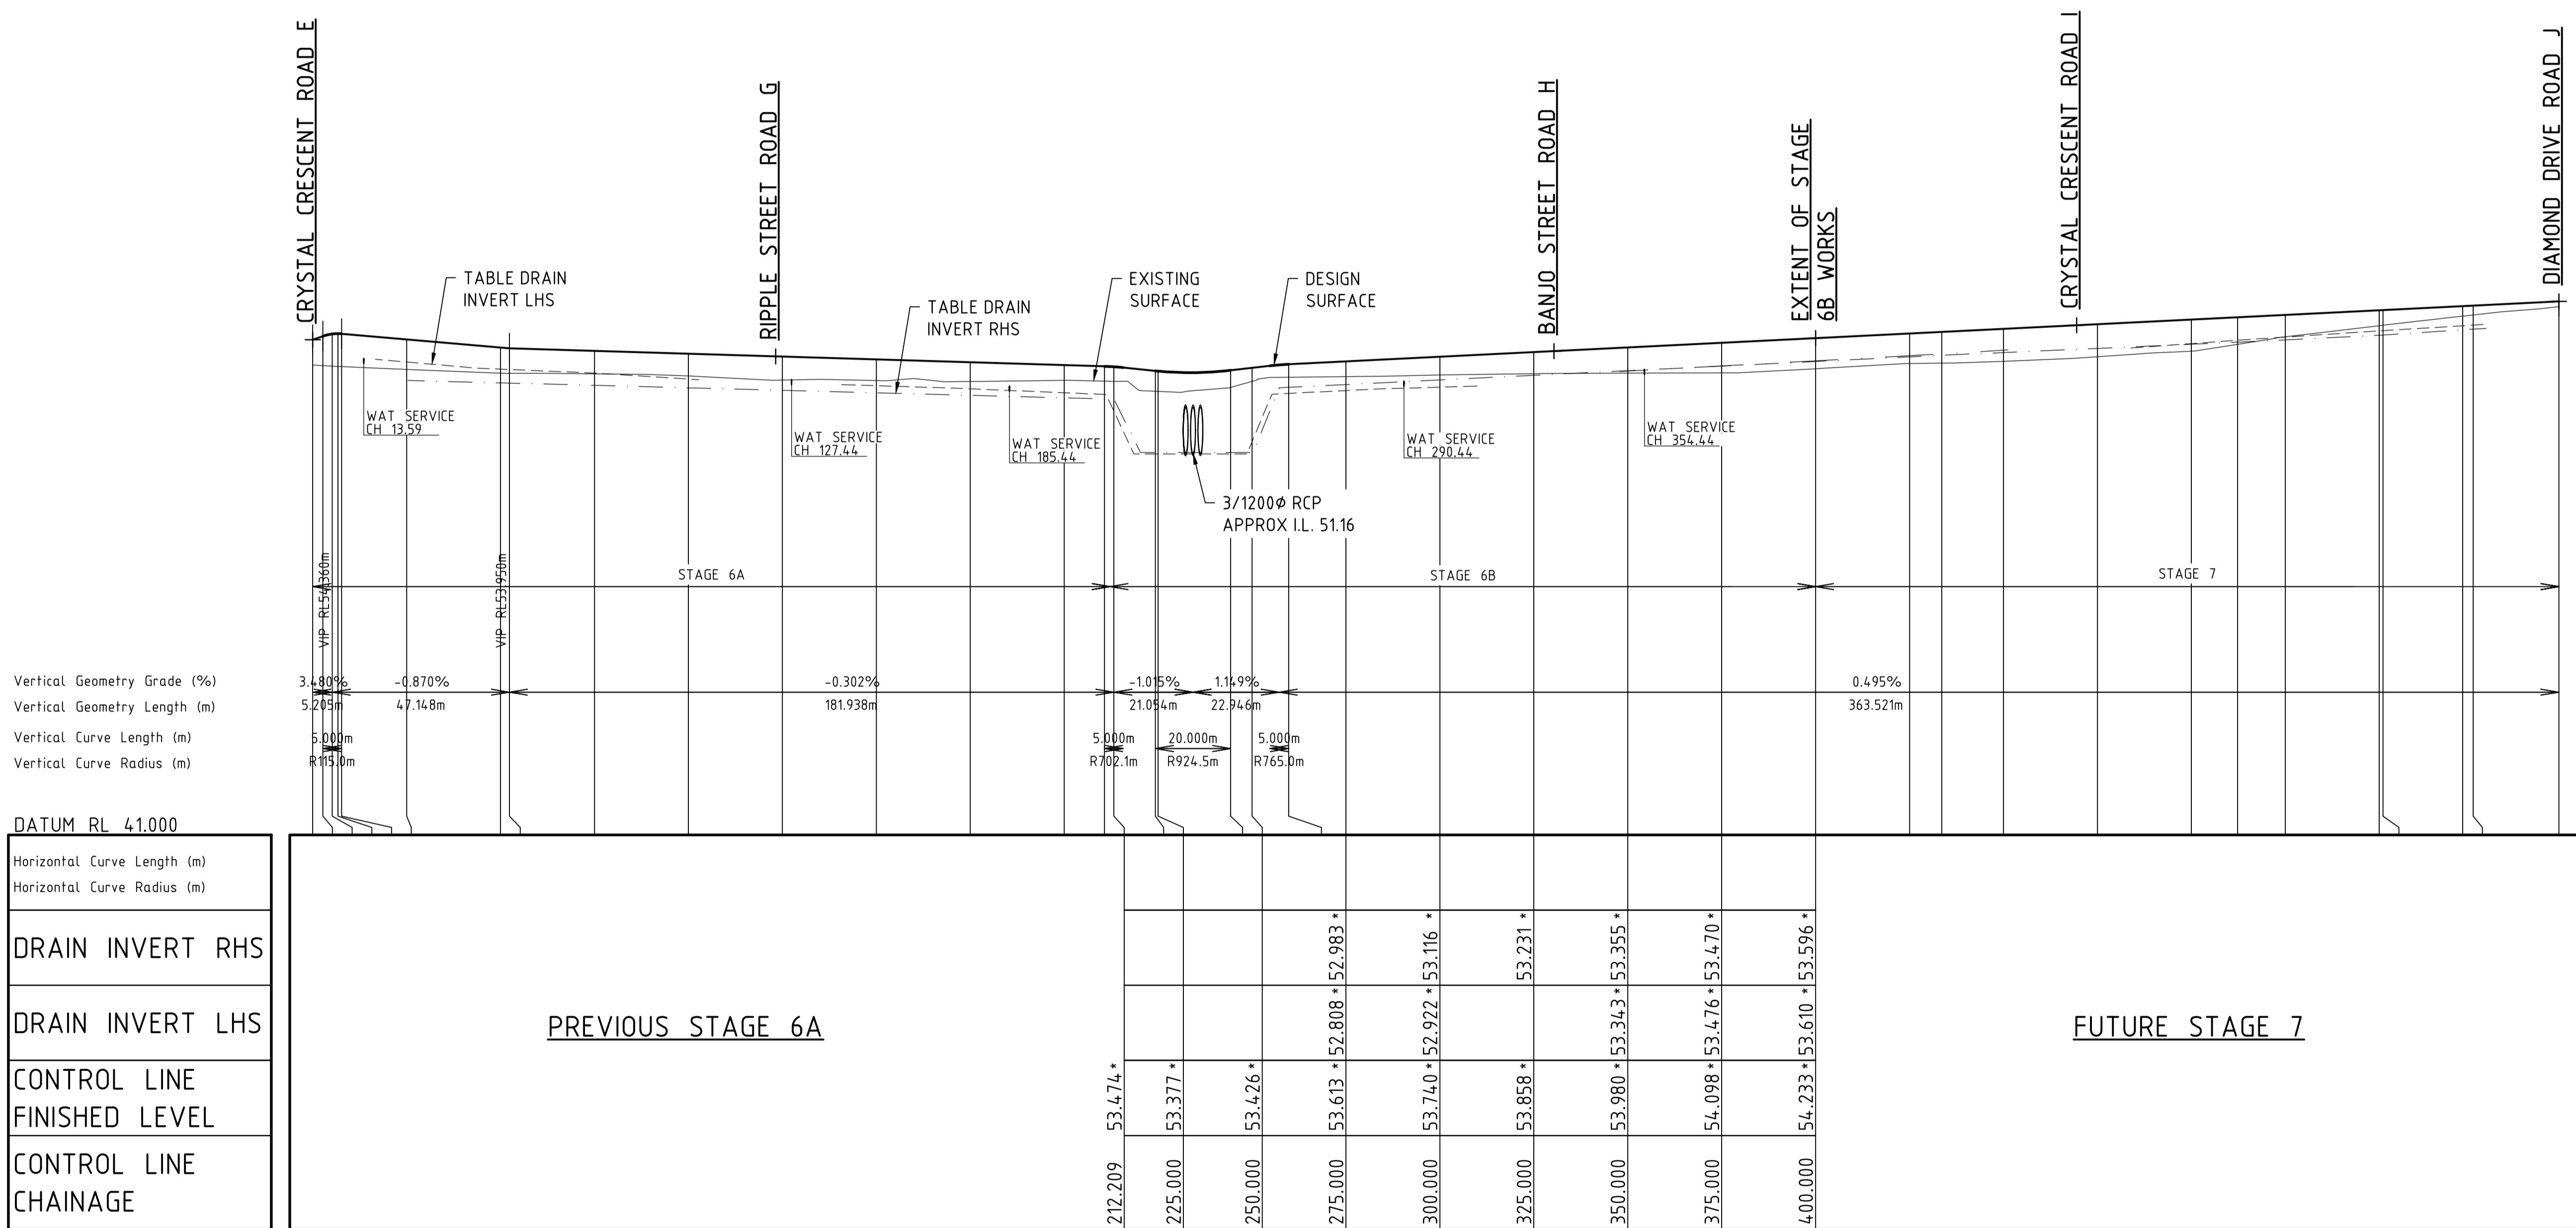


CRYSTAL CRESCENT ROAD F - LONGITUDINAL SECTION
 SCALE HORIZONTAL 1: 1000 @ A1
 VERTICAL 1: 100 @ A1

DATUM RL 41.000
Horizontal Curve Length (m)
Horizontal Curve Radius (m)
DRAIN INVERT RHS
DRAIN INVERT LHS
CONTROL LINE FINISHED LEVEL
CONTROL LINE CHAINAGE

XREF: S:\PROJECTS\TOWNSVILLE OFFICE\96019671\9671-92 - Mount Margaret\ENGINEERING\AS CONSTRUCTED\STAGE 6\STAGE 6B\967192-CI-1606.dwg

Rev.	Date	Description	Des.	Verif.	Appd.
A	6/11/2020	AS-CONSTRUCTED ISSUE	LL	JW	MB

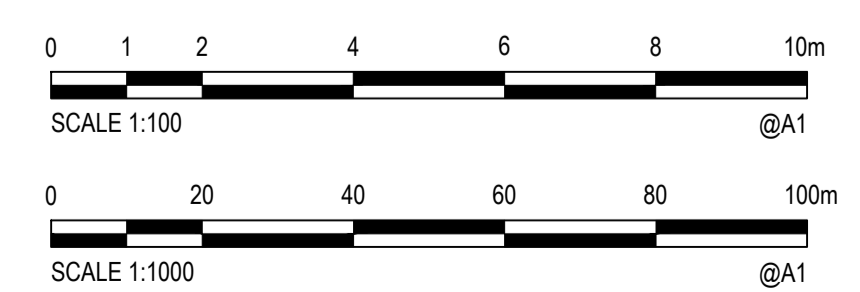

© Cardno Limited All Rights Reserved.
 This document is produced by Cardno Limited solely for the benefit of and use by the client in accordance with the terms of the retainer. Cardno Limited does not and shall not assume any responsibility or liability whatsoever to any third party arising out of any use or reliance by any third party on the content of this document.

Drawn LL	Date 6/11/2020
Checked JW	Date 6/11/2020
Designed JN	Date 6/11/2020
Verified JW	Date 6/11/2020
Approved [Signature]	Date 6/11/2020

Client	MOUNT MARGARET DEVELOPMENTS PTY LTD
Project	MOUNT MARGARET, ALICE RIVER
Stage	STAGE 6B
Title	ROADWORKS LONGITUDINAL SECTION
	CRYSTAL CRESCENT - ROAD F

Status	AS CONSTRUCTED			
Datum	Date	Scale	Size	
A.H.D	6/11/2020	As Shown	A1	
Drawing Number	967192-CI-1606			Revision
				A

DATE PLOTTED: 6 November 2020 12:43 PM BY: LACHLAN LANDY

AS CONSTRUCTED










Rowlands Surveys Pty Ltd (ACN 010 025 260) hereby certify that the works detailed on this drawing, denoted *, have been constructed to the dimensions and levels shown

Laurence John Nolan
Director / Registered Surveyor

Date: 9/11/2020

CARDNO (QLD) PTY LTD HEREBY CERTIFY THAT THE WORKS AS SHOWN ON THE AS CONSTRUCTED DRAWINGS REFLECT ANY CHANGES THAT WERE MADE DURING THE COURSE OF CONSTRUCTION.

[Signature]
RPEQ
10801 RPEQ NO.
06/11/2020 DATE

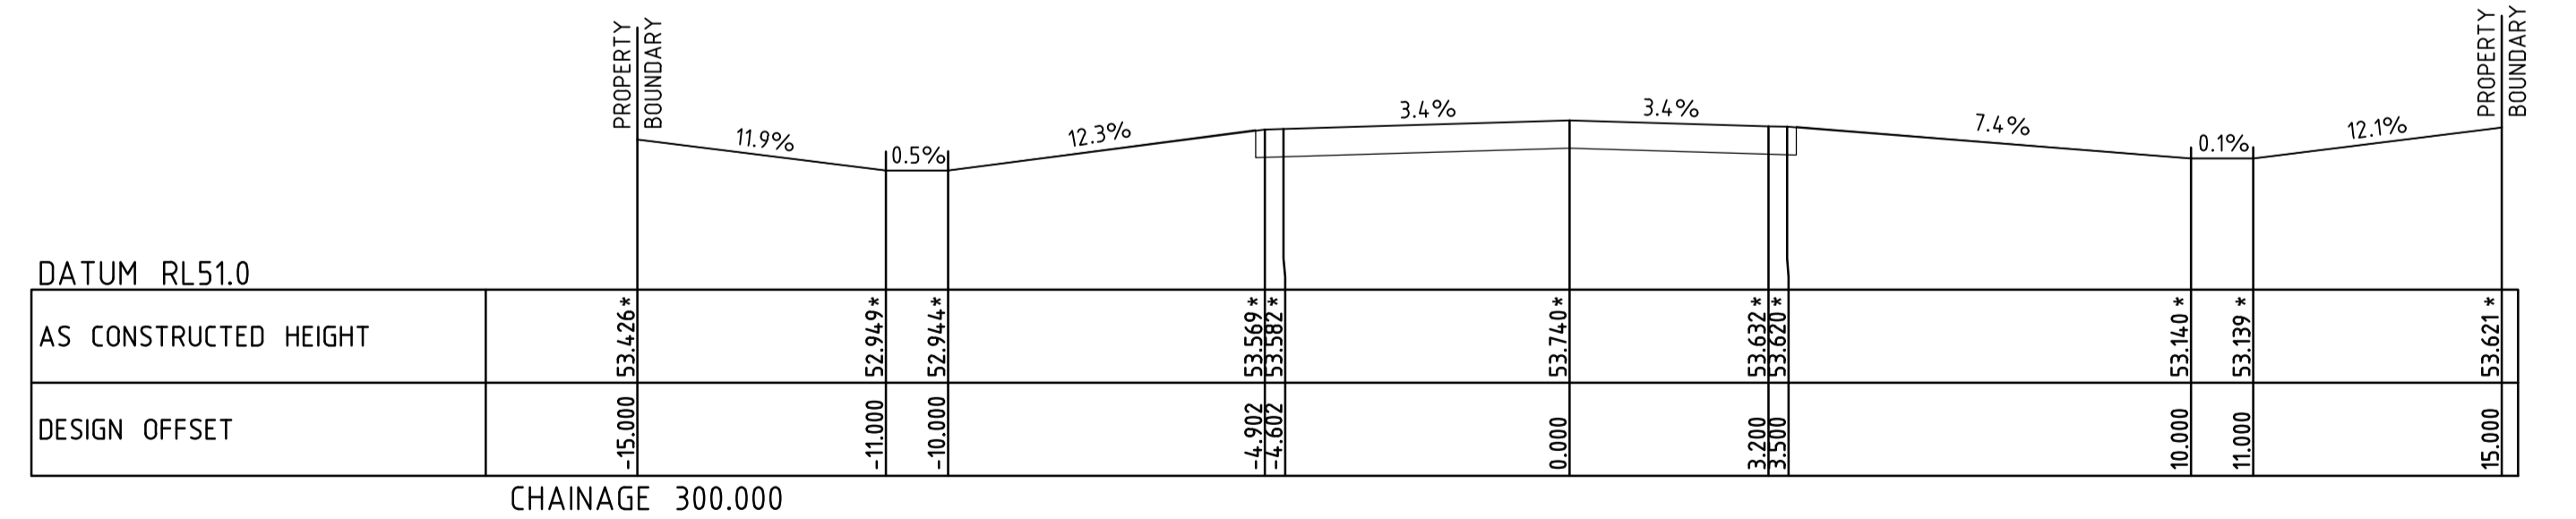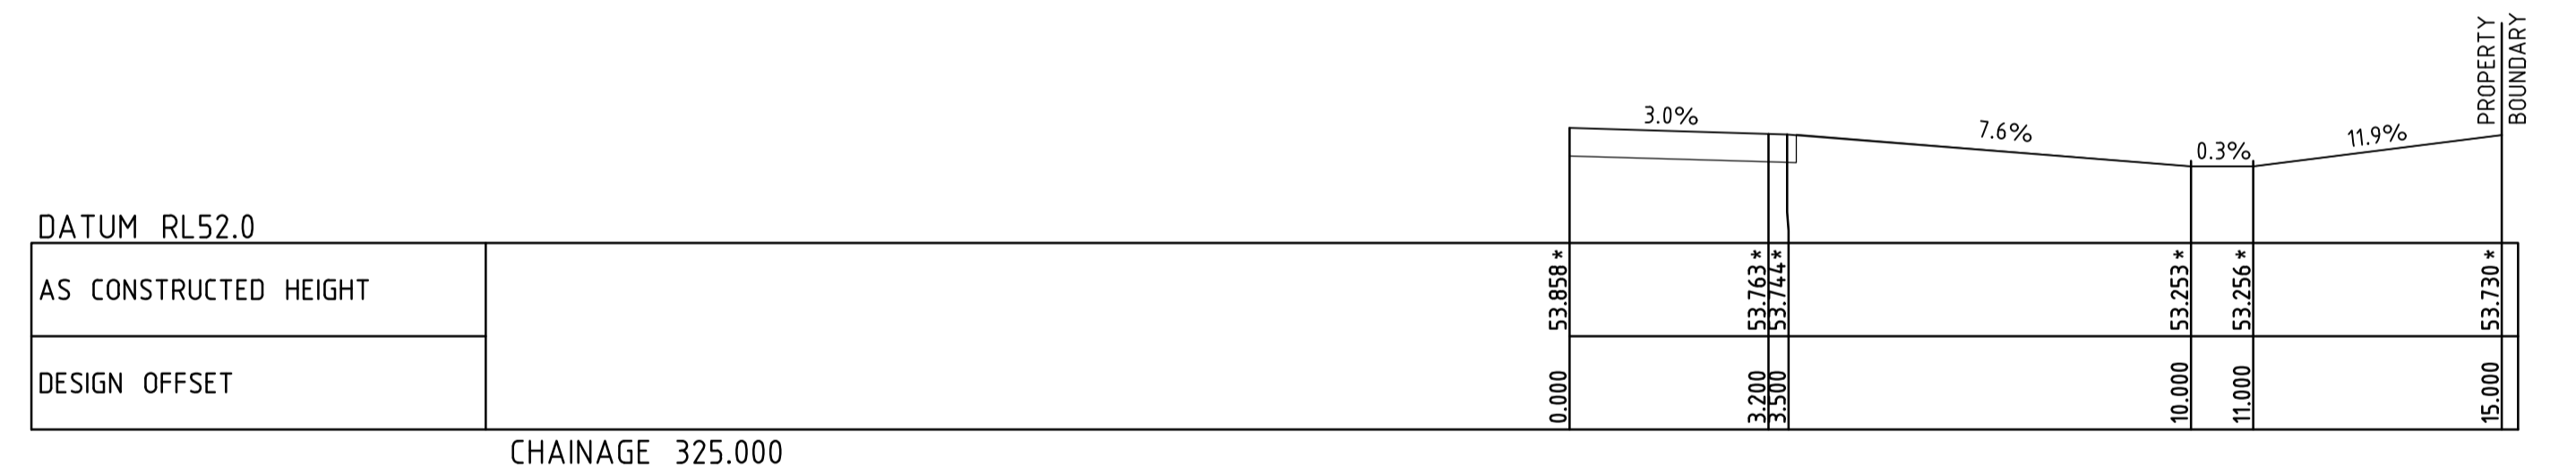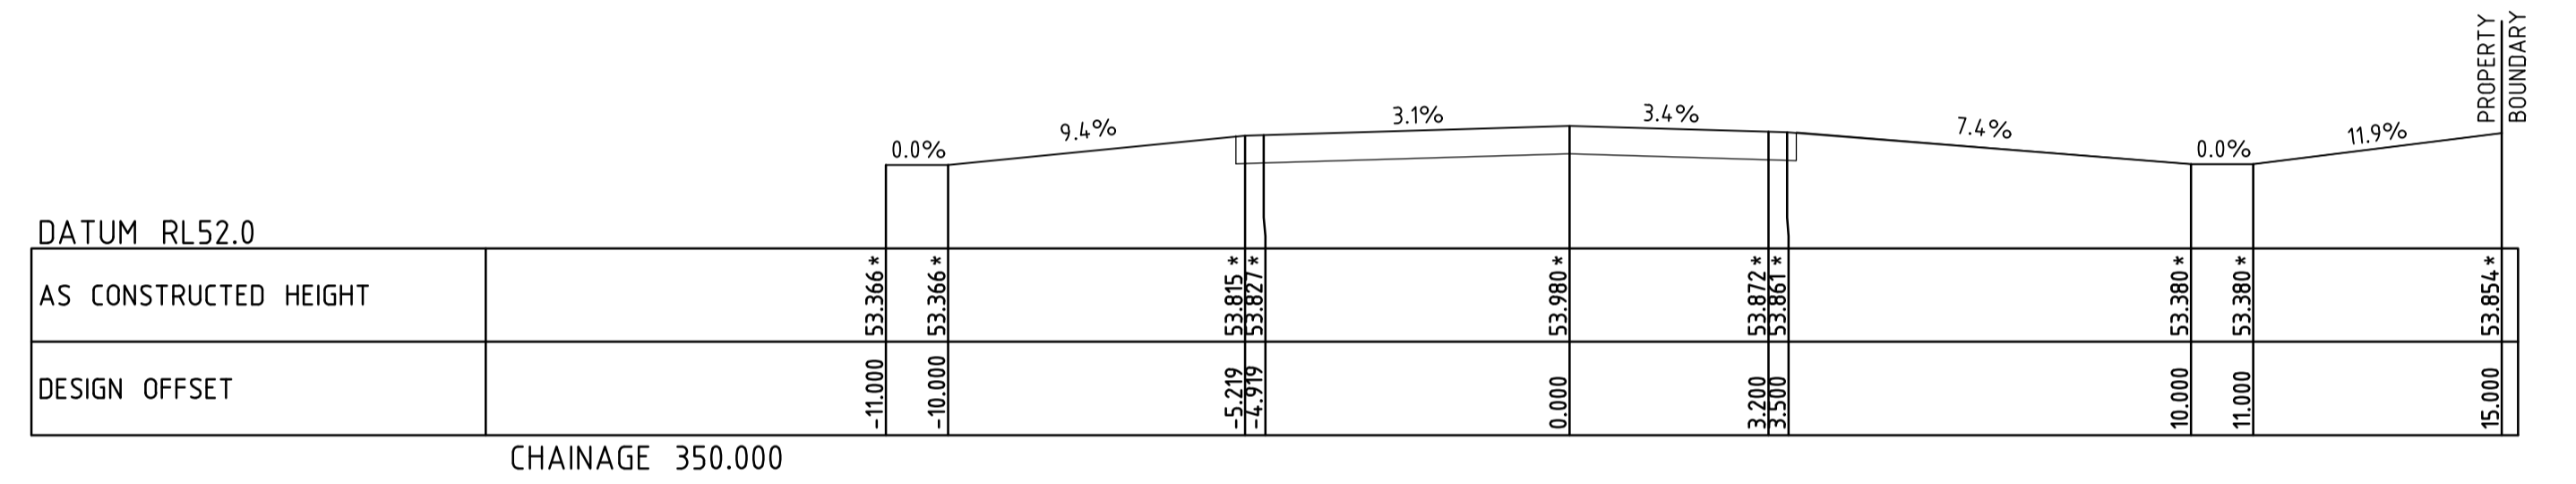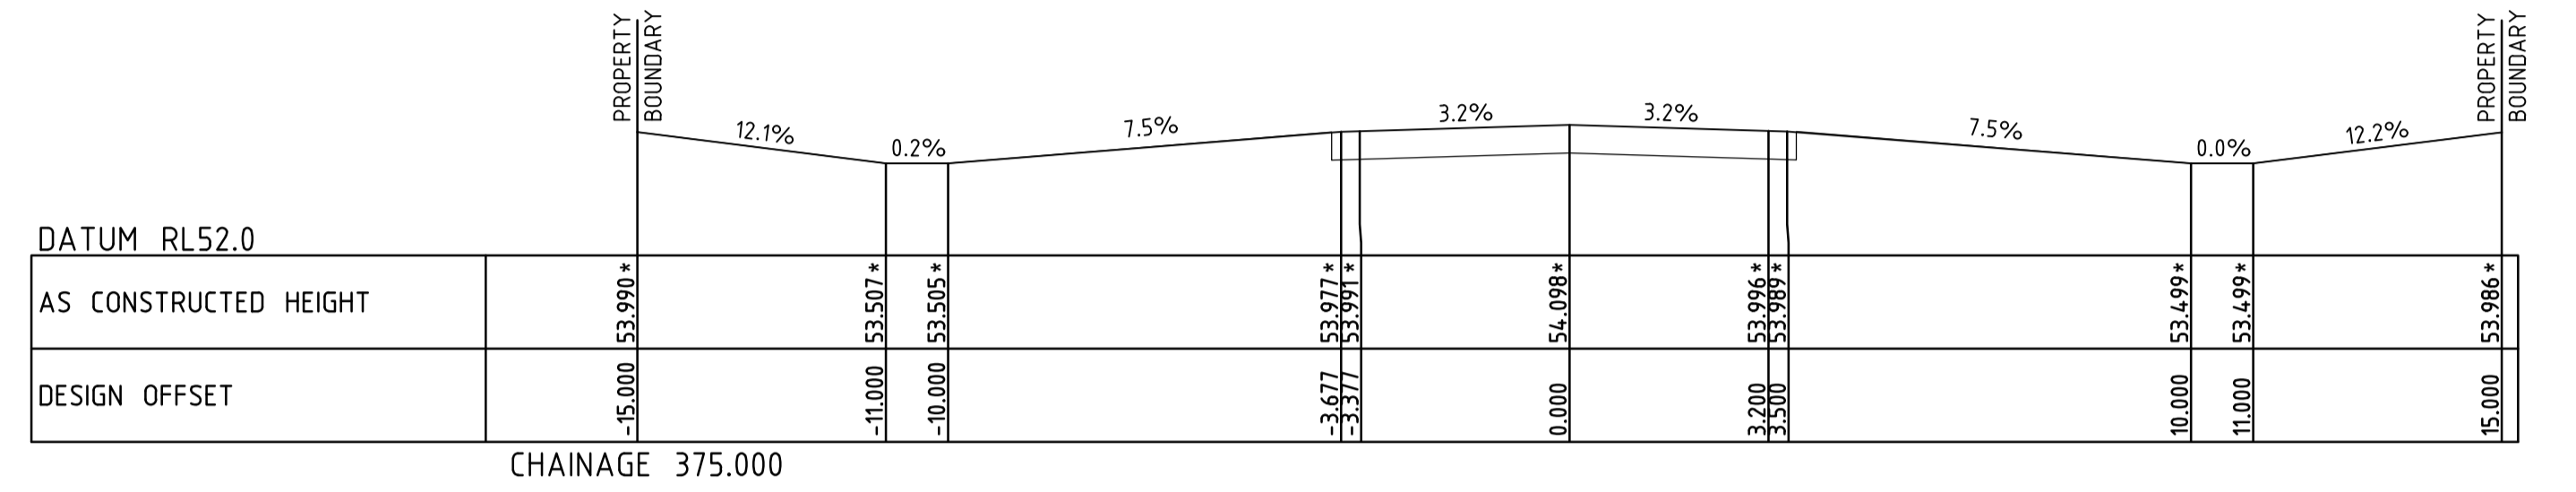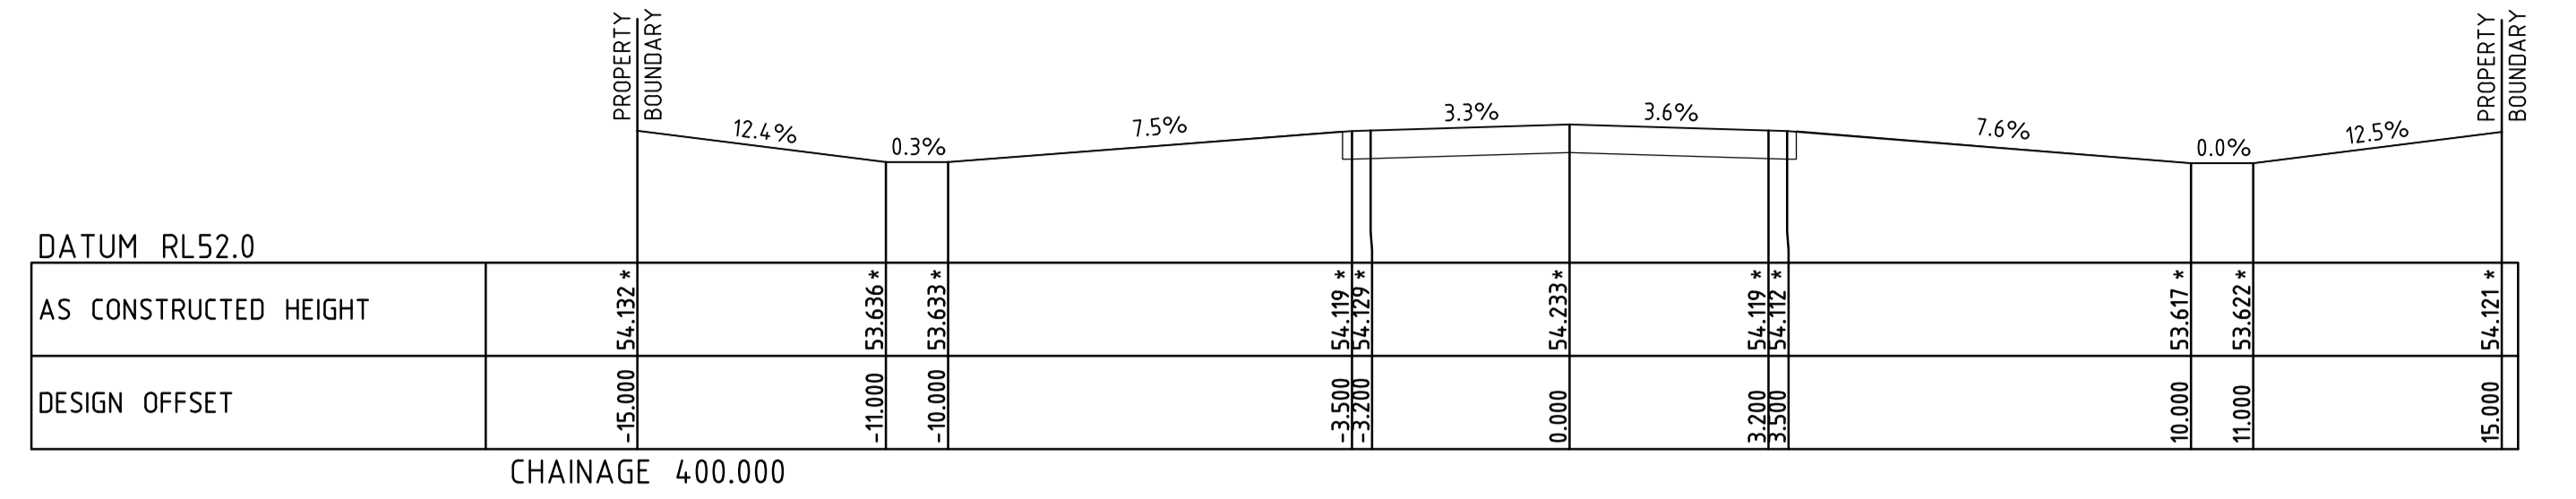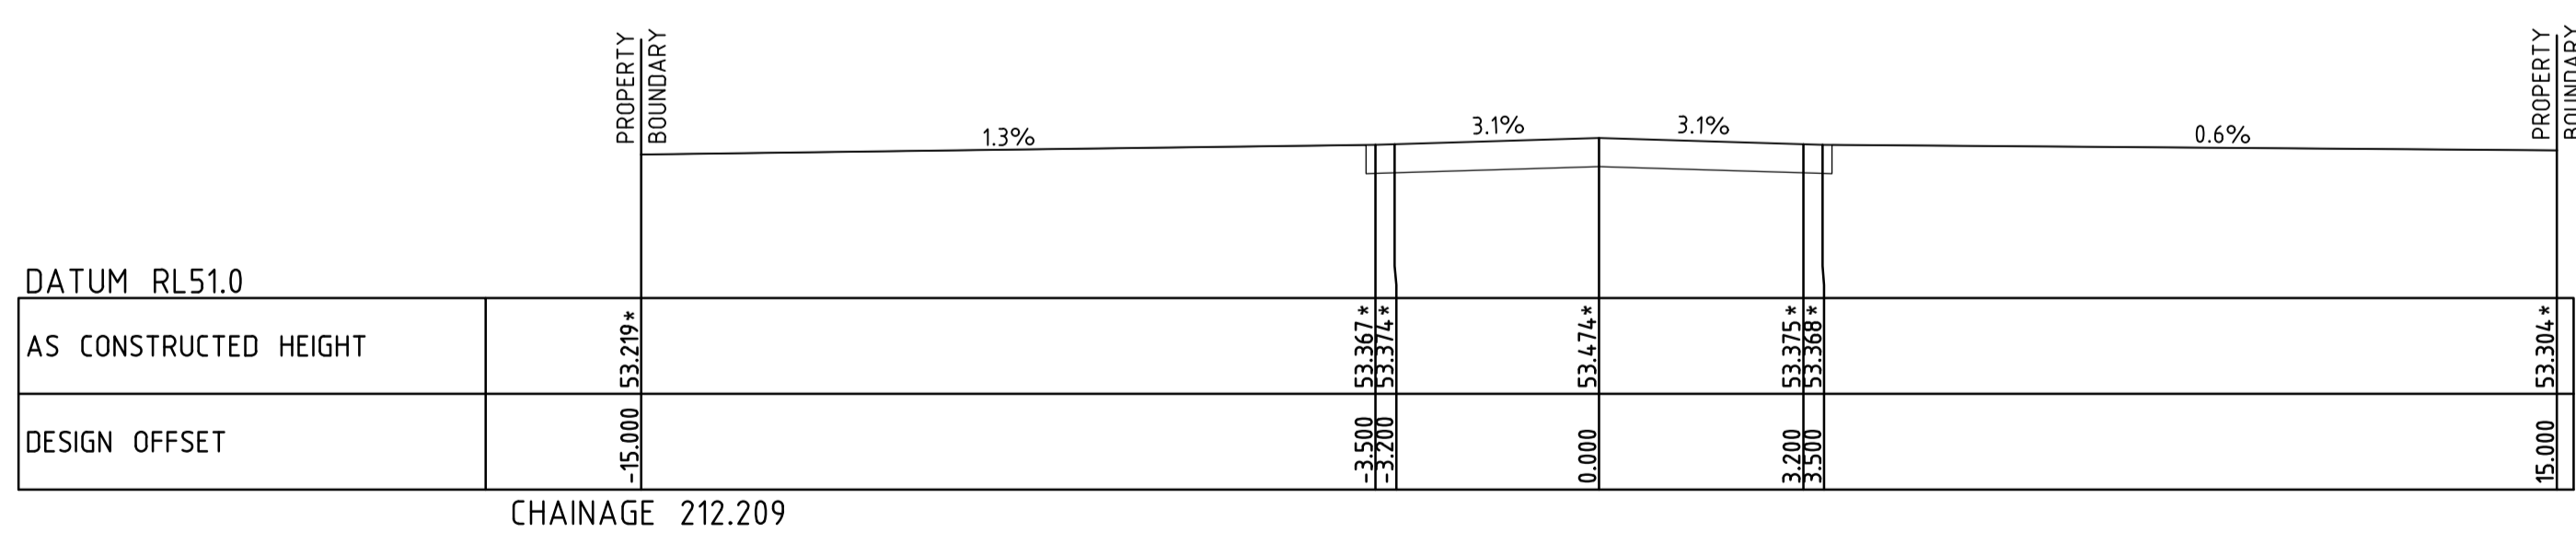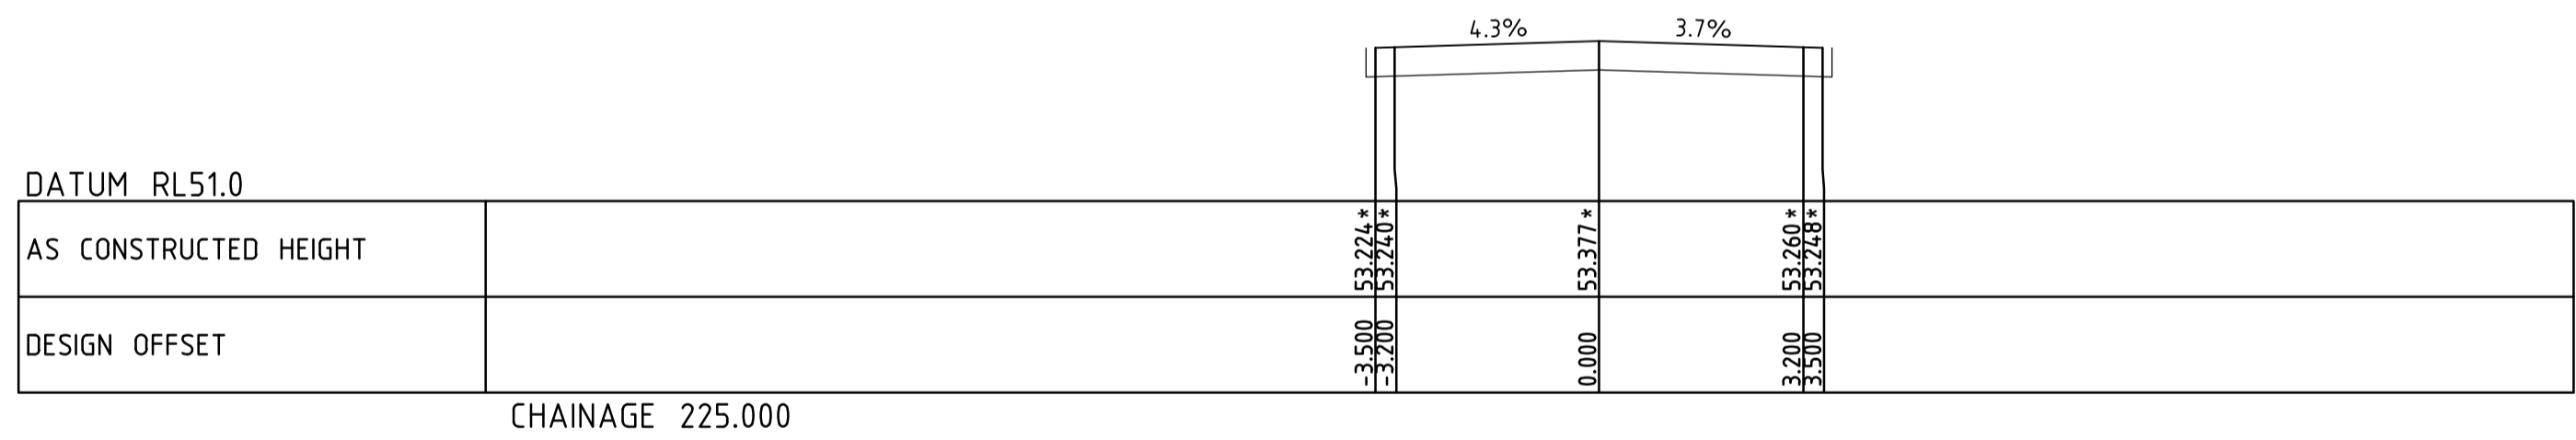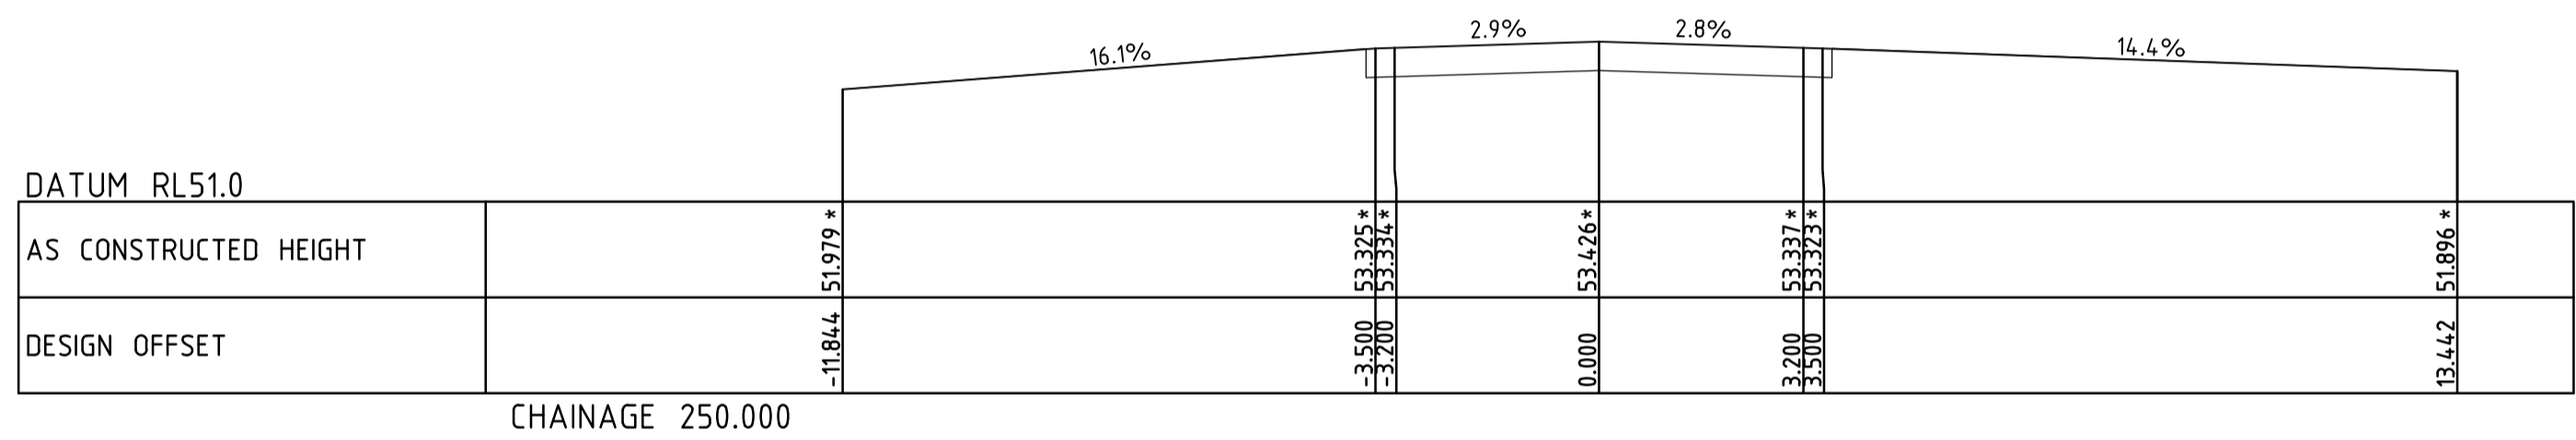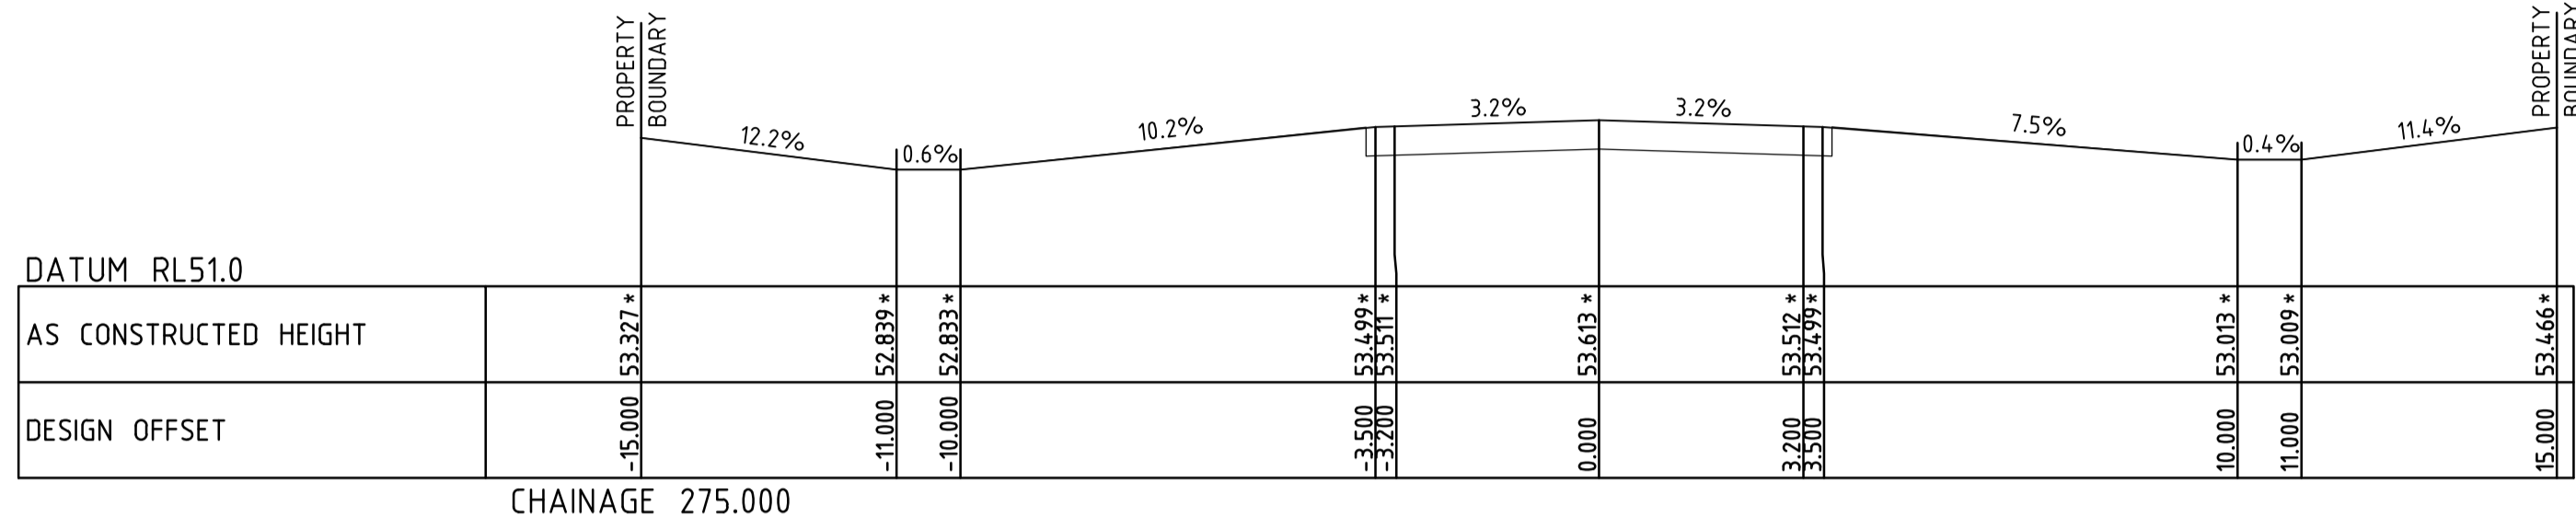

XREFS: CAD File: S:\PROJECTS\TOWNSVILLE OFFICE\960019671\9671-92 - Mount Margaret\ENGINEERING\AS CONSTRUCTED\STAGE 6\STAGE 6B\967192-CI-1607.dwg

Rev	Date	Description	Des.	Verif.	Appd.
A	6/11/2020	AS-CONSTRUCTED ISSUE	LL	JW	MB




© Cardno Limited All Rights Reserved.
This document is produced by Cardno Limited solely for the benefit of and use by the client in accordance with the terms of the retainer. Cardno Limited does not and shall not assume any responsibility or liability whatsoever to any third party arising out of any use or reliance by third party on the content of this document.

Cardno (Qld) Pty Ltd | ABN 57 051 074 992
Level 1, 520 Flinders Street
Townsville, QLD 4810
Tel: 07 4772 1166 Fax: 07 4721 2508
Web: www.cardno.com.au

Drawn	LL	Date	6/11/2020
Checked	JW	Date	6/11/2020
Designed	JN	Date	6/11/2020
Verified	JW	Date	6/11/2020
Approved	<i>[Signature]</i>	Date	10801
MB		DATE:	6/11/2020

Client	MOUNT MARGARET DEVELOPMENTS PTY LTD
Project	MOUNT MARGARET, ALICE RIVER
	STAGE 6B
	AS-CONSTRUCTED
Title	ROADWORKS CROSS SECTIONS
	CRYSTAL CRESCENT - ROAD F

Status	AS CONSTRUCTED						
Datum	A.H.D	Date	6/11/2020	Scale	As Shown	Size	A1
Drawing Number	967192-CI-1607			Revision	A		

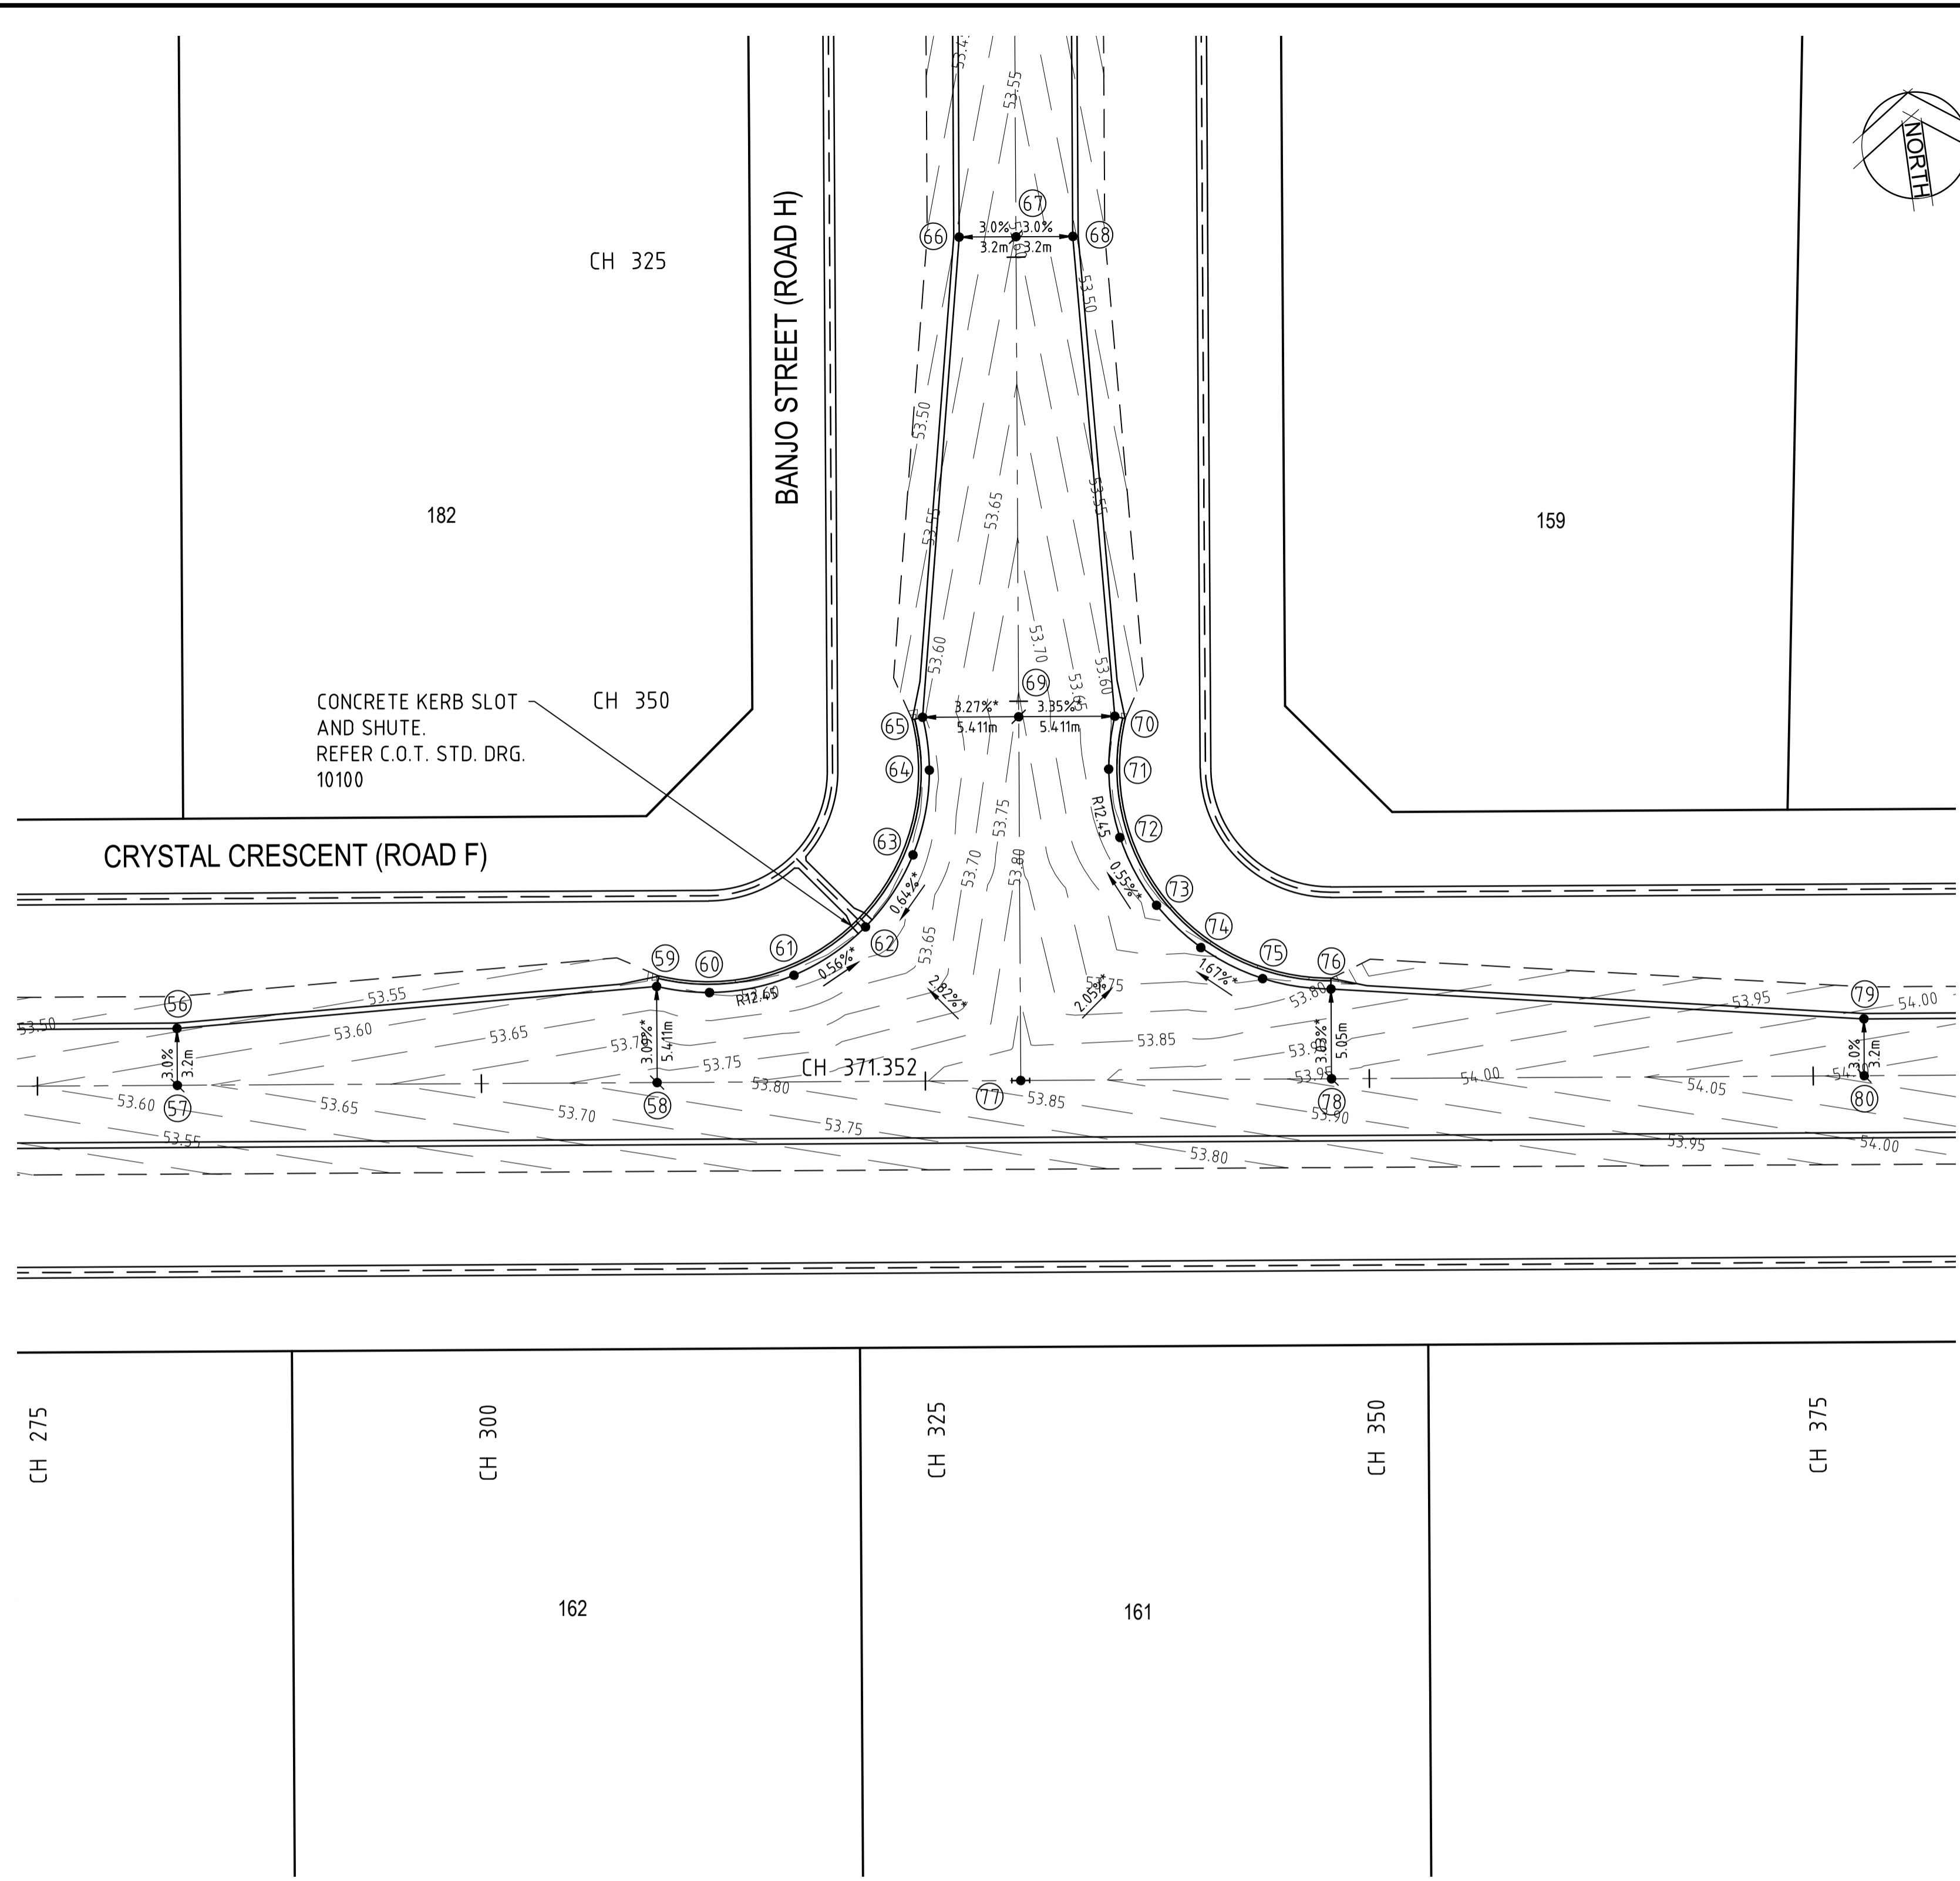

PLAN
SCALE 1:250 @ A1

AS CONSTRUCTED

Rowlands Surveys Pty Ltd (ACN 010 025 260) hereby certify that the works detailed on this drawing, denoted *, have been constructed to the dimensions and levels shown

Laurence John Nolan
Director / Registered Surveyor
Date: 9/11/2020

CARDNO (QLD) PTY LTD HEREBY CERTIFY THAT THE WORKS AS SHOWN ON THE AS CONSTRUCTED DRAWINGS REFLECT ANY CHANGES THAT WERE MADE DURING THE COURSE OF CONSTRUCTION.

[Signature]
RPEQ
10801 RPEQ NO.
06/11/2020 DATE

SETOUT POINTS			
PT No.	EASTING	NORTHING	RL
56	57291.568	861152.567	53.545
57	57291.157	861149.393	53.641
58	57317.954	861145.921	53.788*
59	57318.650	861151.288	53.621*
60	57321.557	861150.547	53.598*
61	57326.403	861150.875	53.573*
62	57330.756	861153.032	53.546*
63	57333.951	861156.691	53.577*
64	57335.503	861161.294	53.592*
65	57335.527	861164.294	53.601*
66	57341.192	861190.808	53.506
67	57344.366	861190.397	53.602
68	57347.539	861189.985	53.506
69	57340.894	861163.599	53.788*
70	57346.260	861162.903	53.597*
71	57345.519	861159.996	53.603*
72	57345.629	861156.103	53.613*
73	57347.162	861152.039	53.637*
74	57349.315	861149.348	53.747*
75	57352.530	861147.149	53.812*
76	57356.267	861146.050	53.827*
77	57338.263	861143.290	53.893*
78	57355.618	861141.042	53.980*
79	57385.780	861140.361	54.015
80	57385.369	861137.187	54.111

LEGEND


- BARRIER KERB & CHANNEL (TYPE B1)
- CONCRETE EDGE BEAM (300x300)
- CONCRETE DISH DRAIN (TYPE D2)
- SETOUT POINT
- DESIGN GRADE

ROADWORKS NOTES

- CONTOURS DENOTED THUS 4.00 INDICATE GROUND FINISHED SURFACE LEVELS.
- ALL LEVELS ARE LIP OF KERB LEVELS OR CROWN LEVELS.
- ALL SETOUT IS TO LIP OF KERB UNLESS OTHERWISE NOTED.
- GRADE EVENLY BETWEEN LEVELS SHOWN.
- CONTRACTOR SHALL ENSURE THAT ALL KERB AND CHANNEL GRADES SHALL NOT FALL BELOW 0.25% AT ANY POINT IRRESPECTIVE OF ROAD CENTRELINE GRADING SHOWN ON LONGITUDINAL SECTIONS.

XREFs: XR-967192-MASTER-XR-967192-CADASTRAL-XR-967192-DESIGN-CONTOURS-ROADS-678
CAD File: S:\PROJECTS\TOWNSVILLE OFFICE\967192- Mount Margaret Developments\AS CONSTRUCTED\STAGE 6\STAGE 6B\967192-CI-1608.dwg

Rev.	Date	Description	Des.	Verif.	Appd.
A	6/11/2020	AS-CONSTRUCTED ISSUE	LL	JW	MB

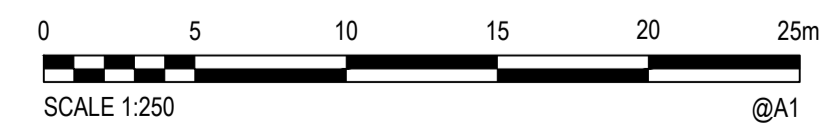


© Cardno Limited All Rights Reserved.
This document is produced by Cardno Limited solely for the benefit of and use by the client in accordance with the terms of the retainer. Cardno Limited does not and shall not assume any responsibility or liability whatsoever to any third party arising out of any use or reliance by third party on the content of this document.

Cardno (Qld) Pty Ltd | ABN 57 051 074 992
Level 1, 520 Flinders Street
Townsville, QLD 4810
Tel: 07 4772 1166 Fax: 07 4721 2508
Web: www.cardno.com.au

Drawn	LL	Date	6/11/2020
Checked	JW	Date	6/11/2020
Designed	JN	Date	6/11/2020
Verified	JW	Date	6/11/2020
Approved	<i>[Signature]</i>	Date	10801
MB		DATE:	6/11/2020

Client	MOUNT MARGARET DEVELOPMENTS PTY LTD
Project	MOUNT MARGARET, ALICE RIVER
	STAGE 6B
	AS-CONSTRUCTED
Title	INTERSECTION DETAILS PLAN

Status	AS CONSTRUCTED						
Datum	A.H.D	Date	6/11/2020	Scale	As Shown	Size	A1
Drawing Number	967192-CI-1608			Revision	A		

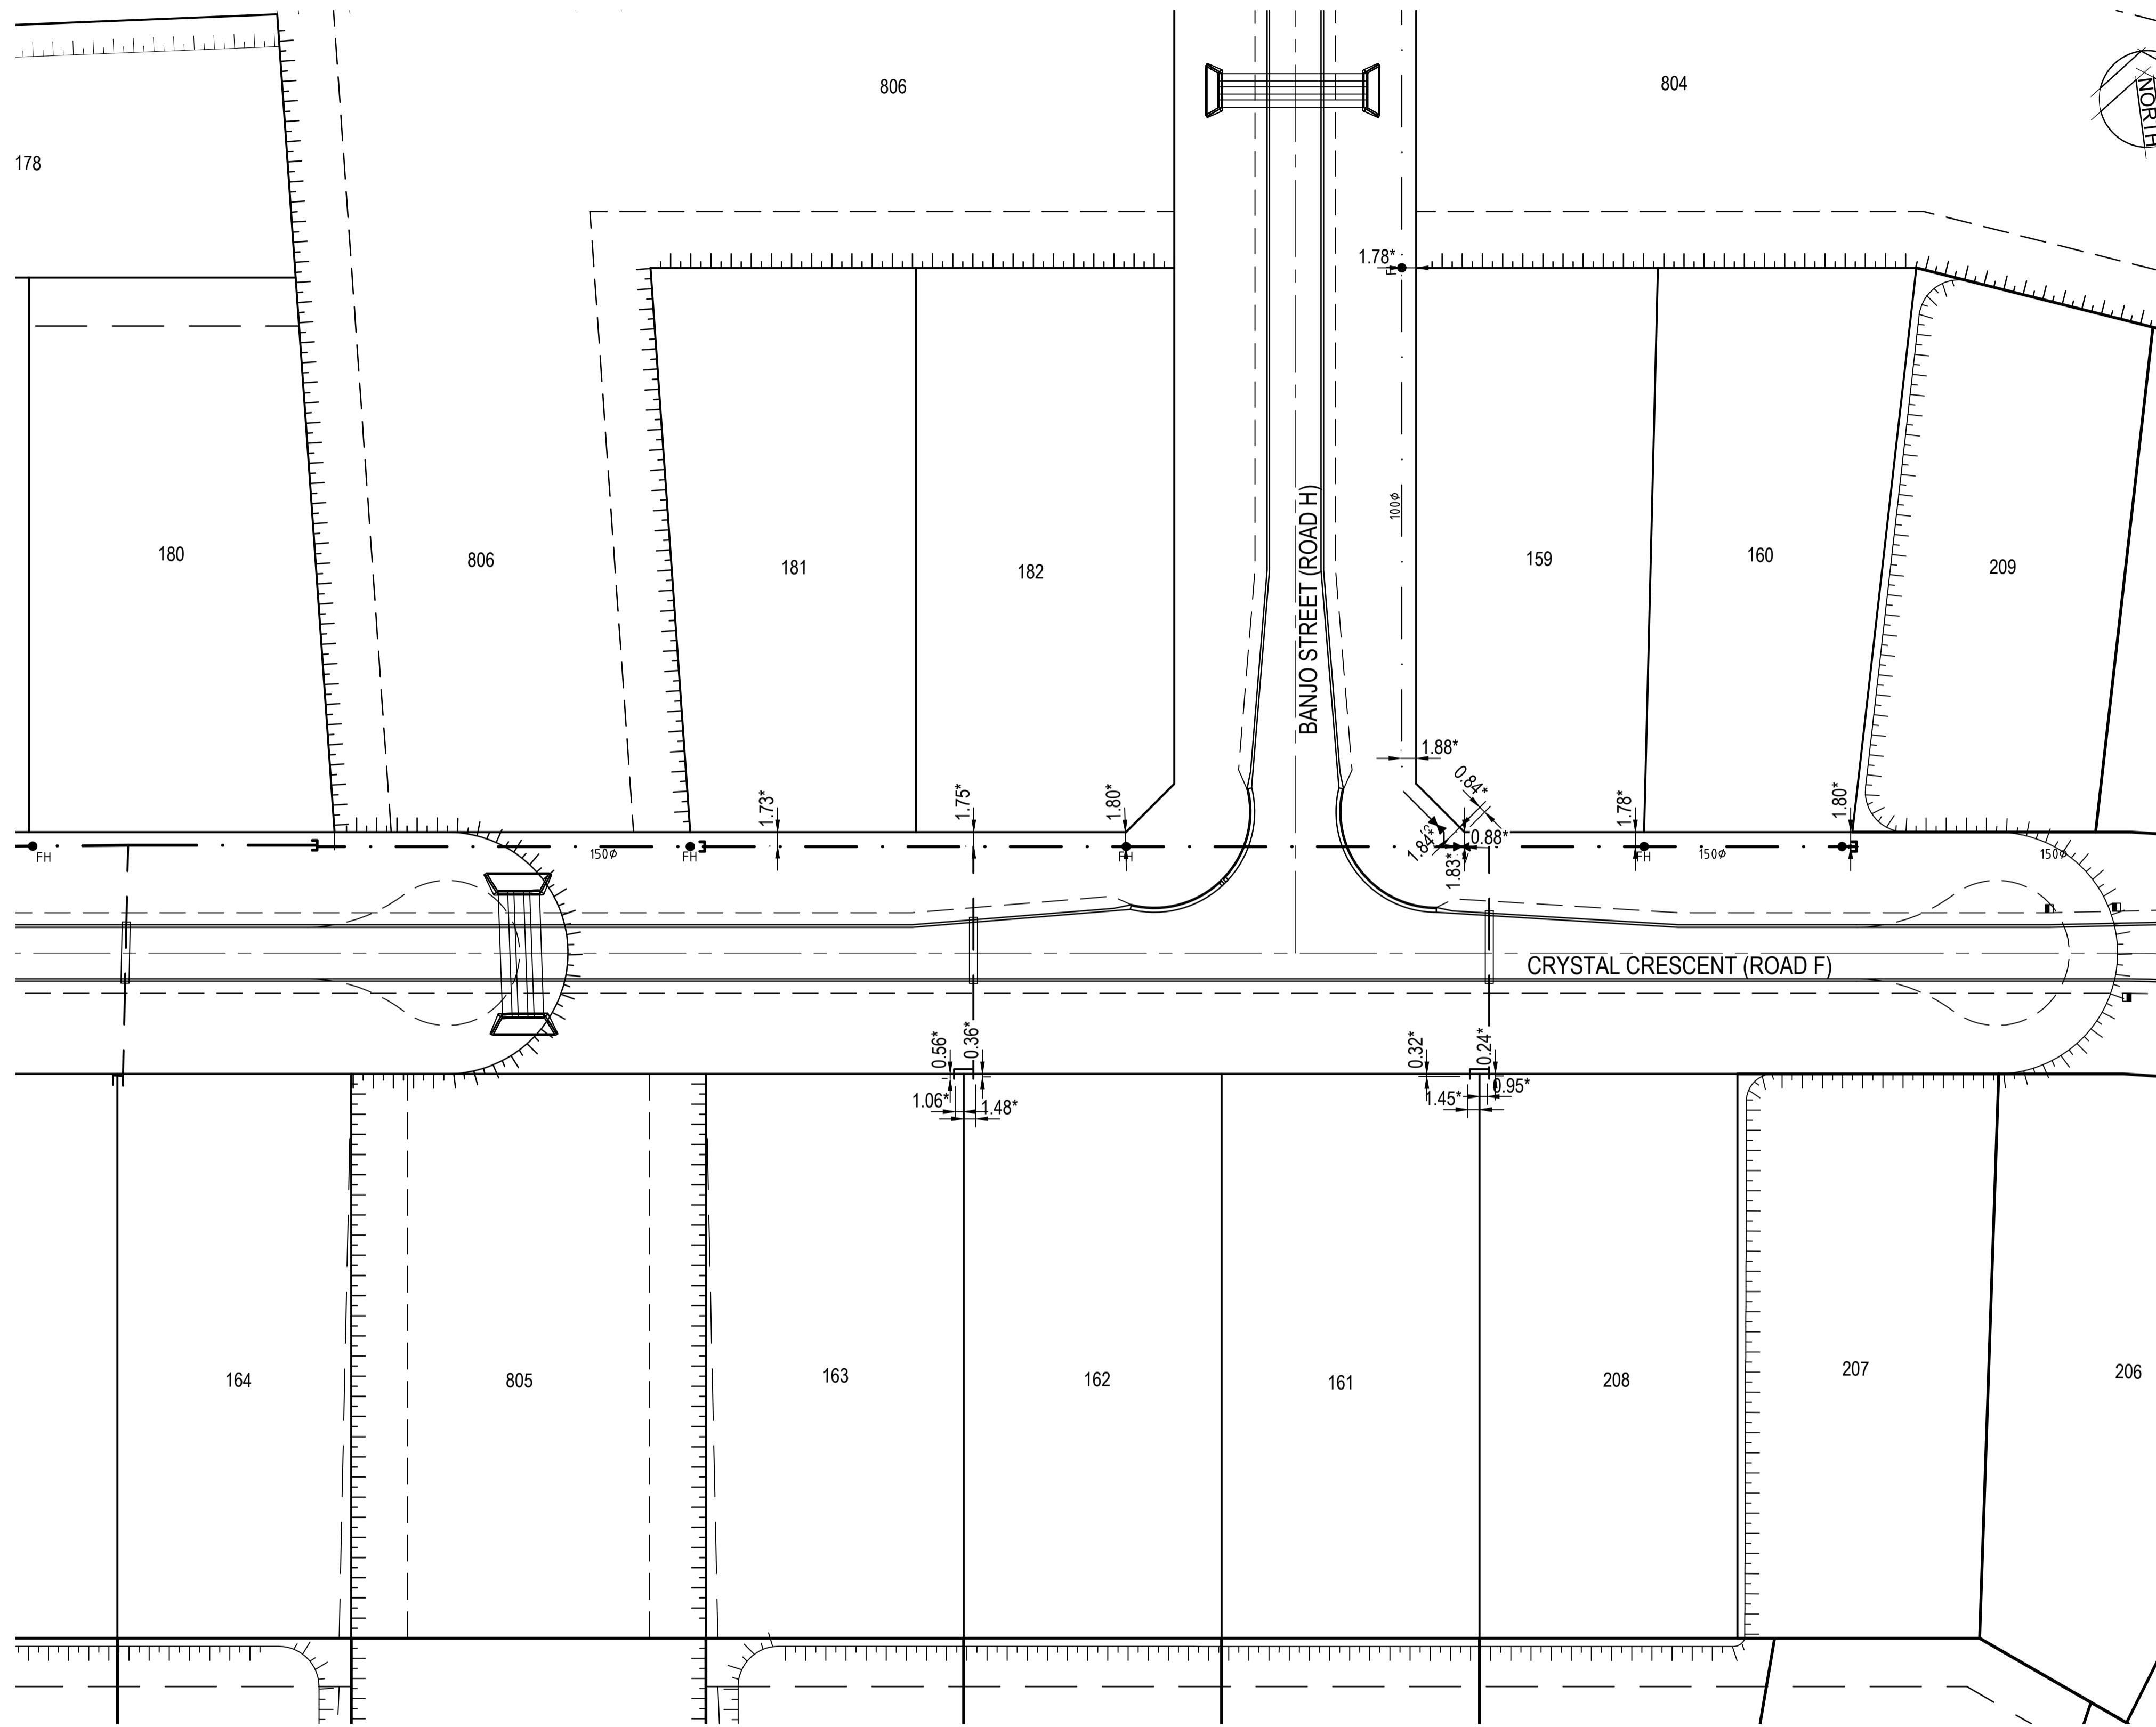

NOTES

1. THIS DRAWING IS TO BE READ IN CONJUNCTION WITH THE RELEVANT CITY COUNCIL STANDARD WATER DRAWINGS INCLUDING FORMER THURINGOWA STANDARD DRAWINGS.
2. CONNECTION TO EXISTING WATERMAIN ARE CARRIED OUT BY THE COUNCIL AT CONTRACTORS COST.
3. ALL WATERMANS ARE LOCATED 1.8m +/- 0.1m OFF ROAD RESERVE ALIGNMENTS UNLESS NOTED OTHERWISE.
4. PIPES FOR WATER MAINS ARE PVC-U CLASS 16, OD COMPATIBLE TO AS1477, RUBBER RING JOINTED WITH SOCKETED DICL FITTINGS.
5. PIPE FITTINGS ARE DICL TO AS2280.
6. POLYTHENE PIPES ARE MDPE PN16 TO AS4130

LEGEND

- EXISTING WATERMAIN
- EXISTING FIRE HYDRANT
- EXISTING VALVE
- EXISTING TEE
- EXISTING END CAP
- WATERMAIN AND SIZE
- FIRE HYDRANT
- VALVE AND SIZE
- TEE
- END CAP
- 32 O.D. MDPE WITH ENVELOPER

AS CONSTRUCTED

Rowlands Surveys Pty Ltd (ACN 010 025 260) hereby certify that the works detailed on this drawing, denoted *, have been constructed to the dimensions and levels shown.


Date: 9/11/2020

Laurence John Nolan
 Director / Registered Surveyor

CARDNO (QLD) PTY LTD HEREBY CERTIFY THAT THE WORKS AS SHOWN ON THE AS CONSTRUCTED DRAWINGS REFLECT ANY CHANGES THAT WERE MADE DURING THE COURSE OF CONSTRUCTION.

[Signature] RPEQ
 10801 RPEQ NO.
 06/11/2020 DATE

PLAN
 SCALE 1:500 @ A1

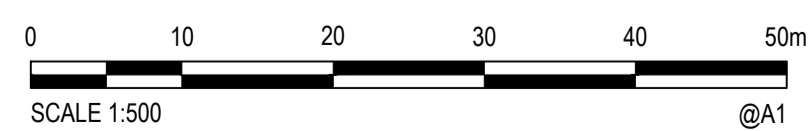

© Cardno Limited All Rights Reserved.
 This document is produced by Cardno Limited solely for the benefit of and use by the client in accordance with the terms of the retainer. Cardno Limited does not and shall not assume any responsibility or liability whatsoever to any third party arising out of any use or reliance by third party on the content of this document.

Cardno
 Shaping the Future



Cardno (Qld) Pty Ltd | ABN 57 051 074 992
 Level 1, 520 Flinders Street
 Townsville, QLD 4810
 Tel: 07 4772 1166 Fax: 07 4721 2508
 Web: www.cardno.com.au

Drawn	LL	Date	6/11/2020
Checked	JW	Date	6/11/2020
Designed	JN	Date	6/11/2020
Verified	JW	Date	6/11/2020
Approved	<i>[Signature]</i>	Date	10801
	MB	DATE:	6/11/2020

Client	MOUNT MARGARET DEVELOPMENTS PTY LTD
Project	MOUNT MARGARET, ALICE RIVER
	STAGE 6B
	AS-CONSTRUCTED
Title	WATER RETICULATION LAYOUT PLAN
	SHEET 1 OF 2

Status	AS CONSTRUCTED						
Datum	A.H.D	Date	6/11/2020	Scale	As Shown	Size	A1
Drawing Number	967192-CI-1609			Revision	A		

Rev.	Date	Description	Des.	Verif.	Appd.
A	6/11/2020	AS-CONSTRUCTED ISSUE	LL	JW	MB

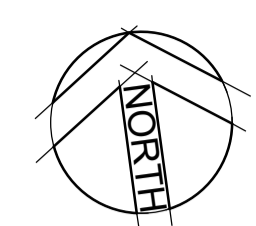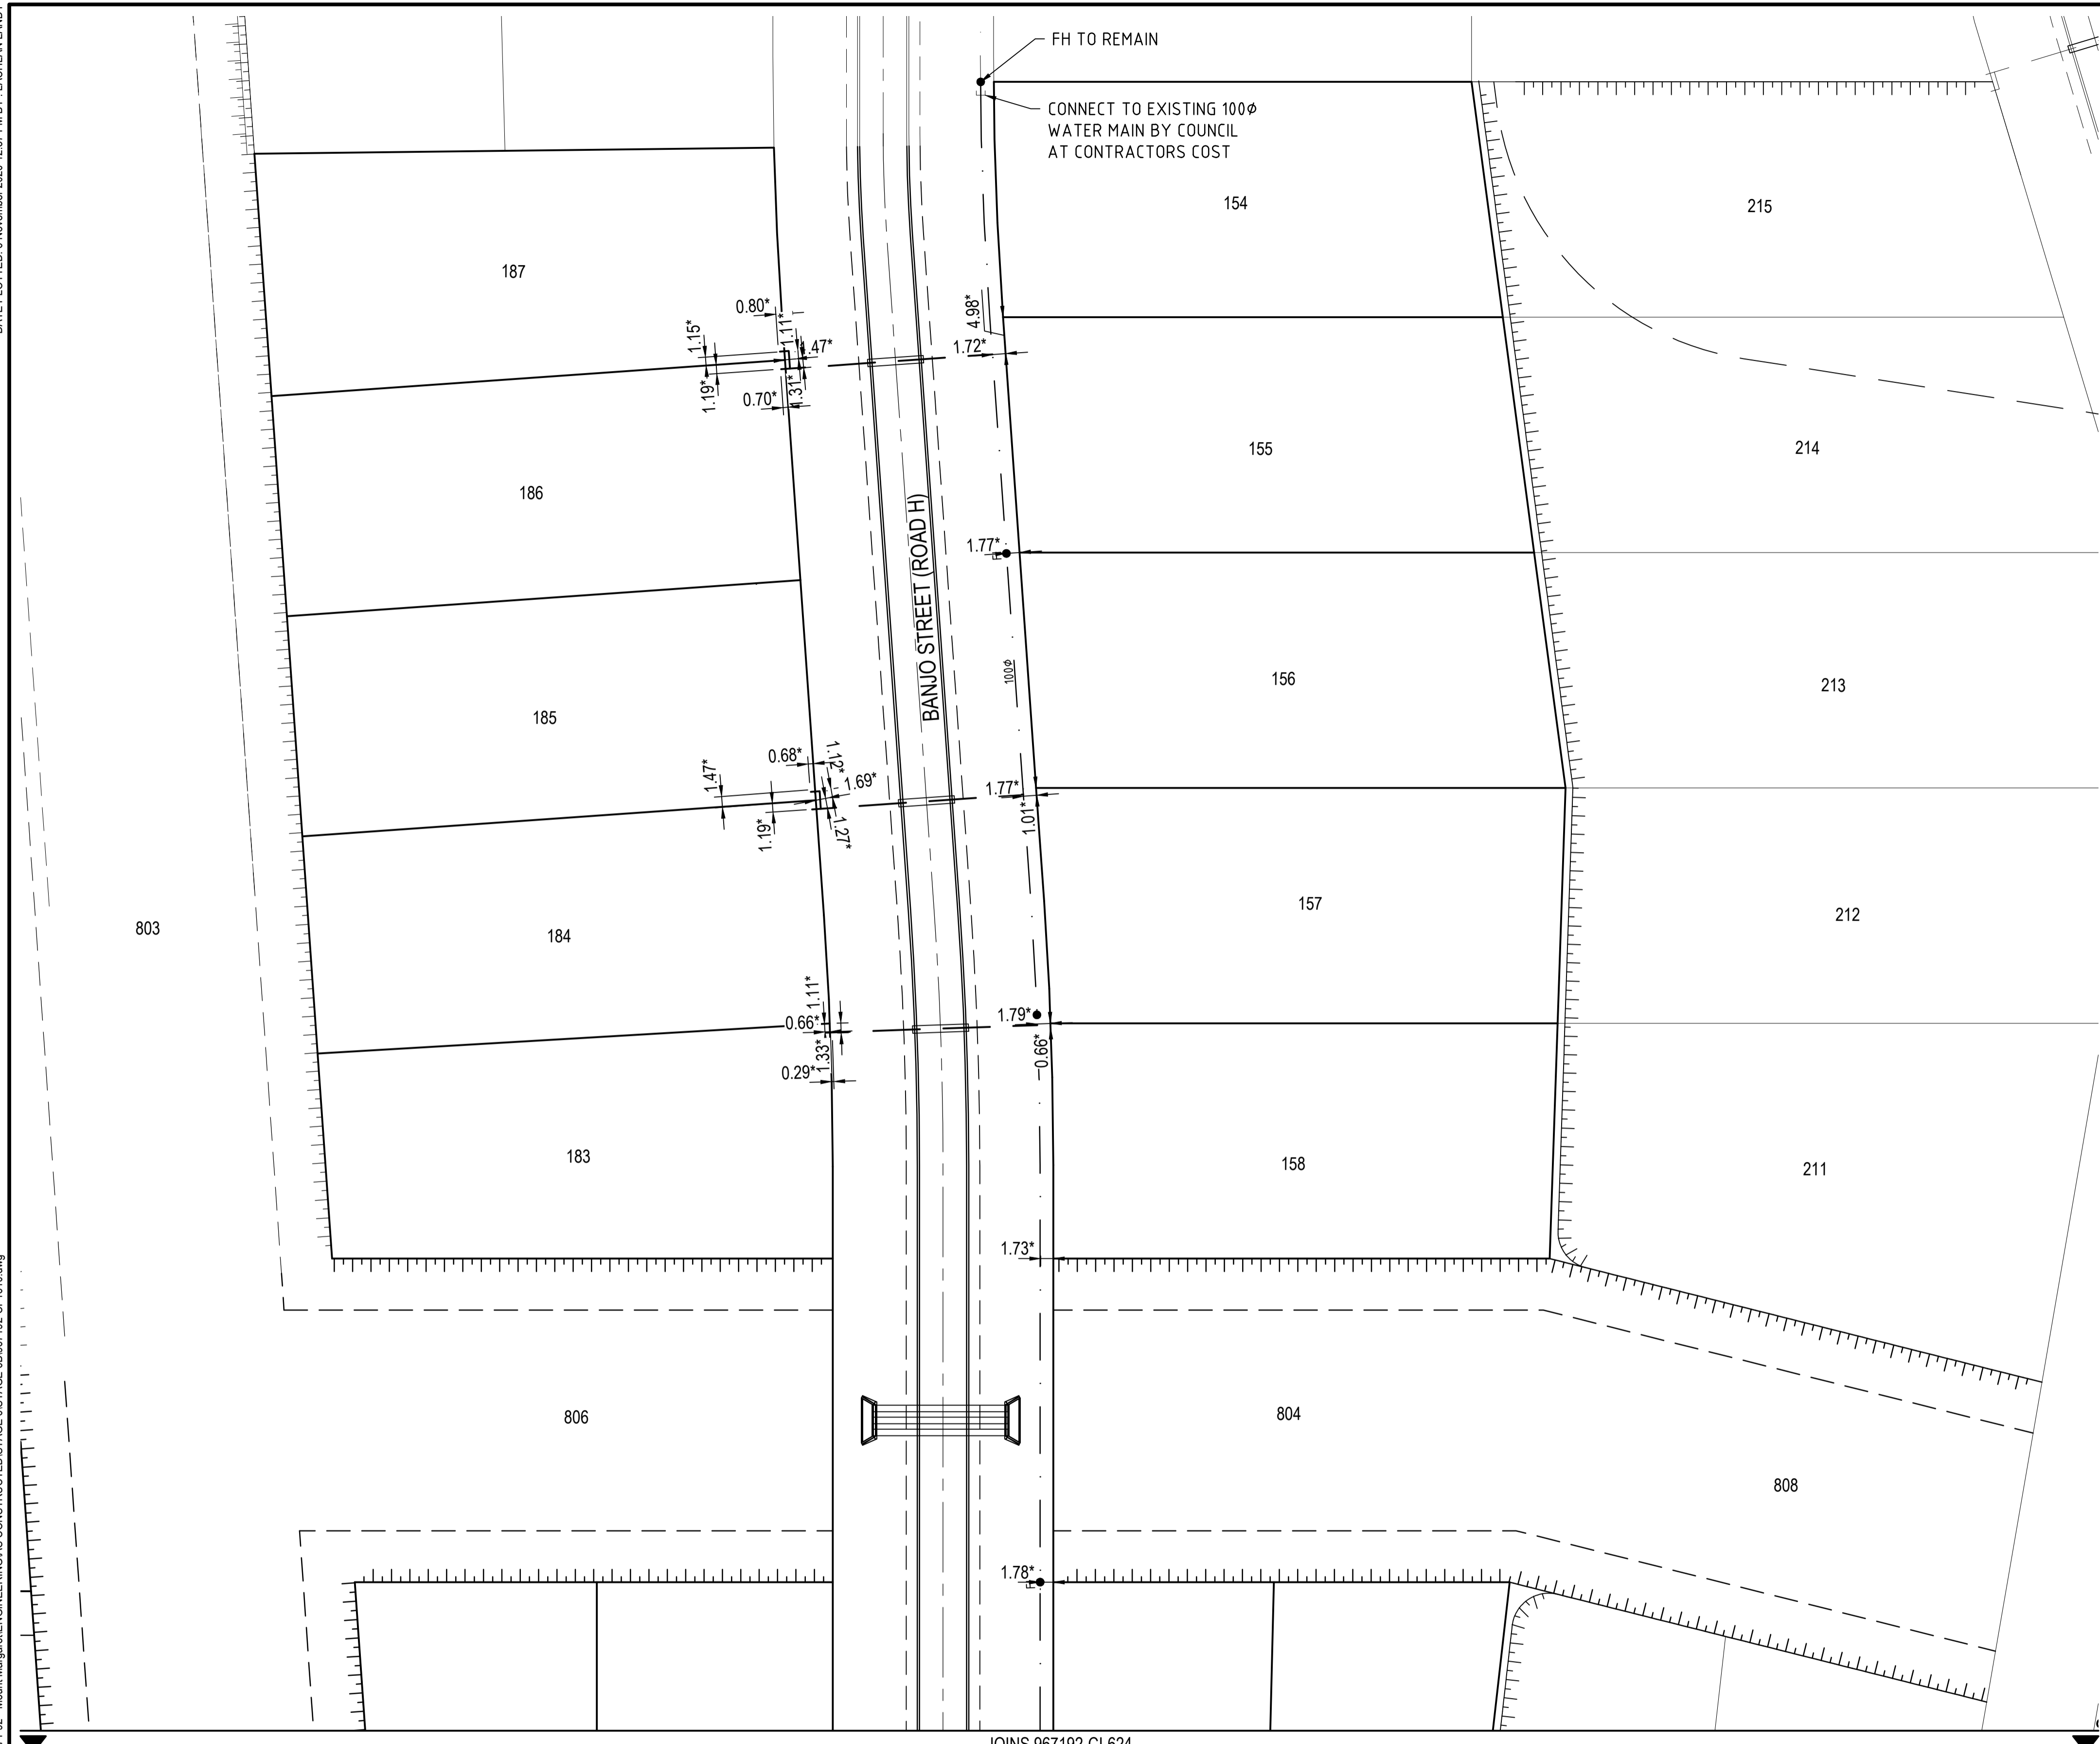

NOTES

1. THIS DRAWING IS TO BE READ IN CONJUNCTION WITH THE RELEVANT CITY COUNCIL STANDARD WATER DRAWINGS INCLUDING FORMER THURINGOWA STANDARD DRAWINGS.
2. CONNECTION TO EXISTING WATERMAIN TO BE CARRIED OUT BY THE COUNCIL AT CONTRACTORS COST.
3. ALL WATERMAINS TO BE LOCATED 1.8m +/- 0.1m OFF ROAD RESERVE ALIGNMENTS UNLESS NOTED OTHERWISE.
4. PIPES FOR WATER MAINS TO BE PVC-U CLASS 16, OD COMPATIBLE TO AS1477, RUBBER RING JOINTED WITH SOCKETED DICL FITTINGS.
5. PIPE FITTINGS TO BE DICL TO AS2280.
6. POLYTHENE PIPES SHALL BE MDPE PN16 TO AS4130
7. TRENCH WALLS FOR SERVICES WILL NEED TO BE BATTERED FOR CONSTRUCTION SAFETY.

LEGEND

- - - - - EXISTING WATERMAIN
- - - - - EXISTING FIRE HYDRANT
- - - - - EXISTING VALVE
- - - - - EXISTING TEE
- - - - - EXISTING END CAP
- - - - - WATERMAIN AND SIZE
- - - - - FIRE HYDRANT
- - - - - VALVE AND SIZE
- - - - - TEE
- - - - - END CAP
- - - - - 32 O.D. MDPE WITH ENVELOPER

AS CONSTRUCTED

Rowlands Surveys Pty Ltd (ACN 010 025 260) hereby certify that the works detailed on this drawing, denoted *, have been constructed to the dimensions and levels shown.


Date: 9/11/2020
Laurence John Nolan
Director / Registered Surveyor

CARDNO (QLD) PTY LTD HEREBY CERTIFY THAT THE WORKS AS SHOWN ON THE AS CONSTRUCTED DRAWINGS REFLECT ANY CHANGES THAT WERE MADE DURING THE COURSE OF CONSTRUCTION.

[Signature] RPEQ
10801 RPEQ NO.
06/11/2020 DATE

JOINS 967192-CI-624

PLAN
SCALE 1:500 @ A1

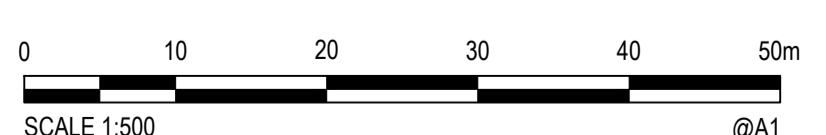

© Cardno Limited All Rights Reserved.
This document is produced by Cardno Limited solely for the benefit of and use by the client in accordance with the terms of the retainer. Cardno Limited does not and shall not assume any responsibility or liability whatsoever to any third party arising out of any use or reliance by third party on the content of this document.

Cardno (Qld) Pty Ltd | ABN 57 051 074 992
Level 1, 520 Flinders Street
Townsville, QLD 4810
Tel: 07 4772 1166 Fax: 07 4721 2508
Web: www.cardno.com.au



Drawn	LL	Date	6/11/2020
Checked	JW	Date	6/11/2020
Designed	JN	Date	6/11/2020
Verified	JW	Date	6/11/2020
Approved	<i>[Signature]</i>	Date	10801
MB		DATE:	6/11/2020

Client	MOUNT MARGARET DEVELOPMENTS PTY LTD
Project	MOUNT MARGARET, ALICE RIVER
	STAGE 6B
	AS-CONSTRUCTED
Title	WATER RETICULATION LAYOUT PLAN
	SHEET 2 OF 2

Status	AS CONSTRUCTED						
Datum	A.H.D	Date	6/11/2020	Scale	As Shown	Size	A1
Drawing Number	967192-CI-1610			Revision	A		

Rev.	Date	Description	Des.	Verif.	Appd.
A	6/11/2020	AS-CONSTRUCTED ISSUE	LL	JW	MB

DATE PLOTTED: 6 November 2020 2:31 PM BY: LACHLAN LINDY

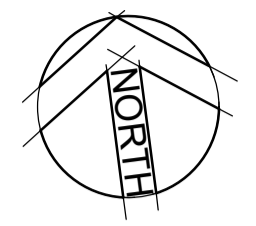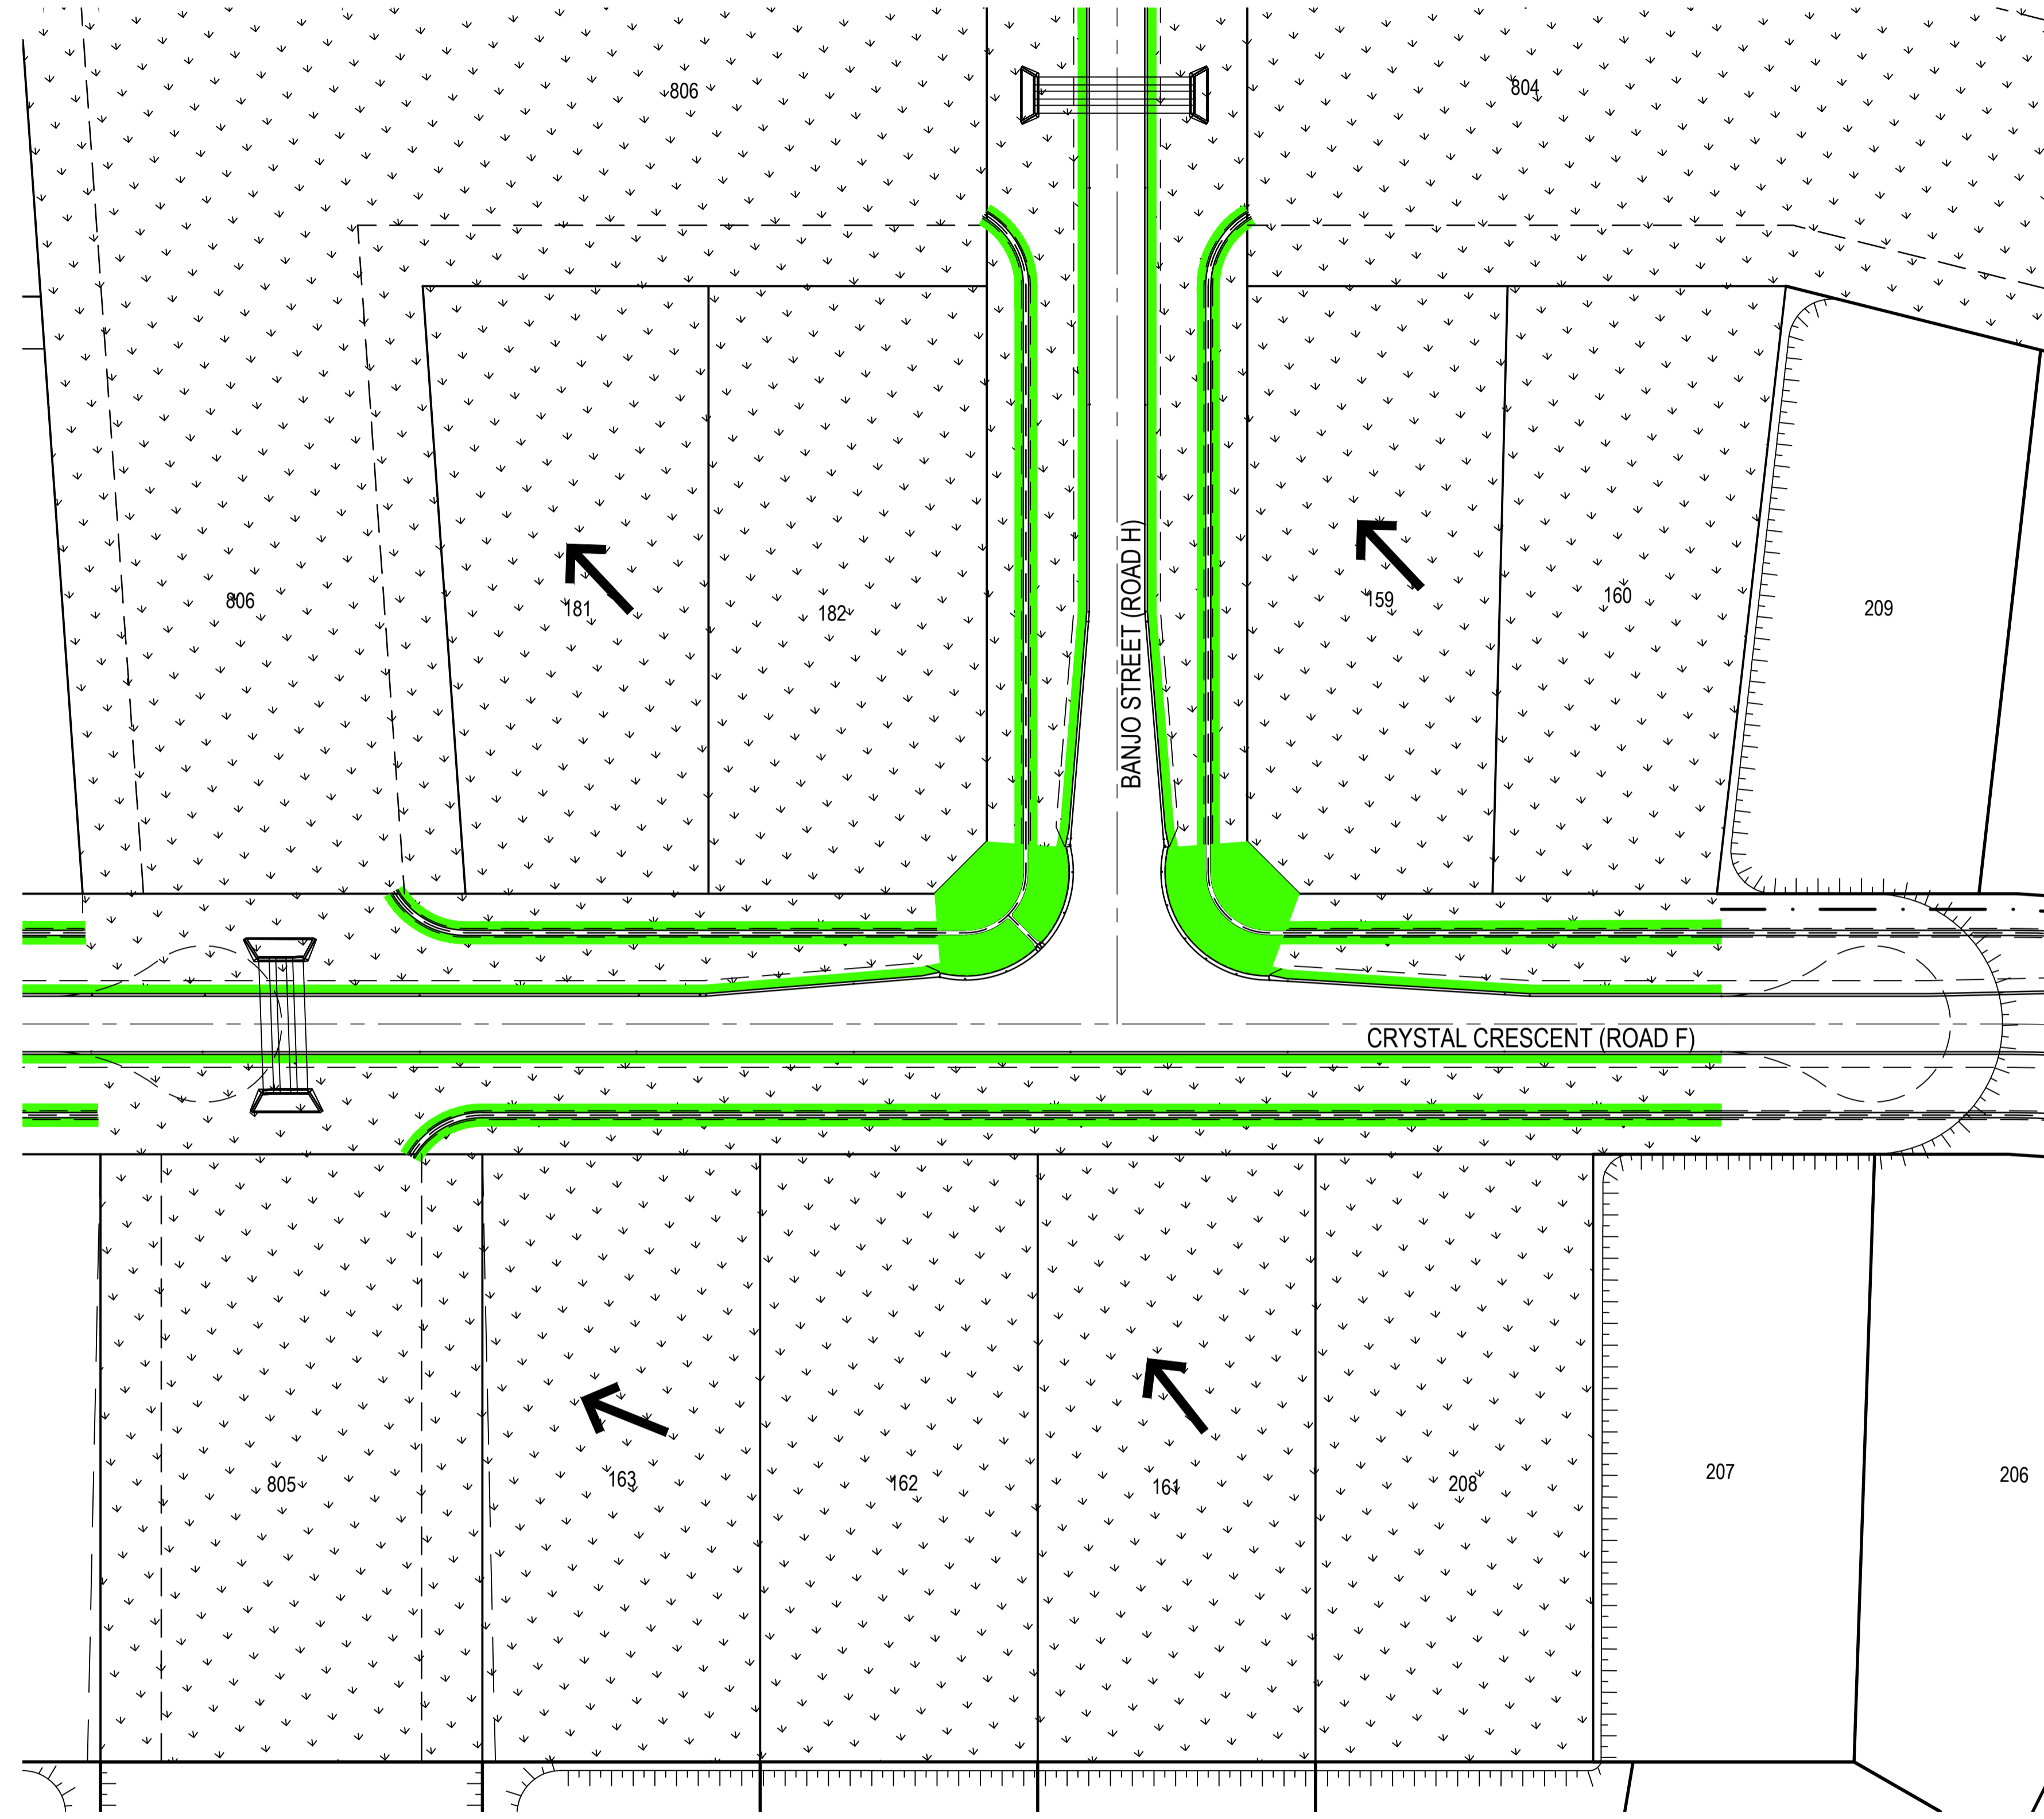

CARDNO (QLD) PTY LTD HEREBY CERTIFY THAT THE WORKS AS SHOWN ON THE AS CONSTRUCTED DRAWINGS REFLECT ANY CHANGES THAT WERE MADE DURING THE COURSE OF CONSTRUCTION.

[Signature] RPEQ
 10801 RPEQ NO.
 06/11/2020 DATE


NOTES

1. ALL MEASURES FOR EROSION AND SEDIMENTATION CONTROL SHALL BE MAINTAINED BY THE CONTRACTOR THROUGHOUT CONSTRUCTION AND THE MAINTENANCE PERIOD.
2. ALL MEASURES FOR EROSION AND SEDIMENTATION CONTROL SHALL BE INSTALLED AND MAINTAINED BY THE CONTRACTOR IN SUCH A MANNER SO AS NOT TO PRESENT A POTENTIAL HAZARD TO ANY PERSON OR PROPERTY.

LEGEND

- DIRECTION OF OVERLAND FLOW PATH
- TURFING
- TOP OF BATTER
- BOTTOM OF BATTER
- GRASSING

PLAN
SCALE 1:500 @ A1

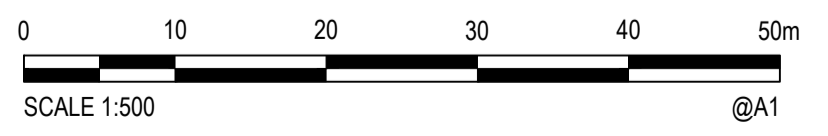

© Cardno Limited All Rights Reserved.
 This document is produced by Cardno Limited solely for the benefit of and use by the client in accordance with the terms of the retainer. Cardno Limited does not and shall not assume any responsibility or liability whatsoever to any third party arising out of any use or reliance by third party on the content of this document.

Cardno (Qld) Pty Ltd | ABN 57 051 074 992
 Level 1, 520 Flinders Street
 Townsville, QLD 4810
 Tel: 07 4772 1166 Fax: 07 4721 2508
 Web: www.cardno.com.au

Drawn	LL	Date	6/11/2020
Checked	JW	Date	6/11/2020
Designed	JN	Date	6/11/2020
Verified	JW	Date	6/11/2020
Approved	<i>[Signature]</i>	Date	10801
MB		DATE:	6/11/2020

Client	MOUNT MARGARET DEVELOPMENTS PTY LTD
Project	MOUNT MARGARET, ALICE RIVER
Stage	STAGE 6B
AS-CONSTRUCTED	
Title	SOIL EROSION & SEDIMENT CONTROL PLAN
	SHEET 1 OF 2

Status	AS CONSTRUCTED						
Datum	A.H.D	Date	6/11/2020	Scale	As Shown	Size	A1
Drawing Number	967192-CI-1611			Revision	A		

XREF's: XR-967192-CADASTRAL; XR-967192-MASTER
 CAD File: S:\PROJECTS\TOWNSVILLE OFFICE\9600367196719671-92 - Mount Margaret\ENGINEERING\AS CONSTRUCTED\STAGE 6\STAGE 6B\967192-CI-1611.dwg

Rev.	Date	Description	Des.	Verif.	Appd.
A	6/11/2020	AS-CONSTRUCTED ISSUE	LL	JW	MB

DATE PLOTTED: 6 November 2020 2:31 PM BY: LACHLAN LINDY

XREFs: XR-967192-MASTER; XR-967192-DESIGN-CONTOURS-5T06; XR-967192-MASTER-AC
 CAD File: S:\PROJECTS\TOWNSVILLE OFFICE\967192-CI-1612.dwg



PLAN
 SCALE 1:500 @ A1

CARDNO (QLD) PTY LTD HEREBY CERTIFY THAT THE WORKS AS SHOWN ON THE AS CONSTRUCTED DRAWINGS REFLECT ANY CHANGES THAT WERE MADE DURING THE COURSE OF CONSTRUCTION.


[Signature] RPEQ
 10801 RPEQ NO.
 06/11/2020 DATE

NOTES

- REFER TO AUS-SPEC CONSTRUCTION SPECIFICATION C211 FOR DETAILS DURING CONSTRUCTION.
- ALL STOCKPILES ARE TO HAVE SILT FENCES INSTALLED TO PREVENT SEDIMENT DISCHARGE.
- ALL MEASURES FOR EROSION AND SEDIMENTATION CONTROL SHALL BE MAINTAINED BY THE CONTRACTOR THROUGHOUT CONSTRUCTION AND THE MAINTENANCE PERIOD.
- ALL MEASURES FOR EROSION AND SEDIMENTATION CONTROL SHALL BE INSTALLED AND MAINTAINED BY THE CONTRACTOR IN SUCH A MANNER SO AS NOT TO PRESENT A POTENTIAL HAZARD TO ANY PERSON OR PROPERTY.
- 2x SANDBAGS TO BE PLACED ON DISH DRAIN FOR VELOCITY CONTROL AT APPROXIMATELY 50m c/c

LEGEND

- DIRECTION OF OVERLAND FLOW PATH
- TOP OF BATTER
- BOTTOM OF BATTER
- TURFING
- GRASSING

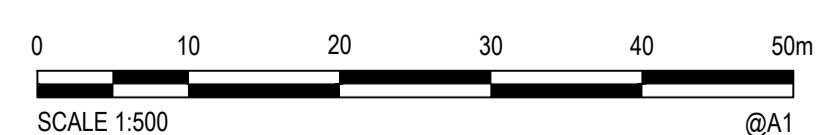

© Cardno Limited All Rights Reserved.
 This document is produced by Cardno Limited solely for the benefit of and use by the client in accordance with the terms of the retainer. Cardno Limited does not and shall not assume any responsibility or liability whatsoever to any third party arising out of any use or reliance by third party on the content of this document.

Cardno (Qld) Pty Ltd | ABN 57 051 074 992
 Level 1, 520 Flinders Street
 Townsville, QLD 4810
 Tel: 07 4772 1166 Fax: 07 4721 2508
 Web: www.cardno.com.au

Drawn	LL	Date	6/11/2020
Checked	JW	Date	6/11/2020
Designed	JN	Date	6/11/2020
Verified	JW	Date	6/11/2020
Approved	<i>[Signature]</i>	Date	10801
MB		DATE:	6/11/2020

Client	MOUNT MARGARET DEVELOPMENTS PTY LTD
Project	MOUNT MARGARET, ALICE RIVER
Title	STAGE 6B AS-CONSTRUCTED SOIL EROSION & SEDIMENT CONTROL PLAN SHEET 2 OF 2

Status	AS CONSTRUCTED						
Datum	A.H.D	Date	6/11/2020	Scale	As Shown	Size	A1
Drawing Number	967192-CI-1612			Revision	A		

Rev.	Date	Description	Des.	Verif.	Appd.
A	6/11/2020	AS-CONSTRUCTED ISSUE	LL	JW	MB