




OPW24/0141
Townsville City Council
Accepted As Constructed
OPW24/0141
5/6/26

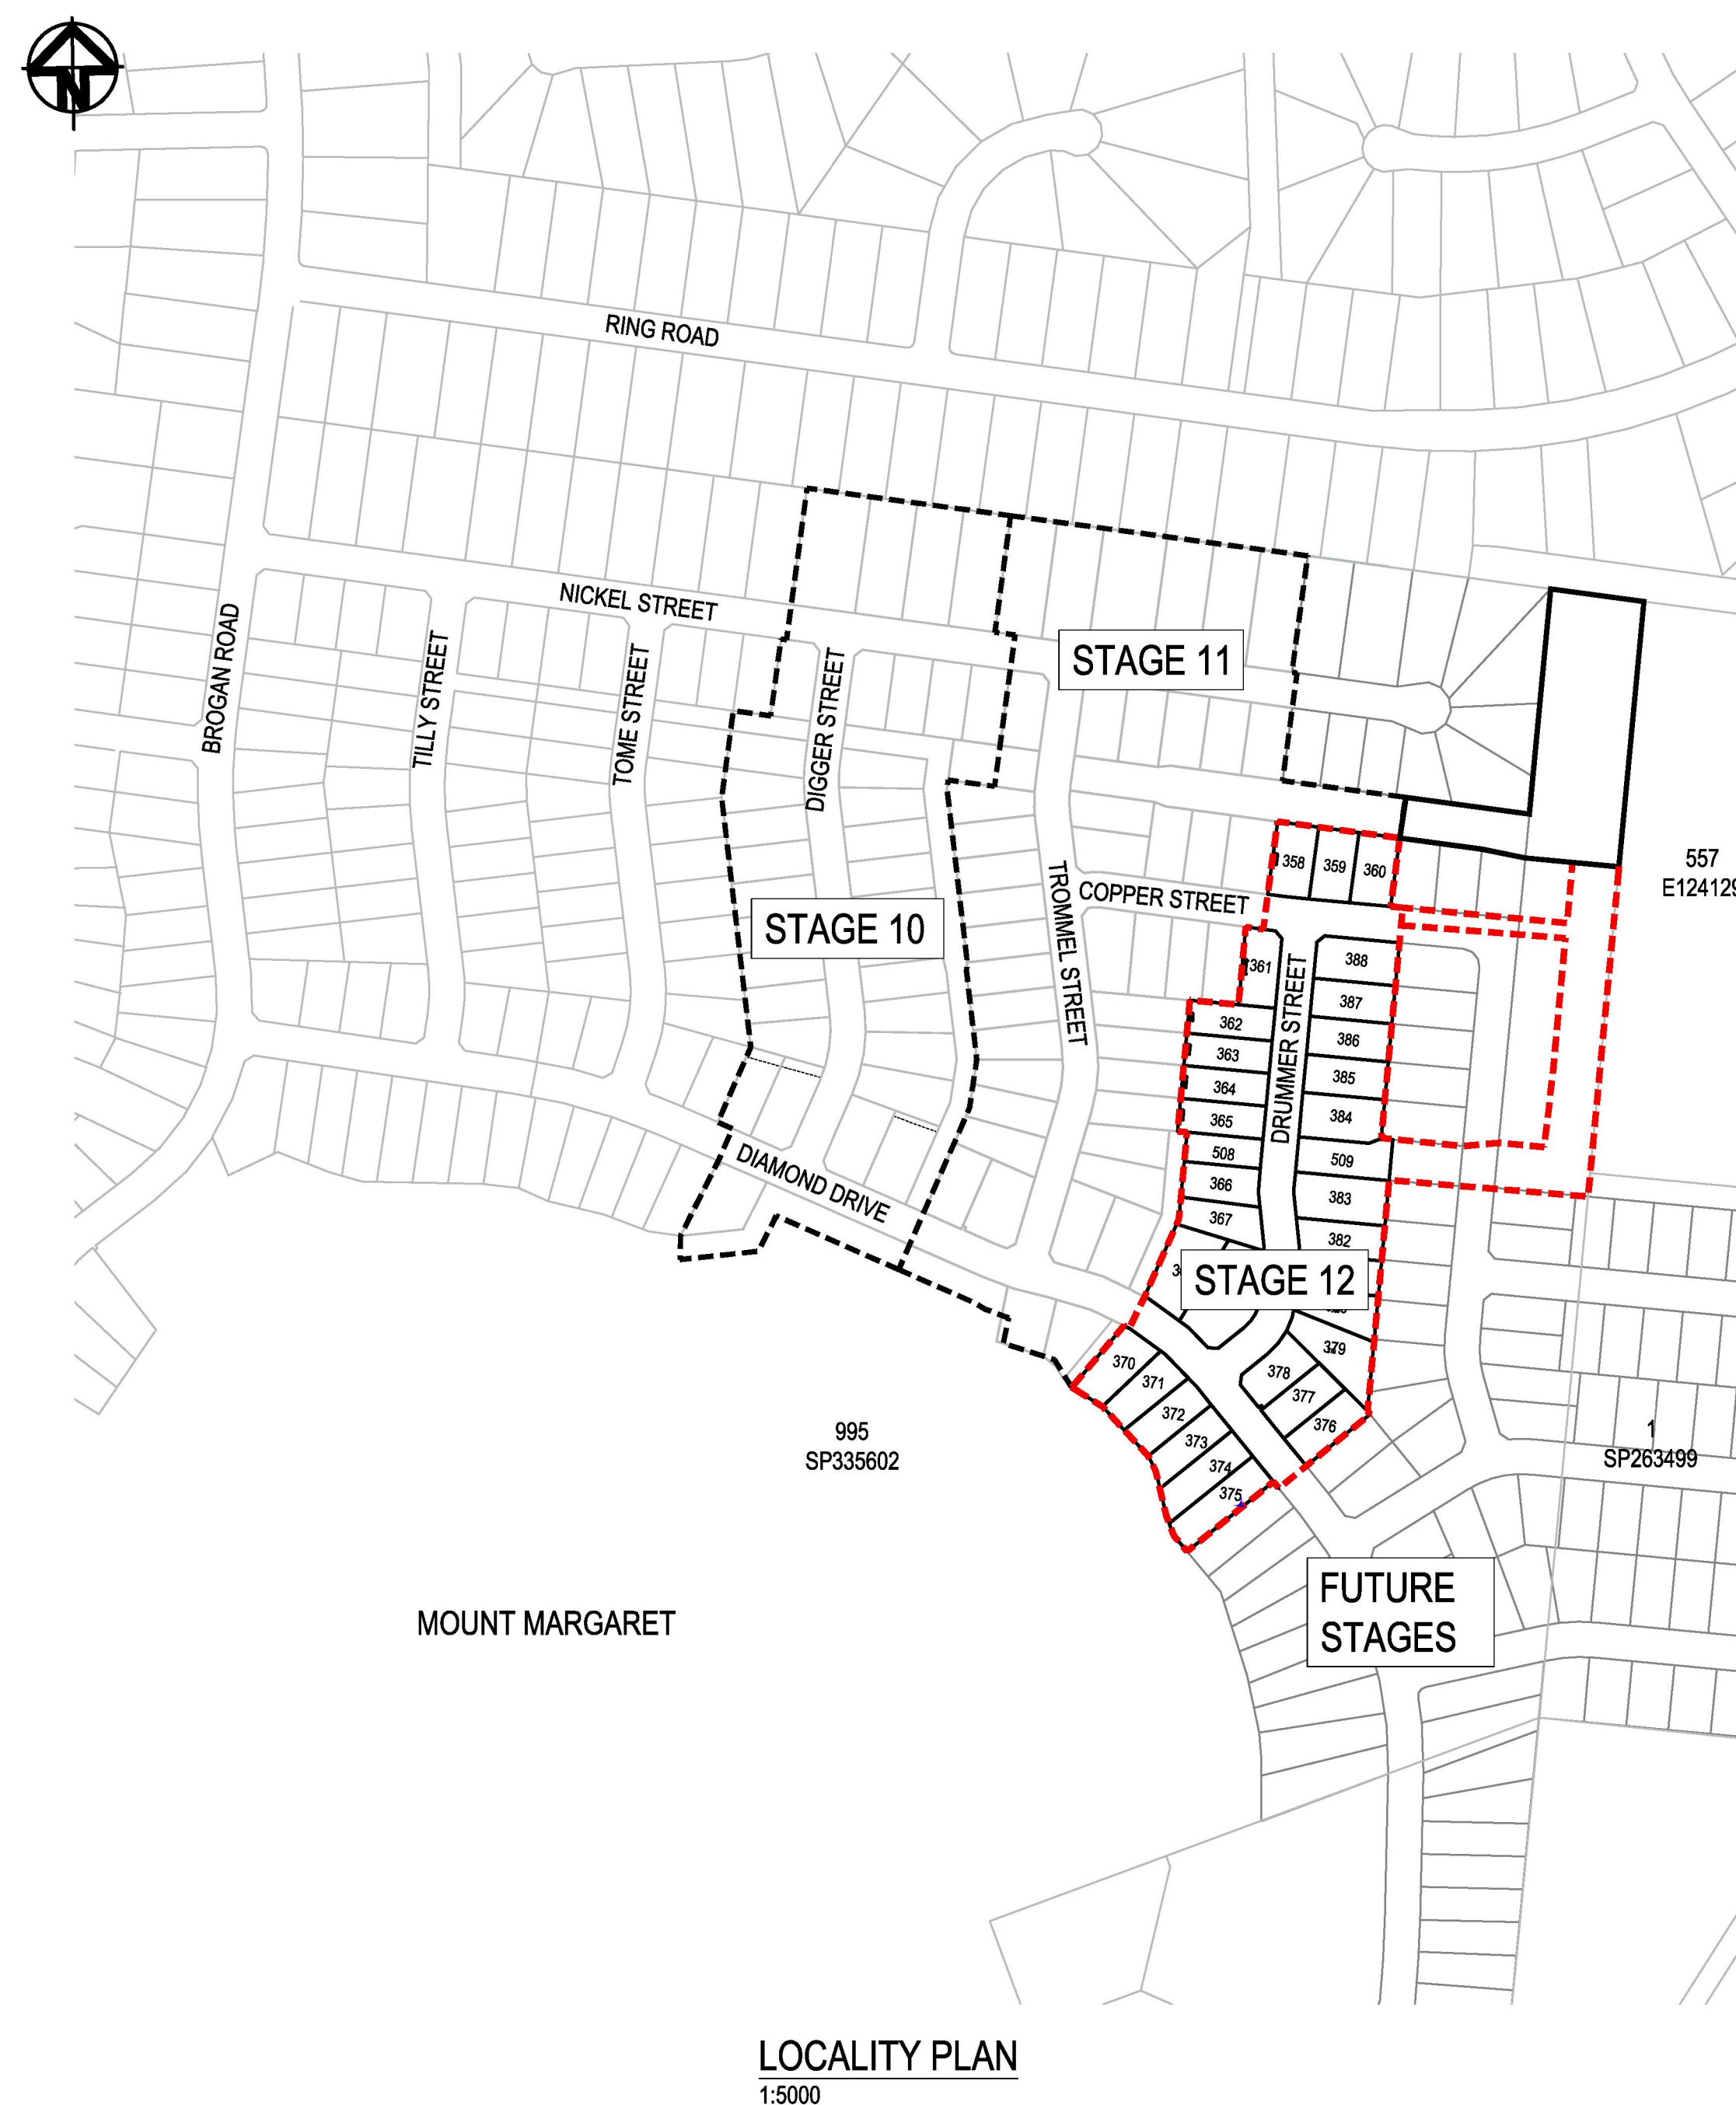

CIVIL ENGINEERING DRAWINGS		
Sheet Number	Sheet Title	Revised
ASC - C001	LOCALITY PLAN AND DRAWING INDEX	3
ASC - C051	EARTHWORKS, ROADWORKS AND DRAINAGE SHEET 1	1
ASC - C052	EARTHWORKS, ROADWORKS AND DRAINAGE SHEET 2	1
ASC - C053	EARTHWORKS, ROADWORKS AND DRAINAGE SHEET 3	1
ASC - C061	ROADS LONGITUDINAL SECTIONS SHEET 1	1
ASC - C062	ROADS LONGITUDINAL SECTIONS SHEET 2	1
ASC - C063	DRAINAGE CHANNEL LONGITUDINAL SECTION	1
ASC - C071	INTERSECTION SETOUT DETAILS SHEET 1	1
ASC - C072	INTERSECTION SETOUT DETAILS SHEET 2	1
ASC - C401	CULVERT LAYOUT AND LONGITUDINAL SECTIONS	1
ASC - C402	DRAINAGE DETAILS	1
ASC - C601	WATER RETICULATION LAYOUT PLAN	1

ROWLANDS SURVEYS PTY LTD, DO HEREBY CERTIFY THAT THIS
DRAWING ACCURATELY AND CORRECTLY DESCRIBES AND RECORDS
THE NATURE AND LOCATION OF THE WORKS DEPICTED BY
ASTERISKS (*) HEREON AS THEY HAVE BEEN CONSTRUCTED.

BJSK

BENJAMIN COOK (No. 4534)


22.05.2026
DATE

I, BRETT LANGTREE OF LANGTREE CONSULTING PTY LTD, HEREBY CERTIFY THAT THE WORKS AS SHOWN ON THE AS CONSTRUCTED DRAWINGS REFLECT ANY CHANGES THAT WERE MADE DURING THE COURSE OF CONSTRUCTION.

Badongtre

BRETT LANGTREE (RPEQ No. 11932)



22.05.2026
DATE

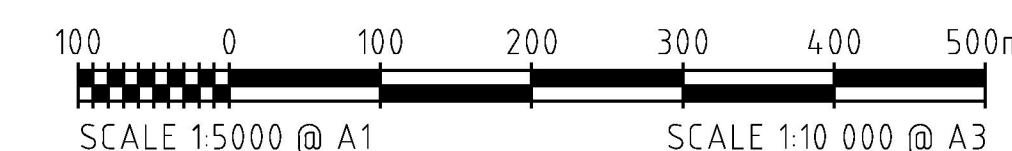

AS CONSTRUCTED

22 MAY 2026

REVISIONS	3	B.S	22.05.26	AS CONSTRUCTED	HORIZ. DATUM		MT MARGARET GRID		CERTIFICATION		 m0400 699 979 ebrett@langtreeconsulting.com.au	MT MARGARET ESTATE STAGE 12 - OPERATIONAL WORKS						SCALE	AS SHOWN			
	2	M.V.	20.01.25	FOR CONSTRUCTION	VERT. DATUM		AHD			SHEET								1 OF 12				
	1	J.C.	13.01.25	FOR CONSTRUCTION	DRG. FILE	0944	DATE		COPYRIGHT © These designs and drawings are copyright and are not to be used or reproduced without the written permission of LANGTREE CONSULTING PTY LTD (ACN 29 611 368 024). The contents of this drawing are electronically generated, are confidential and may only be used for the purpose for which they were intended. This is an uncontrolled document issued for information purposes only, unless the checked sections are signed and approved. Figured dimensions take precedence over scale. Do not scale from this drawing.	NICKEL STREET						REVISION	B	C	D	E	F	
	0	M.V.	10.10.25	FOR CONSTRUCTION	DESIGN	B.L.	NOV '24			ALICE RIVER, QLD, 4817						G	0	1	2	3		
	G	B.Y.	06.06.25	APPROVAL ISSUE - SURVEY UPDATE	DRAWN	C.B.P.	NOV '24			LOCALITY PLAN AND DRAWING INDEX						DRG No.	0944 - ASC - C001					
	No.	BY	DATE	DESCRIPTION																		

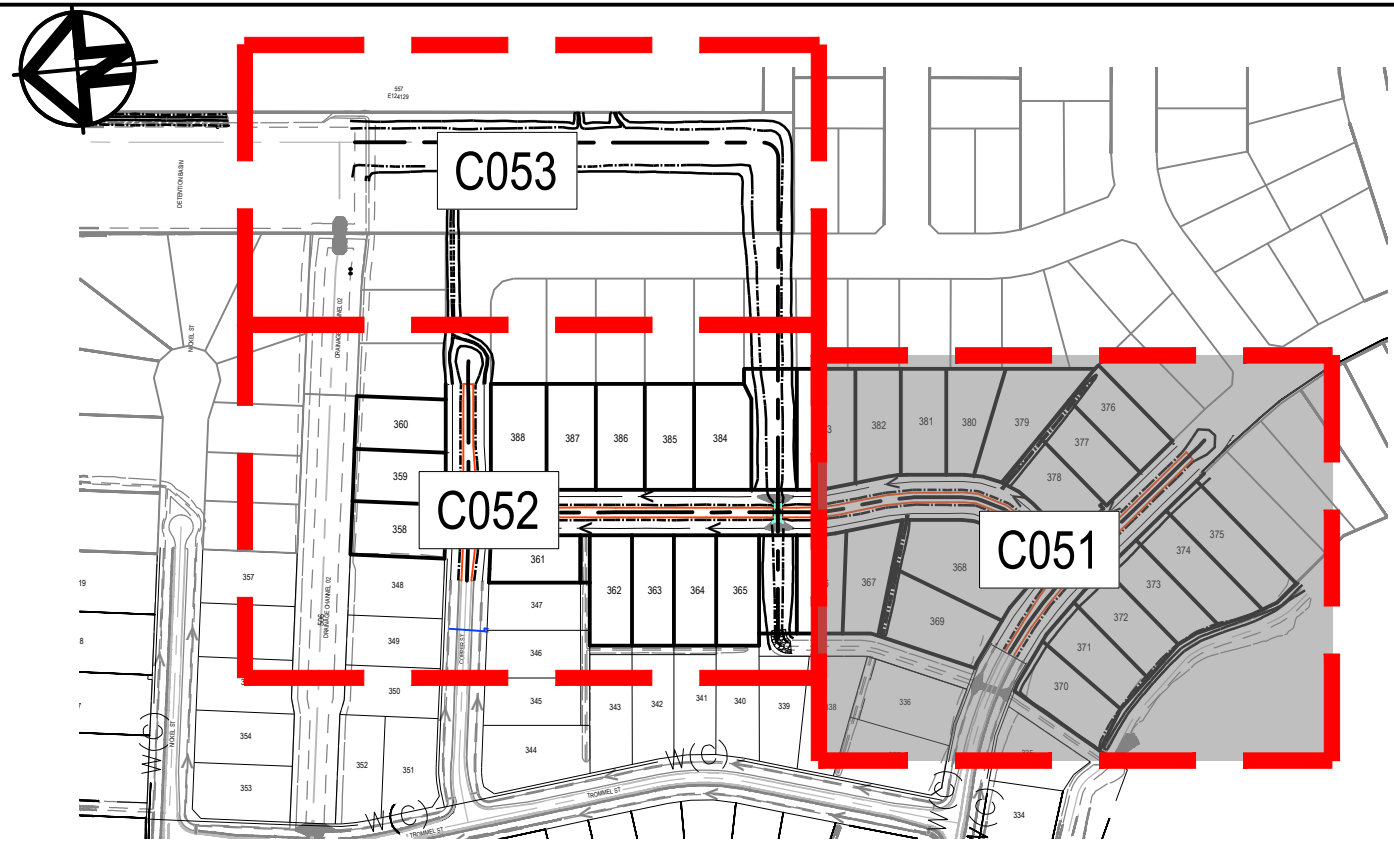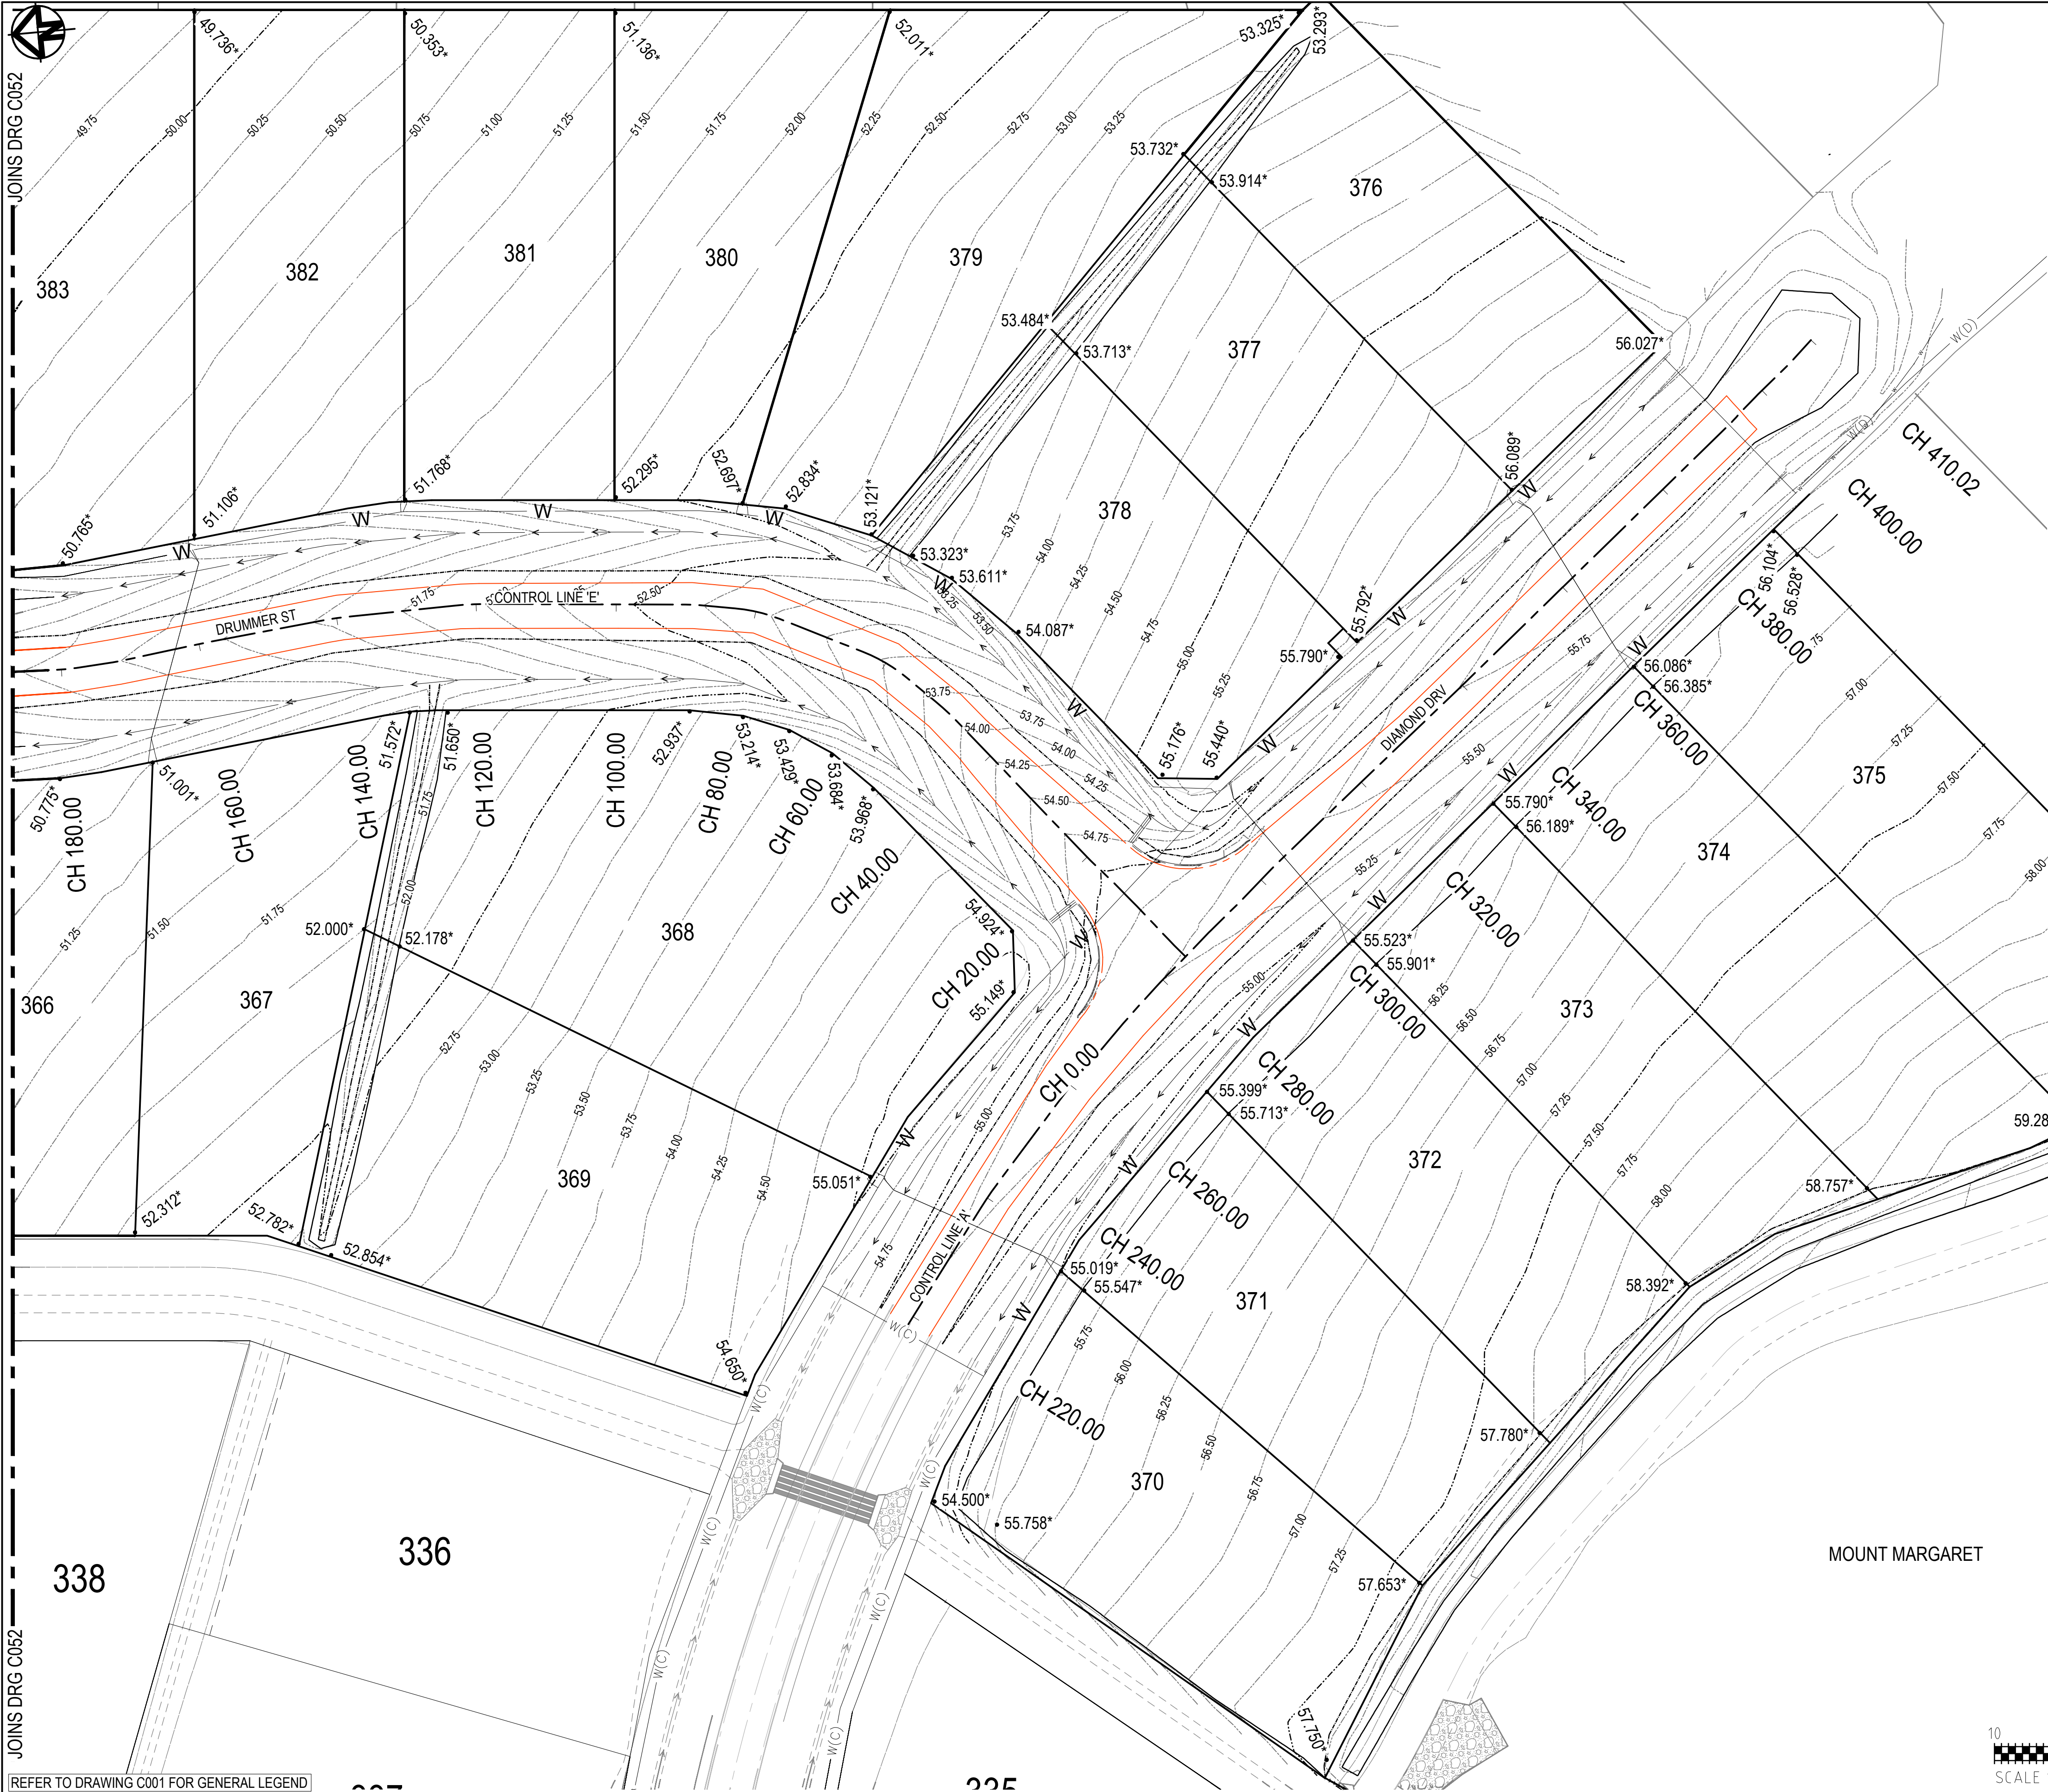

KEY PLAN
NTS

ASCON LEGEND:


- AS BUILT MINOR CONTOUR
- AS BUILT MAJOR CONTOUR
- AS BUILT EARTHWORKS LEVELS
- AS BUILT ROAD SEAL
- CONCRETE INVERT BUILT IN ACCORDANCE WITH TCC STANDARD DRAWING SD-020
- DUMP ROCK SCOUR PROTECTION

ROWLANDS SURVEYS PTY LTD, DO HEREBY CERTIFY THAT THIS DRAWING ACCURATELY AND CORRECTLY DESCRIBES AND RECORDS THE NATURE AND LOCATION OF THE WORKS DEPICTED BY ASTERISKS (*) HEREON AS THEY HAVE BEEN CONSTRUCTED.

B/C
BENJAMIN COOK (No. 4534) 22.05.2026
DATE

I, BRETT LANGTREE OF LANGTREE CONSULTING PTY LTD, HEREBY CERTIFY THAT THE WORKS AS SHOWN ON THE AS CONSTRUCTED DRAWINGS REFLECT ANY CHANGES THAT WERE MADE DURING THE COURSE OF CONSTRUCTION.

B. Langtree
BRETT LANGTREE (RPEQ No. 11932) 22.05.2026
DATE

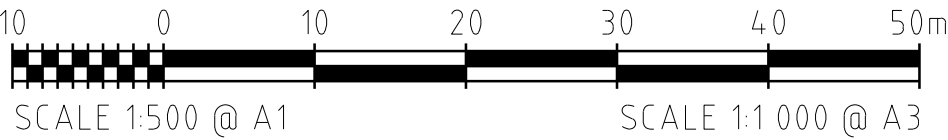

AS CONSTRUCTED
22 MAY 2026



REFER TO DRAWING C001 FOR GENERAL LEGEND

REVISIONS	No.	BY	DATE	DESCRIPTION	HORIZ. DATUM	MT MARGARET GRID	CERTIFICATION
	1	B.S	22.05.26	AS CONSTRUCTED	VERT. DATUM	AHD	COPYRIGHT © These designs and drawings are copyright and are not to be used or reproduced without the written permission of LANGTREE CONSULTING PTY LTD (ACN 29 611 368 024). The contents of this drawing are electronically generated, are confidential and may only be used for the purpose for which they were intended. This is an uncontrolled document issued for information purposes only, unless the checked sections are signed and approved. Figured dimensions take precedence over scale. Do not scale from this drawing.
	0	M.V.	10.10.25	FOR CONSTRUCTION	DRG. FILE	0944	
	E	B.L.	06.06.25	APPROVAL ISSUE - CONTOURS UPDATED	DESIGN	B.L.	
	D	B.L.	31.03.25	IAD CONTOURS ADDED	DRAWN	C.B.P.	
	C	B.L.	13.12.24	APPROVAL ISSUE - SURFACE LEVELS ADDED		NOV '24	
	No.	BY	DATE	DESCRIPTION		NOV '24	



MT MARGARET ESTATE STAGE 12 - OPERATIONAL WORKS
NICKEL STREET
ALICE RIVER, QLD, 4817
EARTHWORKS, ROADWORKS AND DRAINAGE SHEET 1

SCALE	1:500
SHEET	2 OF 12
REVISION	A B C D E 0 1
DRG No.	0944 - ASC - C051

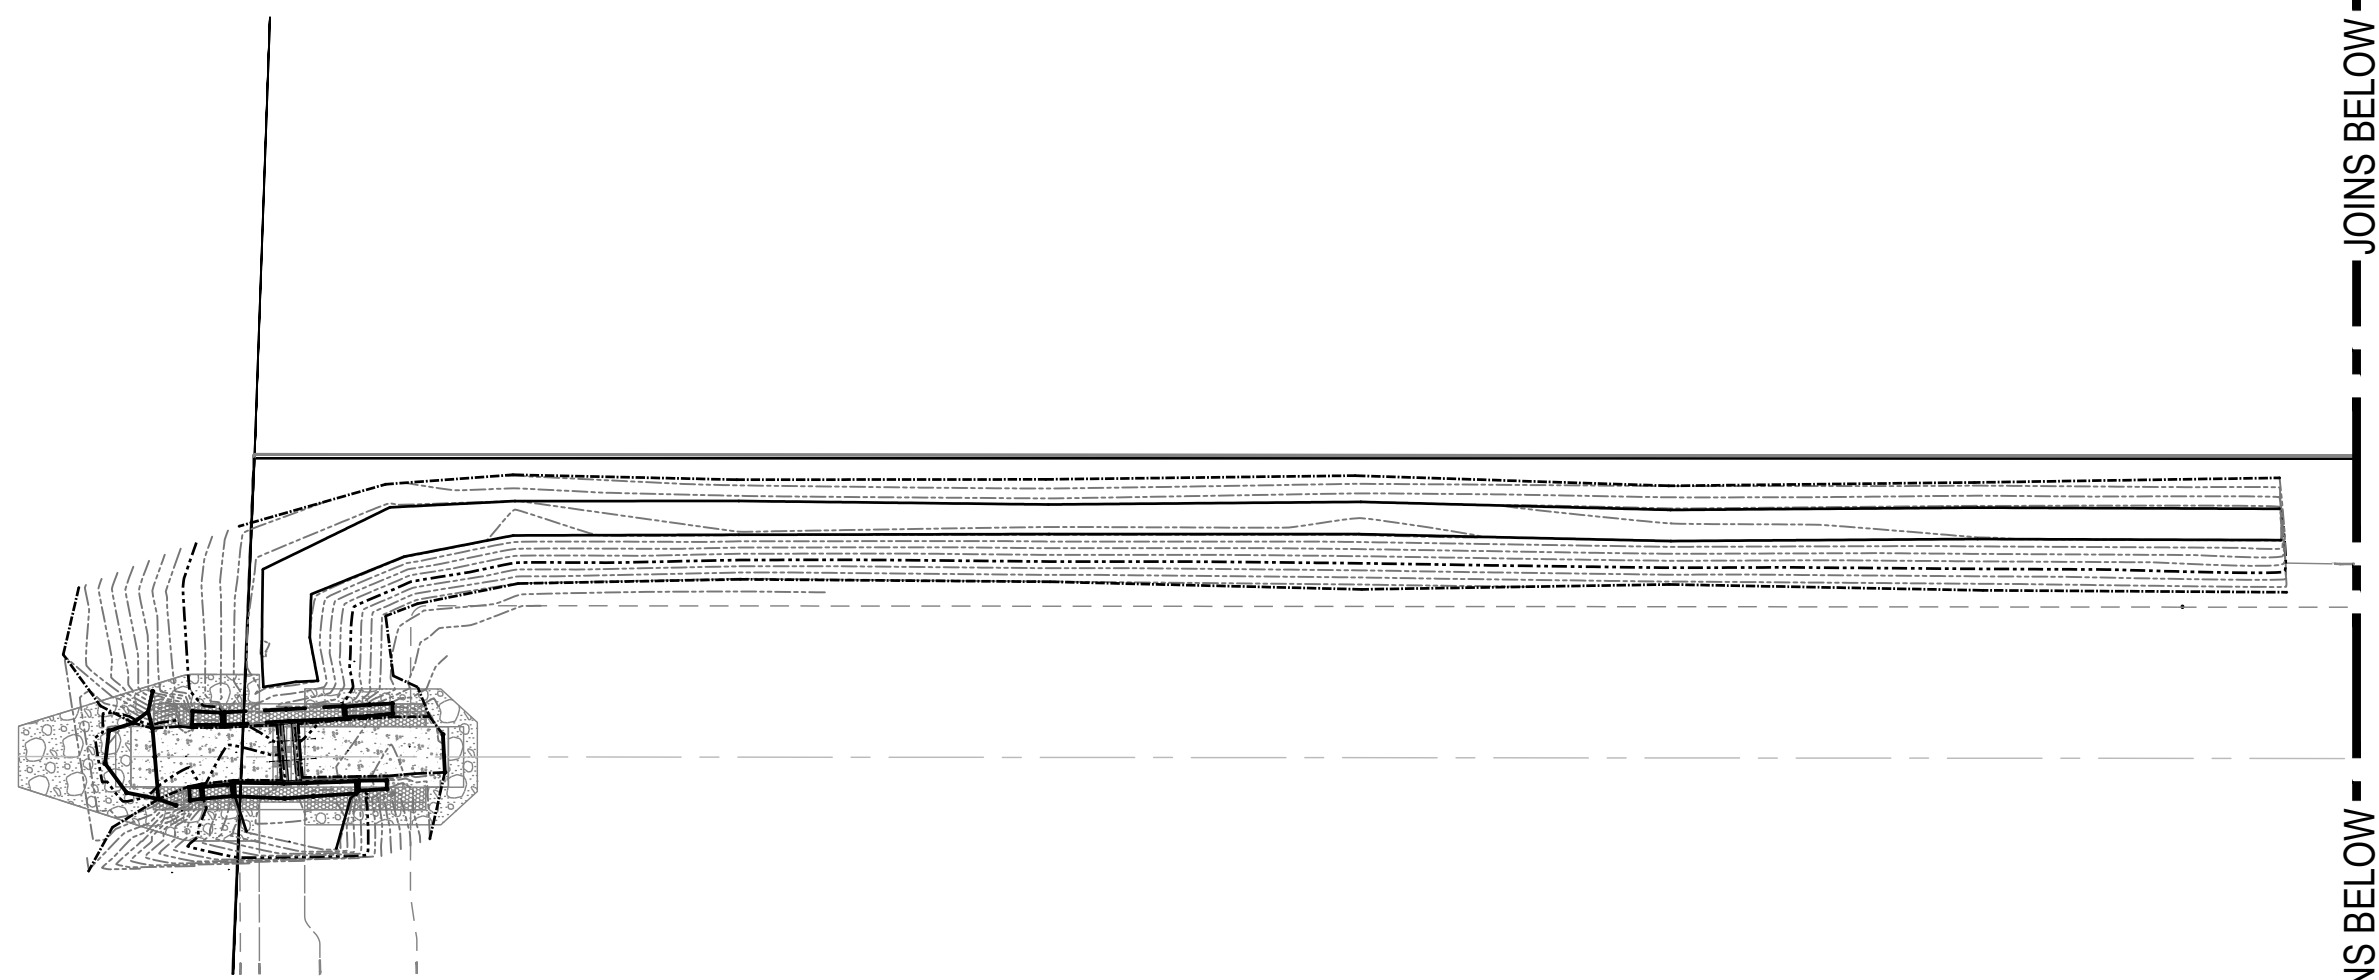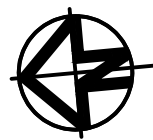

JOINS ABOVE

557
E124129

JOINS BELOW

ROWLANDS SURVEYS PTY LTD, DO HEREBY CERTIFY THAT THIS DRAWING ACCURATELY AND CORRECTLY DESCRIBES AND RECORDS THE NATURE AND LOCATION OF THE WORKS DEPICTED BY ASTERISKS (*) HEREON AS THEY HAVE BEEN CONSTRUCTED.


BK
BENJAMIN COOK (No. 4534) 15.05.2026
DATE

I, BRETT LANGTREE OF LANGTREE CONSULTING PTY LTD, HEREBY CERTIFY THAT THE WORKS AS SHOWN ON THE AS CONSTRUCTED DRAWINGS REFLECT ANY CHANGES THAT WERE MADE DURING THE COURSE OF CONSTRUCTION.



B. Langtree
BRETT LANGTREE (RPEQ No. 11932) 15.05.2026
DATE

ASCON LEGEND:

- AS BUILT MINOR CONTOUR
- AS BUILT MAJOR CONTOUR
- AS BUILT EARTHWORKS LEVELS
- AS BUILT ROAD SEAL
- CONCRETE INVERT BUILT IN ACCORDANCE WITH TCC STANDARD DRAWING SD-020
- DUMP ROCK SCOUR PROTECTION

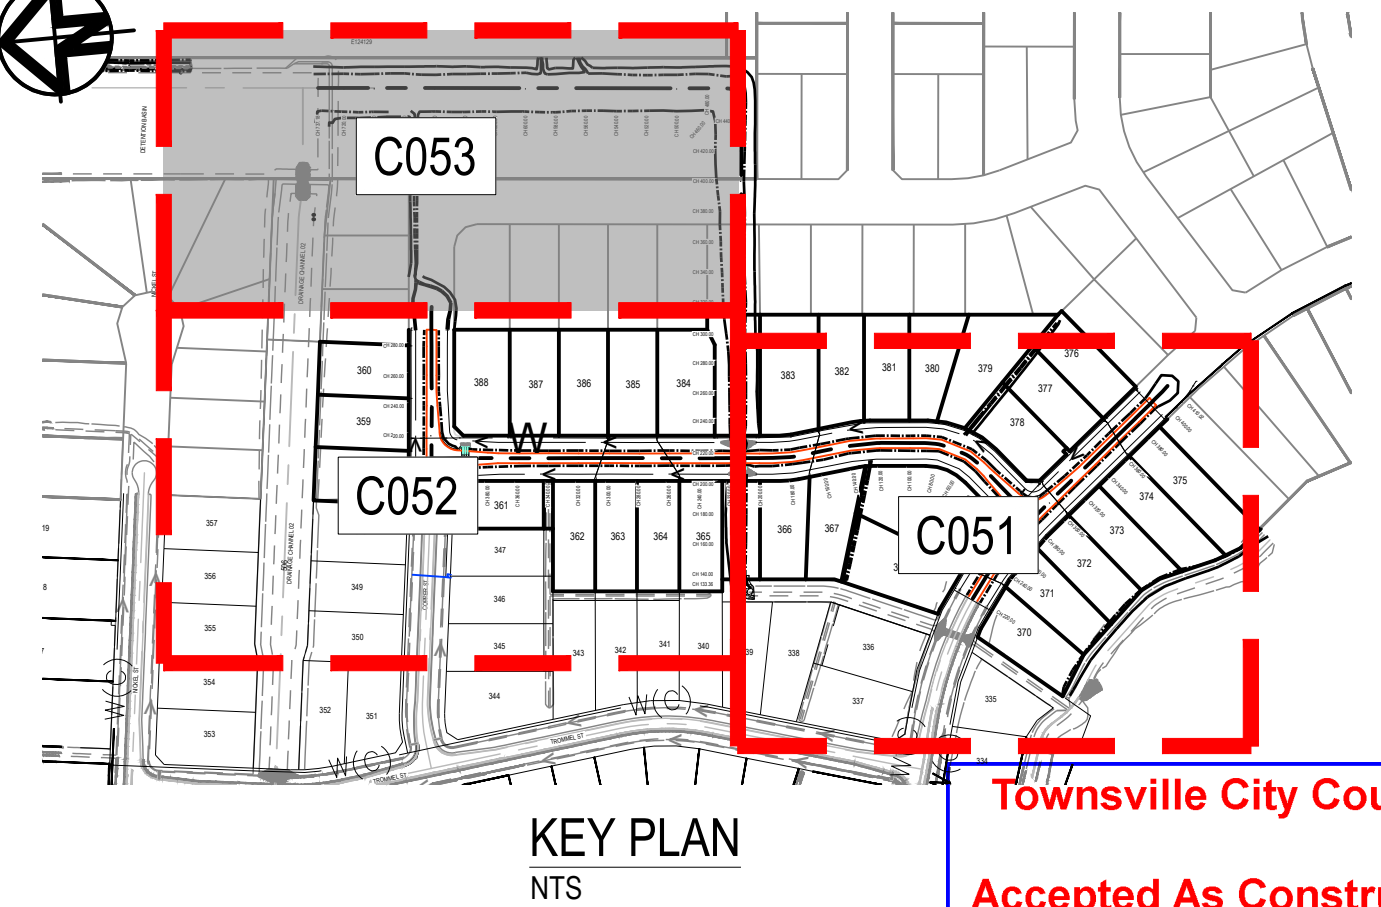


Townsville City Council
Accepted As Constructed
OPW24/0141
5/6/26

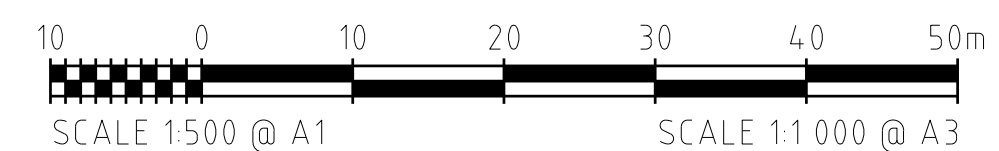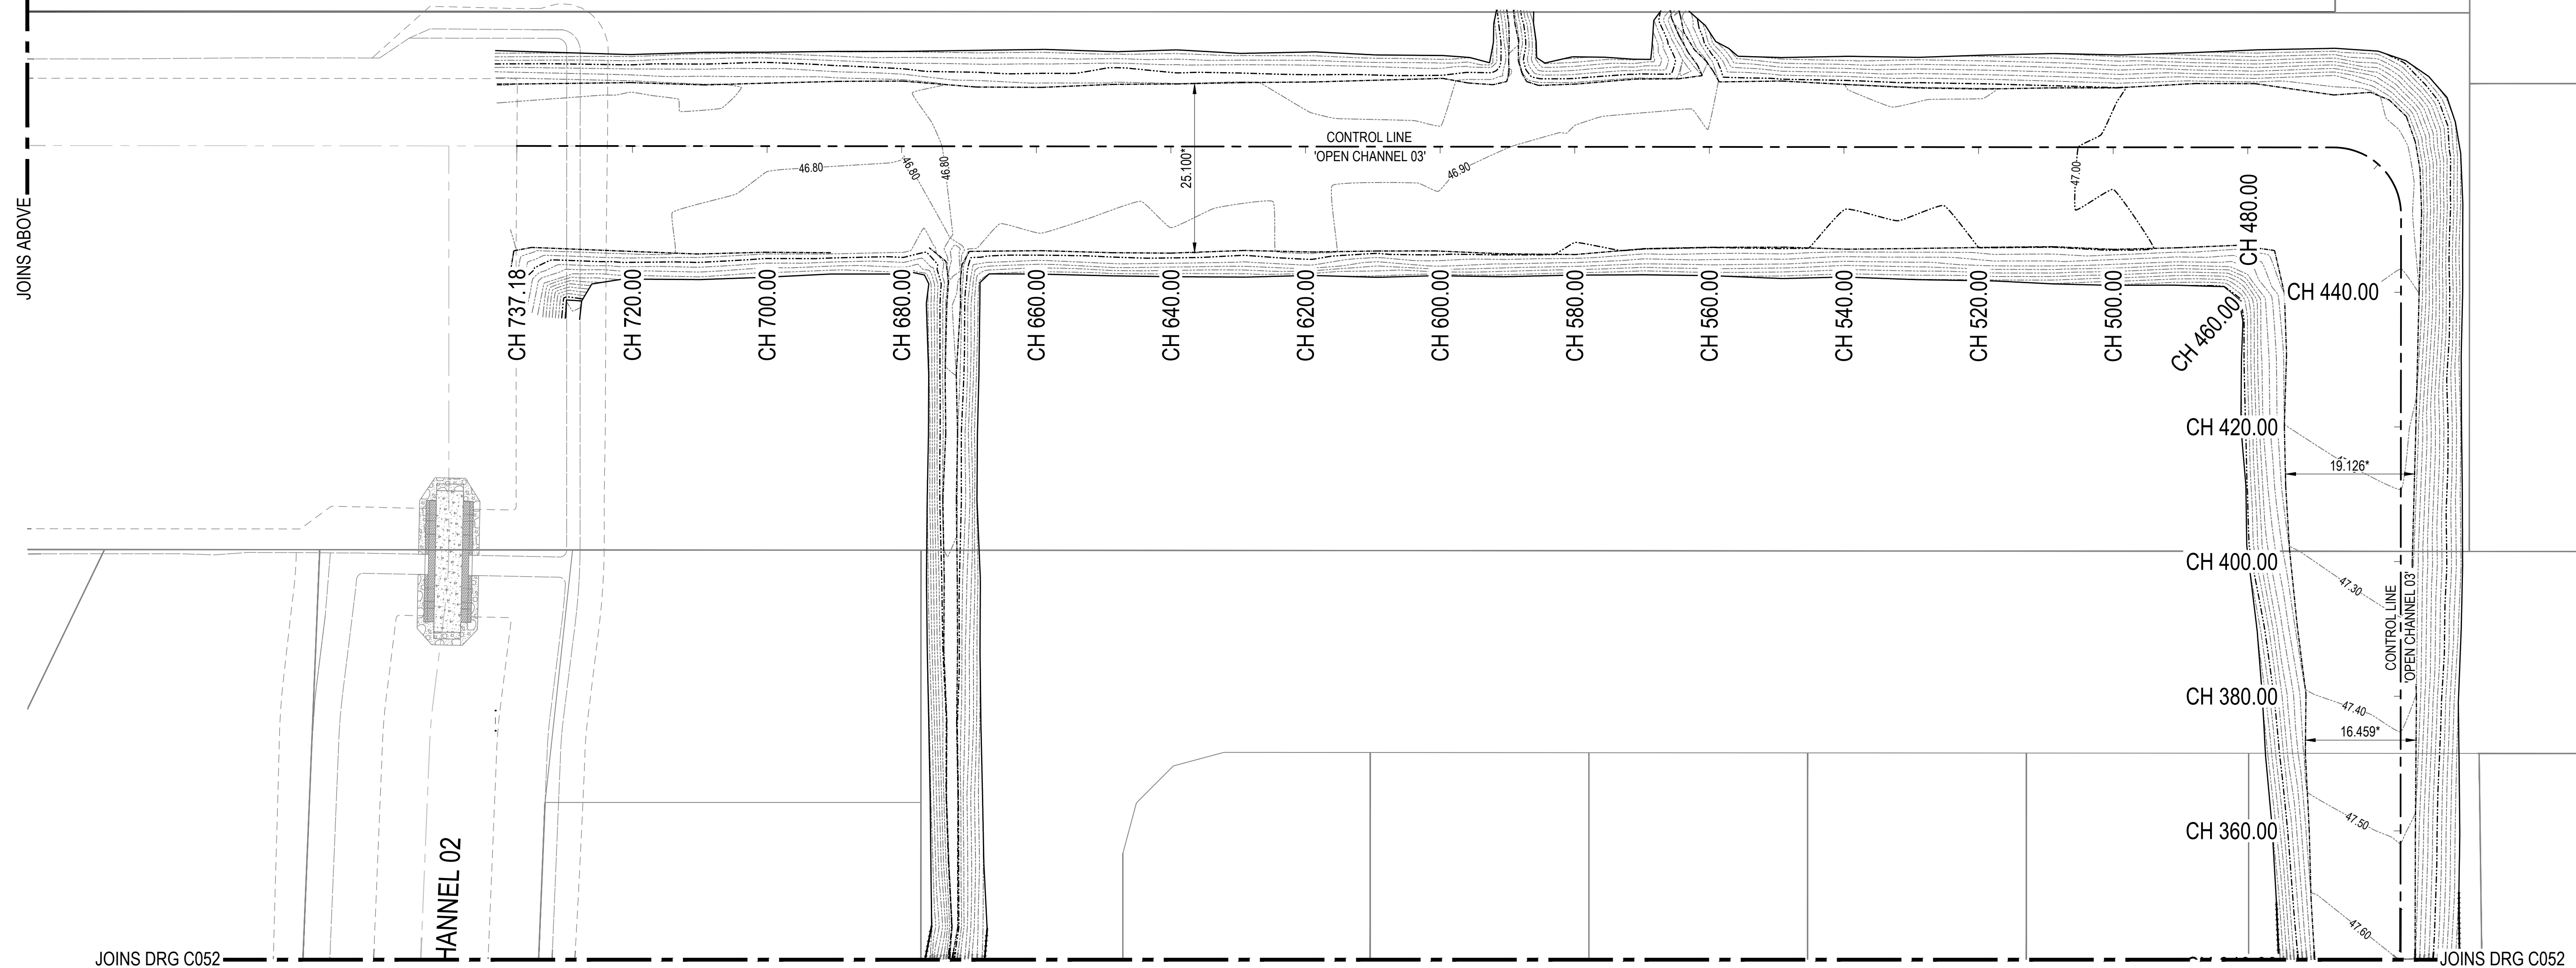


AS CONSTRUCTED
15TH MAY 2026

REFER TO DRAWING C001 FOR GENERAL LEGEND

REVISIONS	No.	BY	DATE	DESCRIPTION	HORIZ. DATUM	MT MARGARET GRID	CERTIFICATION	Langtree Consulting m 0400 699 979 e brett@langtreeconsulting.com.au	MT MARGARET ESTATE STAGE 12 - OPERATIONAL WORKS NICKEL STREET ALICE RIVER, QLD, 4817 EARTHWORKS, ROADWORKS AND DRAINAGE SHEET 3	SCALE	1:500
	1	B.S	15.05.26	AS CONSTRUCTED	VERT. DATUM	AHD	COPYRIGHT			SHEET	4 OF 12
	0	M.V.	10.10.25	FOR CONSTRUCTION	DRG. FILE	0944	DATE			REVISION	A B C 0 1
	C	B.L.	06.06.25	APPROVAL ISSUE - CONTOURS UPDATED	DESIGN	B.L.	NOV '24			DRG No.	0944 - ASC - C053
	B	B.L.	06.12.24	APPROVAL ISSUE							
	A	B.L.	18.11.24	PRELIMINARY ISSUE	DRAWN	C.B.P.	NOV '24				

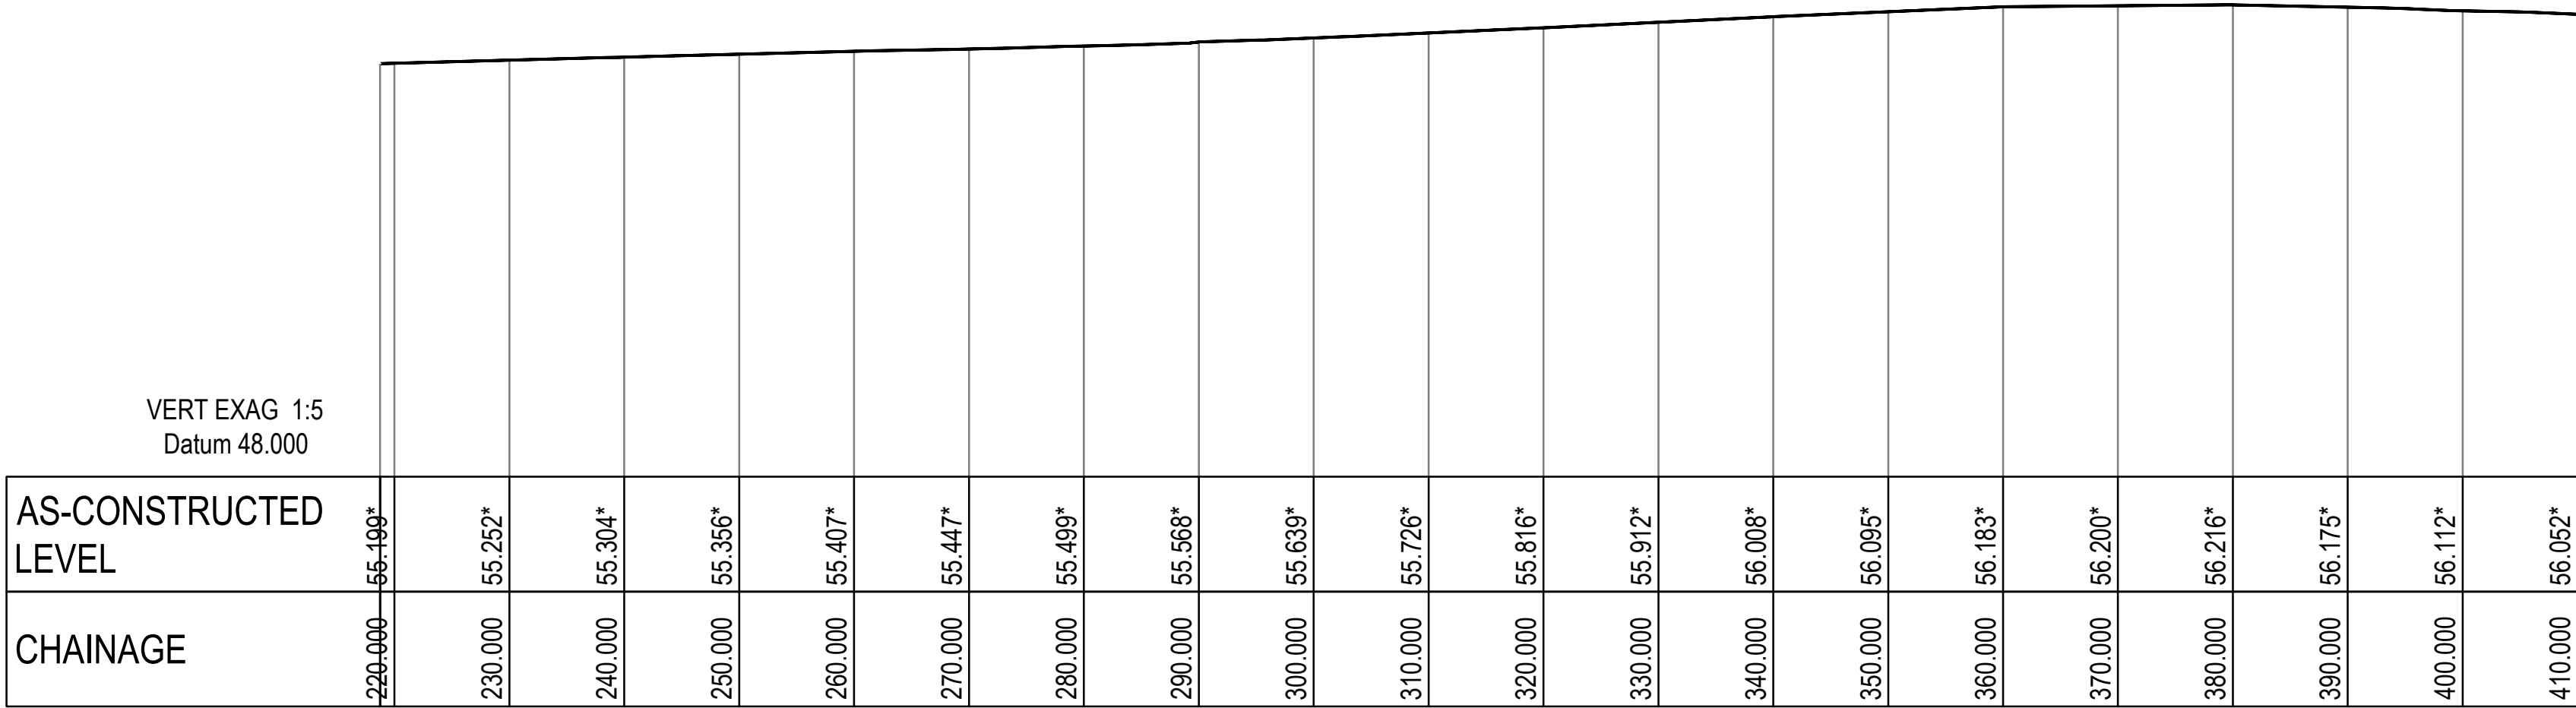

CONTROL LINE 'A' LONGITUDINAL SECTION: DIAMOND DRIVE
SCALE 1:500H 1:50V

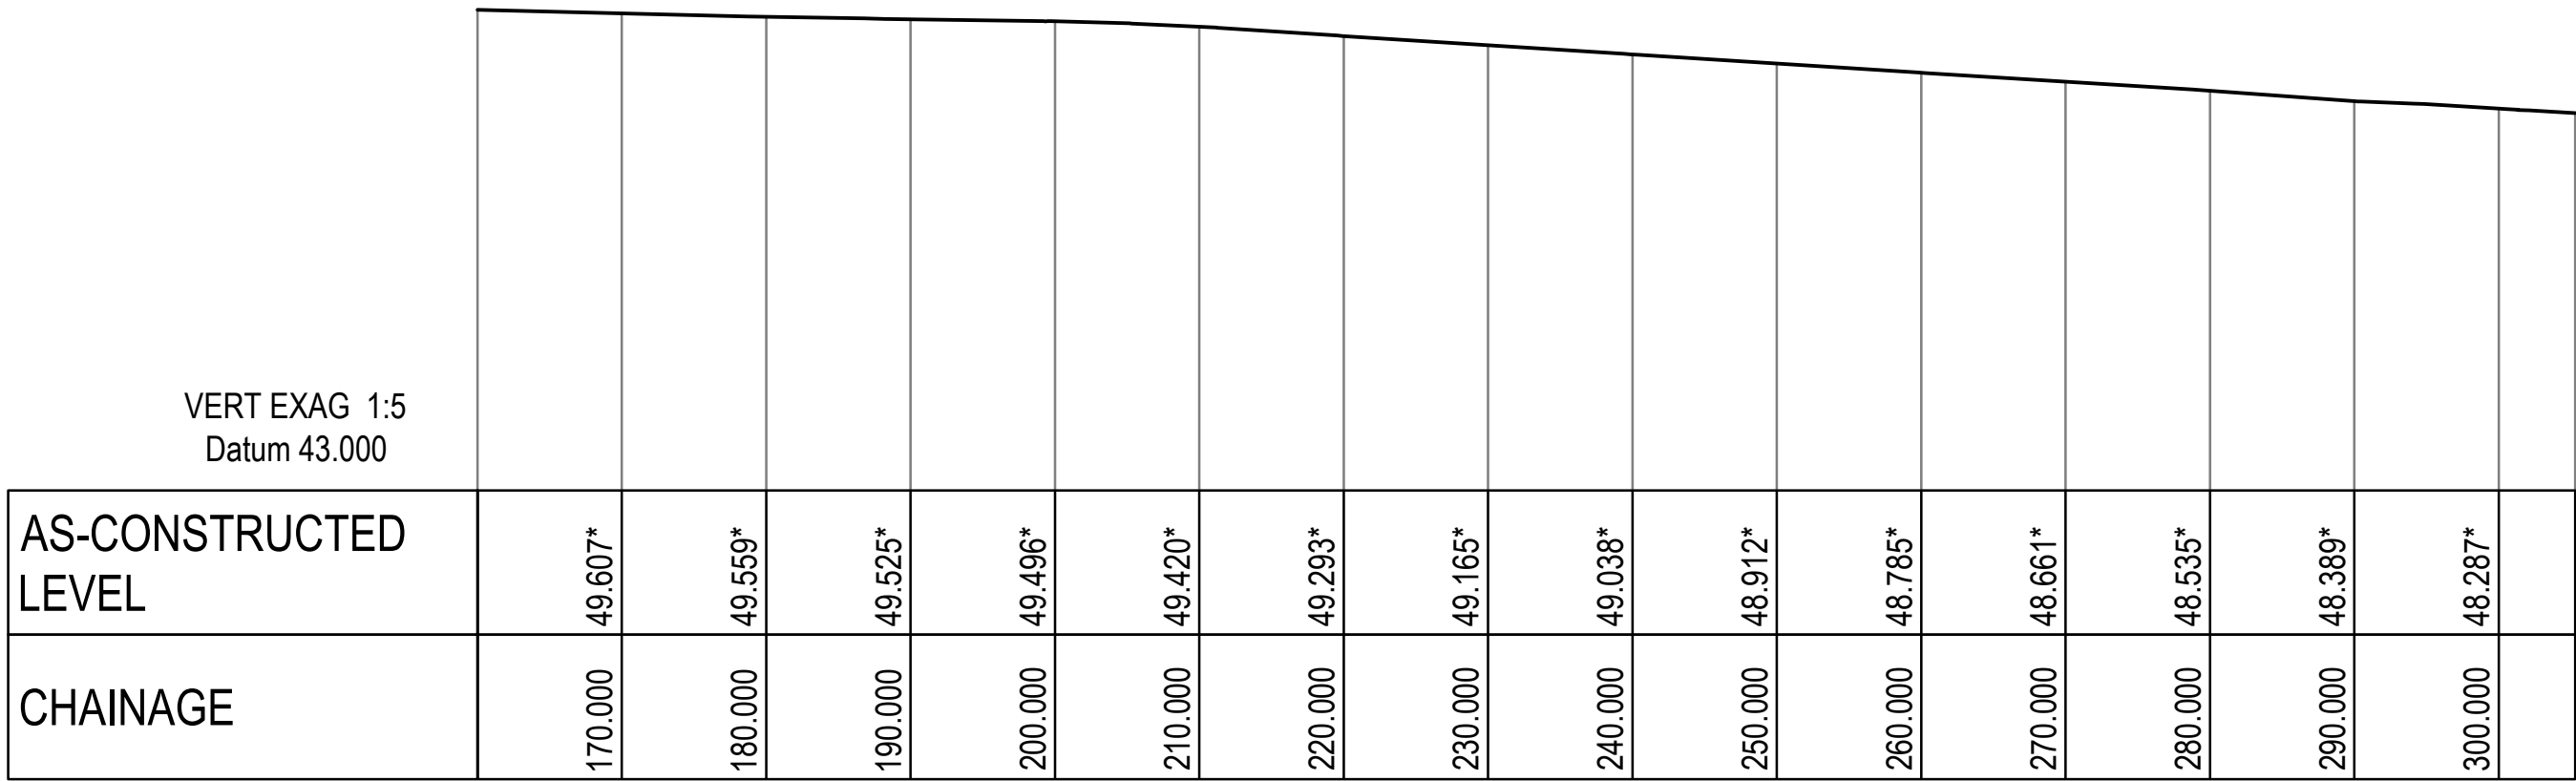

CONTROL LINE 'D' LONGITUDINAL SECTION: COPPER STREET
SCALE 1:500H 1:50V

Townsville City Council

Accepted As Constructed

OPW24/0141
5/6/26

ROWLANDS SURVEYS PTY LTD, DO HEREBY CERTIFY THAT THIS DRAWING ACCURATELY AND CORRECTLY DESCRIBES AND RECORDS THE NATURE AND LOCATION OF THE WORKS DEPICTED BY ASTERISKS (*) HEREON AS THEY HAVE BEEN CONSTRUCTED.

BK

22.05.2026
DATE


BENJAMIN COOK (No. 4534)

I, BRETT LANGTREE OF LANGTREE CONSULTING PTY LTD, HEREBY CERTIFY THAT THE WORKS AS SHOWN ON THE AS CONSTRUCTED DRAWINGS REFLECT ANY CHANGES THAT WERE MADE DURING THE COURSE OF CONSTRUCTION.

B. Langtree

22.05.2026
DATE

BRETT LANGTREE (RPEQ No. 11932)

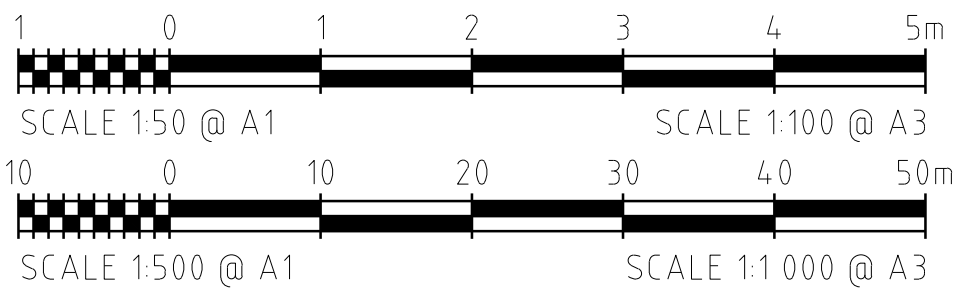


AS CONSTRUCTED


22 MAY 2026

REFER TO DRAWING C002 FOR ROAD SETOUT


REVISIONS	1	B.S	22.05.26	AS CONSTRUCTED	HORIZ. DATUM		MT MARGARET GRID		CERTIFICATION	 m e 0400 699 979 brett@langtreeconsulting.com.au	MT MARGARET ESTATE STAGE 12 - OPERATIONAL WORKS						SCALE	AS SHOWN				
	0	M.V.	10.10.25	FOR CONSTRUCTION	VERT. DATUM		AHD				NICKEL STREET ALICE RIVER, QLD, 4817 ROADS LONGITUDINAL SECTIONS SHEET 1	SHEET	5 OF 12									
	D	B.L.	17.03.25	APPROVAL ISSUE - TEXT UPDATED	DRG. FILE	0944	DATE	COPYRIGHT © These designs and drawings are copyright and are not to be used or reproduced without the written permission of LANGTREE CONSULTING PTY LTD (ACN 29 611 388 024). The contents of this drawing are electronically generated, are confidential and may only be used for the purpose for which they were intended. This is an uncontrolled document issued for information purposes only, unless the checked sections are signed and approved. Figured dimensions take precedence over scale. Do not scale from this drawing.				REVISION	A	B	C	D	0					
	C	B.L.	13.12.24	APPROVAL ISSUE - TEXT REMOVED					1													
	B	B.L.	06.12.24	APPROVAL ISSUE	DESIGN	B.L.	NOV '24		DRG No.				0944 - ASC - C061									
	No.	BY	DATE	DESCRIPTION	DRAWN	C.B.P.	NOV '24															

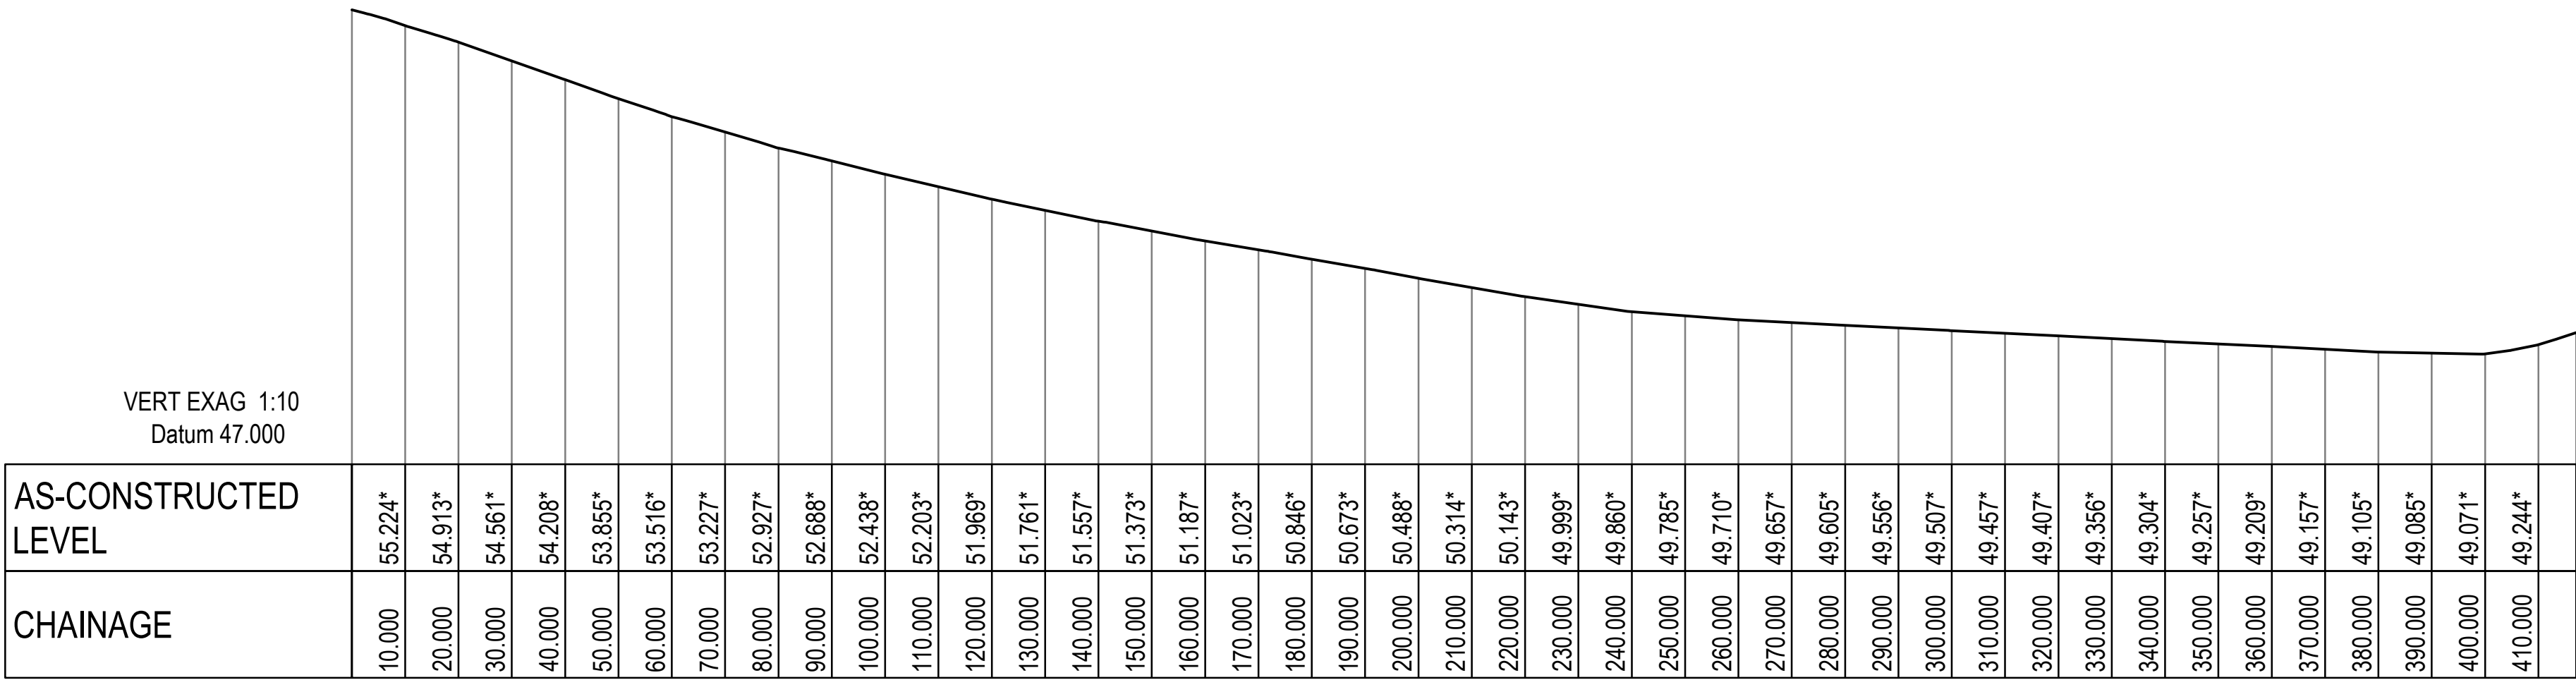


DRUMMER STREET LONGITUDINAL SECTION
SCALE 1:1000H 1:100V

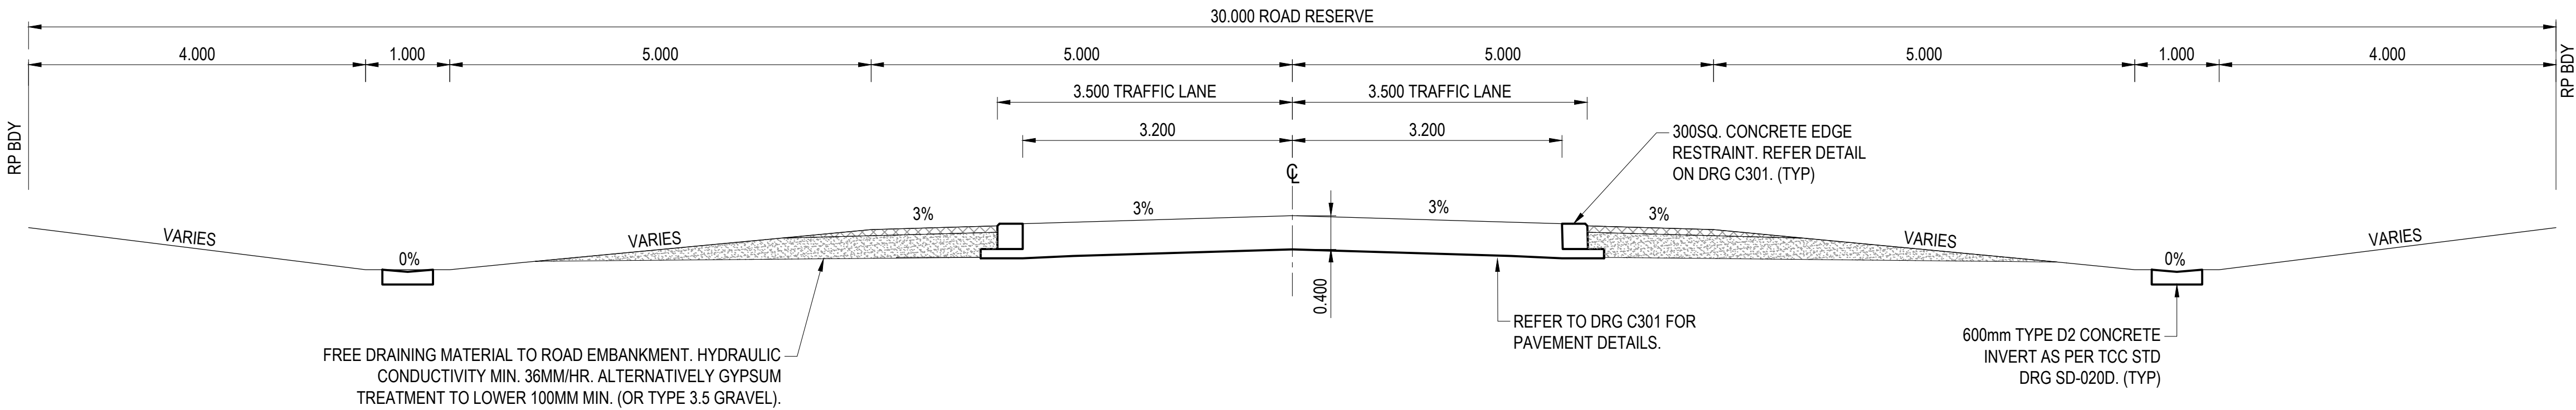

TYPICAL ROAD CROSS SECTION
SCALE 1:50

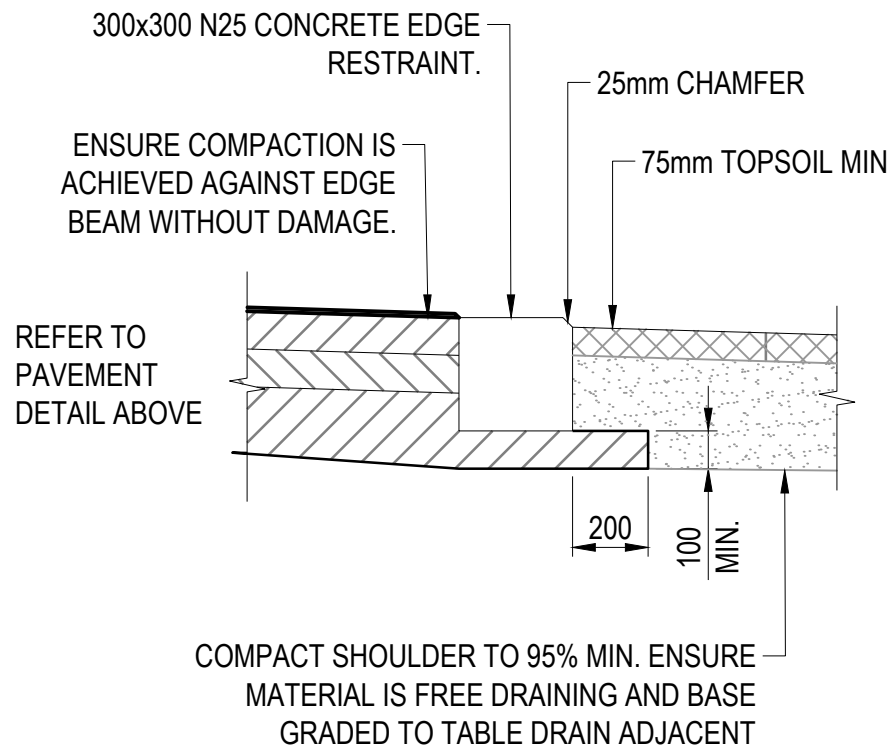

CONCRETE EDGE RESTRAINT DETAIL
NTS

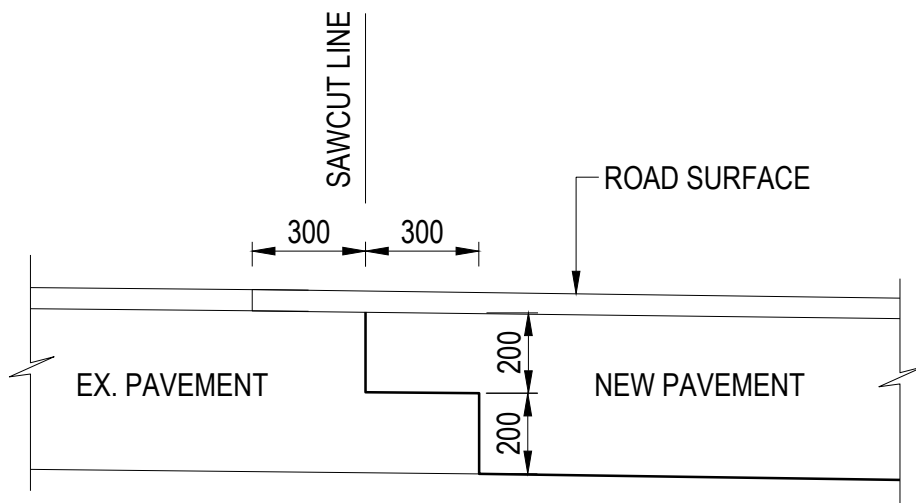

PAVEMENT CUT BACK DETAIL
NTS

ROWLANDS SURVEYS PTY LTD, DO HEREBY CERTIFY THAT THIS DRAWING ACCURATELY AND CORRECTLY DESCRIBES AND RECORDS THE NATURE AND LOCATION OF THE WORKS DEPICTED BY ASTERISKS (*) HEREON AS THEY HAVE BEEN CONSTRUCTED.

BAC

BENJAMIN COOK (No. 4534)




22.05.2026
DATE

I, BRETT LANGTREE OF LANGTREE CONSULTING PTY LTD, HEREBY CERTIFY THAT THE WORKS AS SHOWN ON THE AS CONSTRUCTED DRAWINGS REFLECT ANY CHANGES THAT WERE MADE DURING THE COURSE OF CONSTRUCTION.

B. Langtree

BRETT LANGTREE (RPEQ No. 11932)

22.05.2026
DATE

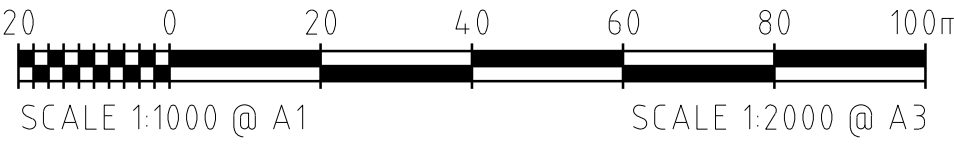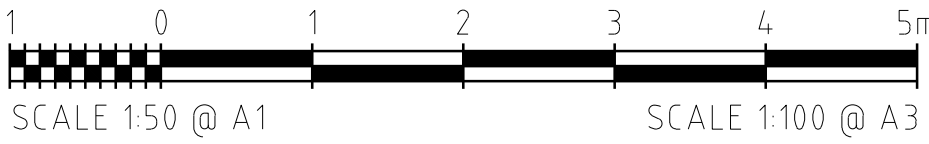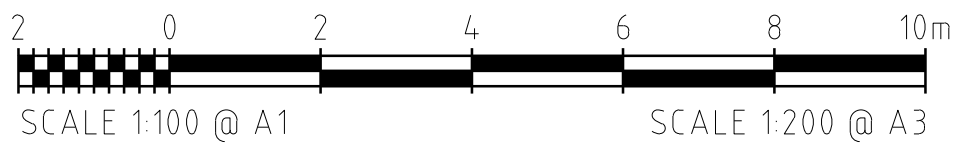

AS CONSTRUCTED

22 MAY 2026

REFER TO DRAWING C002 FOR ROAD SETOUT

REVISIONS	1	B.S	22.05.26	AS CONSTRUCTED	HORIZ. DATUM		MT MARGARET GRID		CERTIFICATION
	0	M.V.	10.10.25	FOR CONSTRUCTION	VERT. DATUM		AHD		
	C	B.L.	17.03.25	APPROVAL ISSUE - MINOR TEXT UPDATES	DRG. FILE		0944	DATE	
	B	B.L.	06.12.24	APPROVAL ISSUE	DESIGN		B.L.	NOV '24	COPYRIGHT © These designs and drawings are copyright and are not to be used or reproduced without the written permission of LANGTREE CONSULTING PTY LTD (ACN 29 611 388 024). The contents of this drawing are electronically generated, are confidential and may only be used for the purpose for which they were intended. This is an uncontrolled document issued for information purposes only, unless the checked sections are signed and approved. Figured dimensions take precedence over scale. Do not scale from this drawing.
	A	B.L.	18.11.24	PRELIMINARY ISSUE	DRAWN		C.B.P.	NOV '24	
	No.	BY	DATE	DESCRIPTION					



m 0400 699 979
e brett@langtreeconsulting.com.au

MT MARGARET ESTATE STAGE 12 - OPERATIONAL WORKS


NICKEL STREET
ALICE RIVER, QLD, 4817
ROADS LONGITUDINAL SECTIONS SHEET 2

SCALE AS SHOWN


SHEET 6 OF 12

REVISION A B C 0 1

DRG No. 0944 - ASC - C062

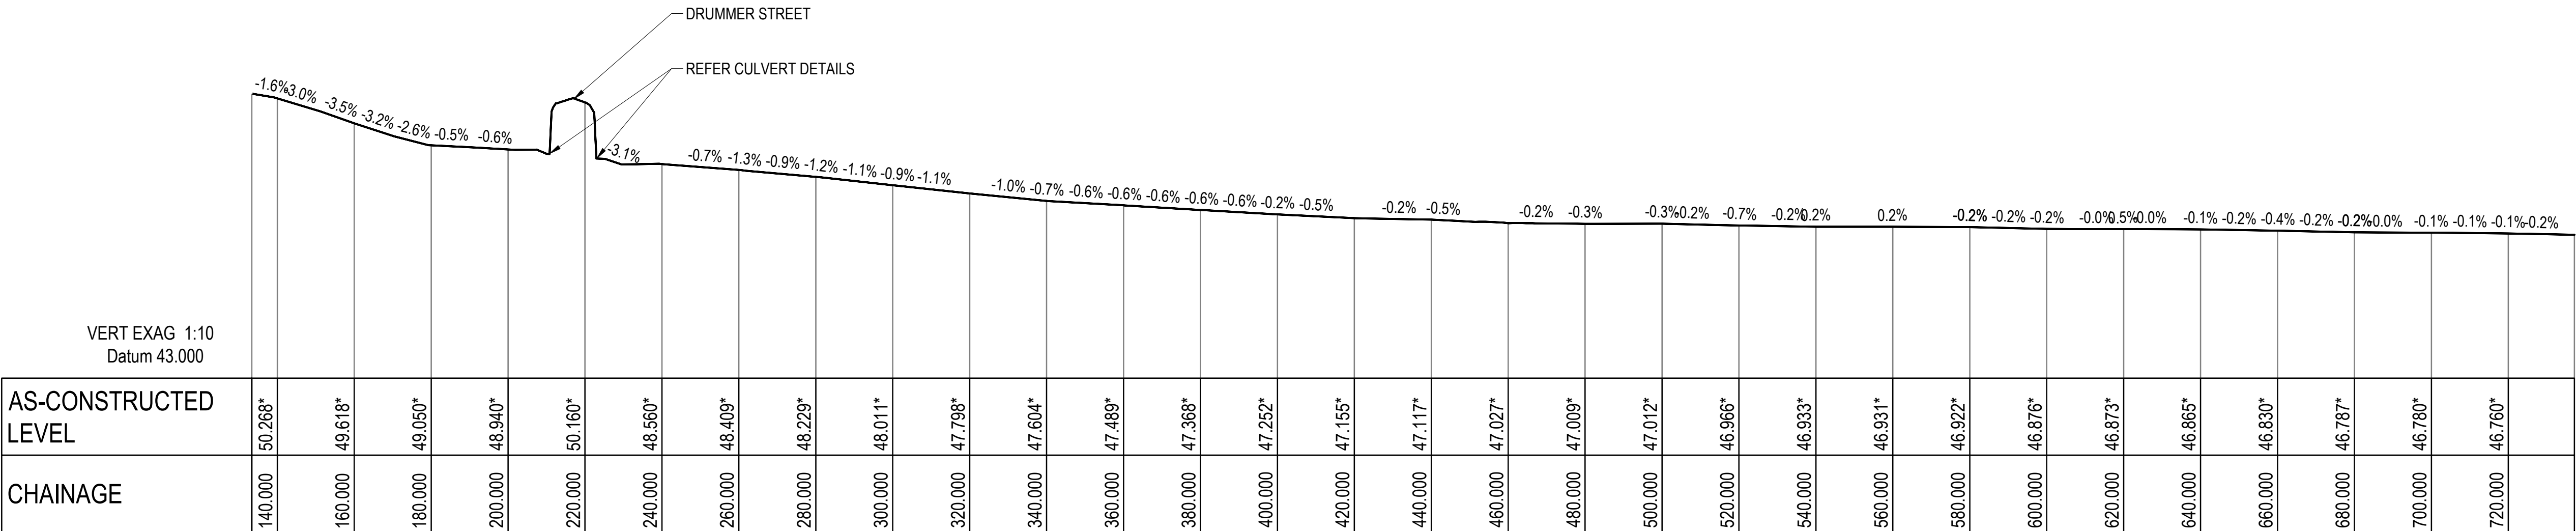

OPEN CHANNEL 03 LONGITUDINAL SECTION
SCALE 1:1000H 1:100V

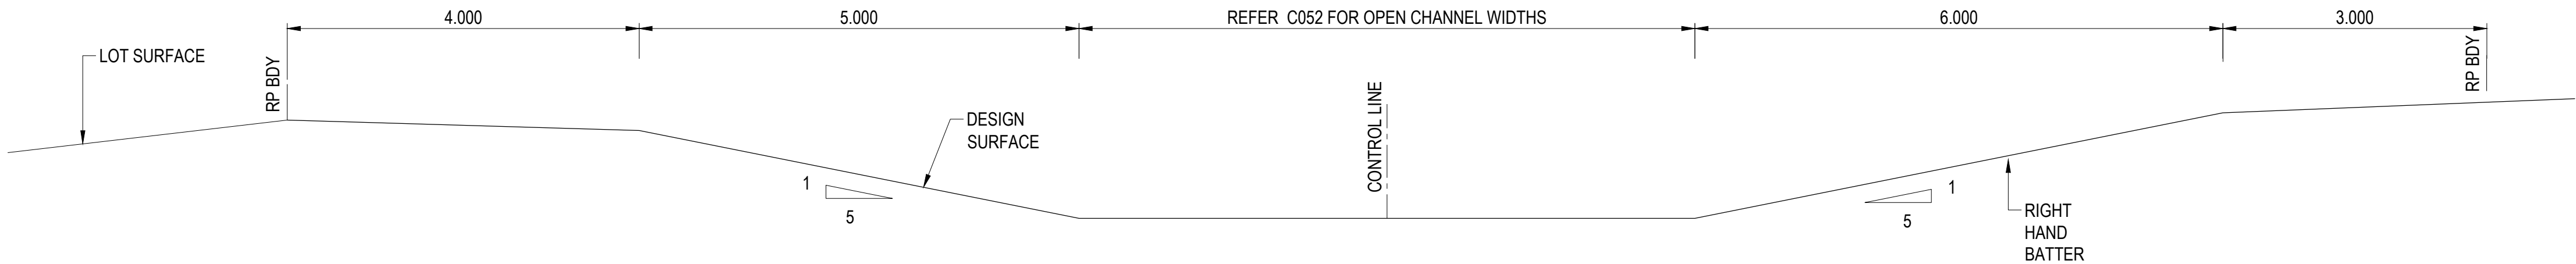

OPEN CHANNEL 03 - TYPICAL SECTION
SCALE 1:50

ROWLANDS SURVEYS PTY LTD, DO HEREBY CERTIFY THAT THIS DRAWING ACCURATELY AND CORRECTLY DESCRIBES AND RECORDS THE NATURE AND LOCATION OF THE WORKS DEPICTED BY ASTERISKS (*) HEREON AS THEY HAVE BEEN CONSTRUCTED.

BK

22.05.2026
DATE


BENJAMIN COOK (No. 4534)

I, BRETT LANGTREE OF LANGTREE CONSULTING PTY LTD, HEREBY CERTIFY THAT THE WORKS AS SHOWN ON THE AS CONSTRUCTED DRAWINGS REFLECT ANY CHANGES THAT WERE MADE DURING THE COURSE OF CONSTRUCTION.

B. Langtree

22.05.2026
DATE

BRETT LANGTREE (RPEQ No. 11932)

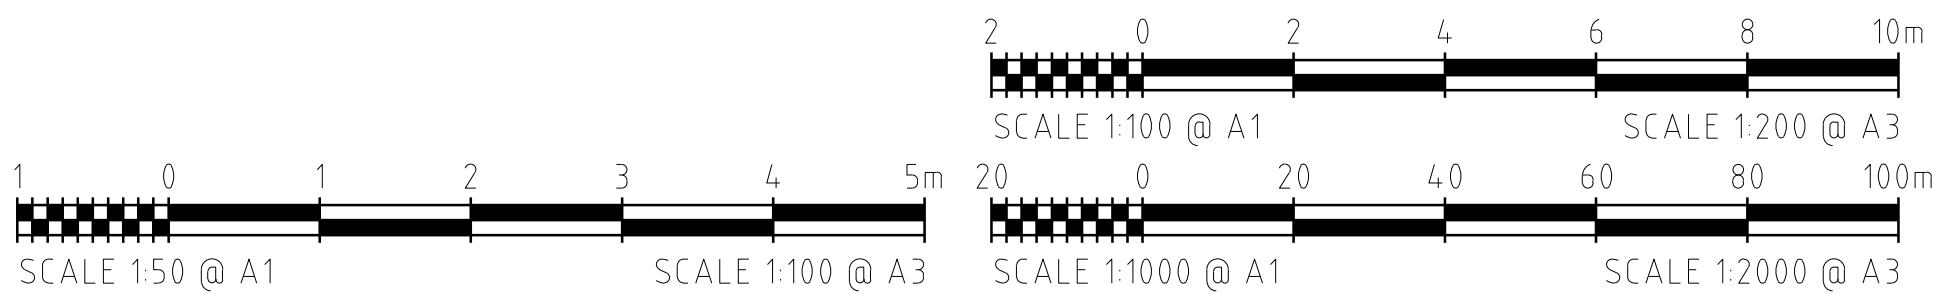


REFER TO DRAWING C002 FOR ROAD SETOUT

REVISIONS	1	B.S	22.05.26	AS CONSTRUCTED	HORIZ. DATUM		MT MARGARET GRID		CERTIFICATION
	0	M.V.	10.10.25	FOR CONSTRUCTION	VERT. DATUM		AHD		
	C	B.L.	11.03.25	APPROVAL ISSUE - MINOR TEXT UPDATES	DRG. FILE		0944		
	B	B.L.	06.12.24	APPROVAL ISSUE	DATE		NOV '24		
	A	B.L.	18.11.24	PRELIMINARY ISSUE	DESIGN		B.L.		
	No.	BY	DATE	DESCRIPTION		DRAWN		C.B.P.	
							NOV '24		


m 0400 699 979
e brett@langtreeconsulting.com.au

MT MARGARET ESTATE STAGE 12 - OPERATIONAL WORKS		SCALE	AS SHOWN				
NICKEL STREET ALICE RIVER, QLD, 4817		SHEET	7 OF 12				
		REVISION	A	B	C	0	1
DRAINAGE CHANNEL LONGITUDINAL SECTION		DRG No.	0944 - ASC - C063				

SIGNS LEGEND

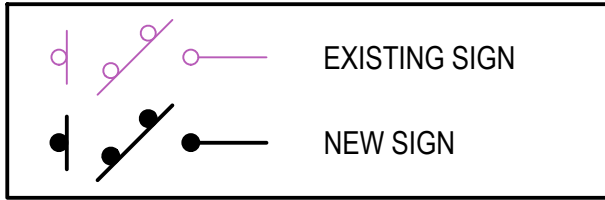



Townsville City Council

Accepted As Constructed

OPW24/0141
5/6/26


INTERSECTION SETOUT TABLE - LIP OF KERB			
POINT	EASTING	NORTHING	LEVEL
1001	58375.919	860947.446	55.272*
1002	58547.097	860944.649	55.259*
1003	58551.251	860943.659	55.157*
1004	58555.496	860944.131	55.022*
1005	58559.852	860946.408	54.818*
1006	58567.173	860938.954	54.764*
1007	58563.885	860934.874	55.014*
1008	58562.624	860930.581	55.218*
1009	58562.963	860926.119	55.384*
1010	58565.329	860921.444	55.468*

ASCON LEGEND:

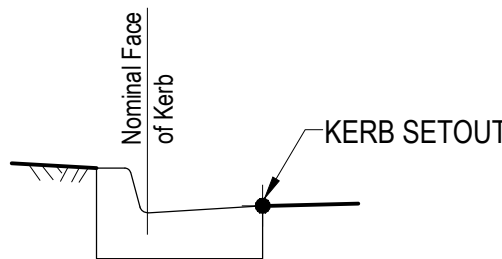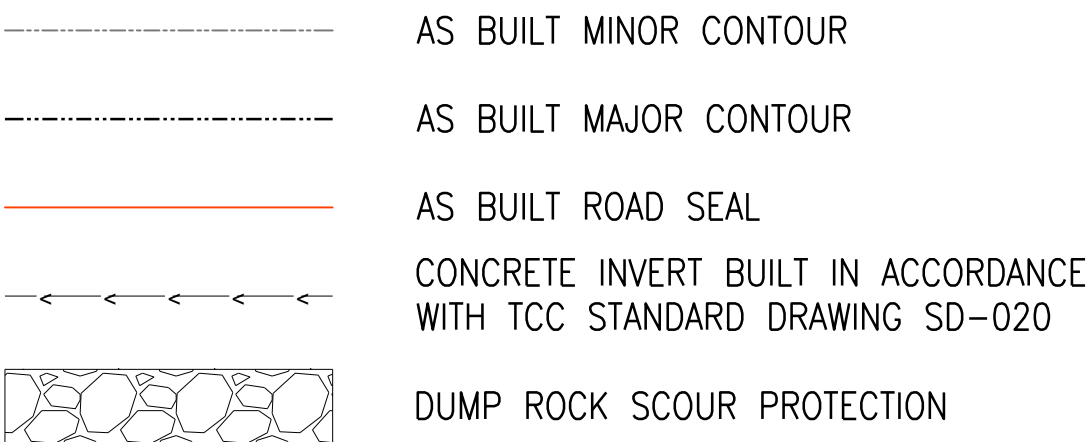


*TYPE B1' KERB AND CHANNEL
AS PER TCC STD DRG SD-020D

KERB SETOUT DETAIL
N.T.S.

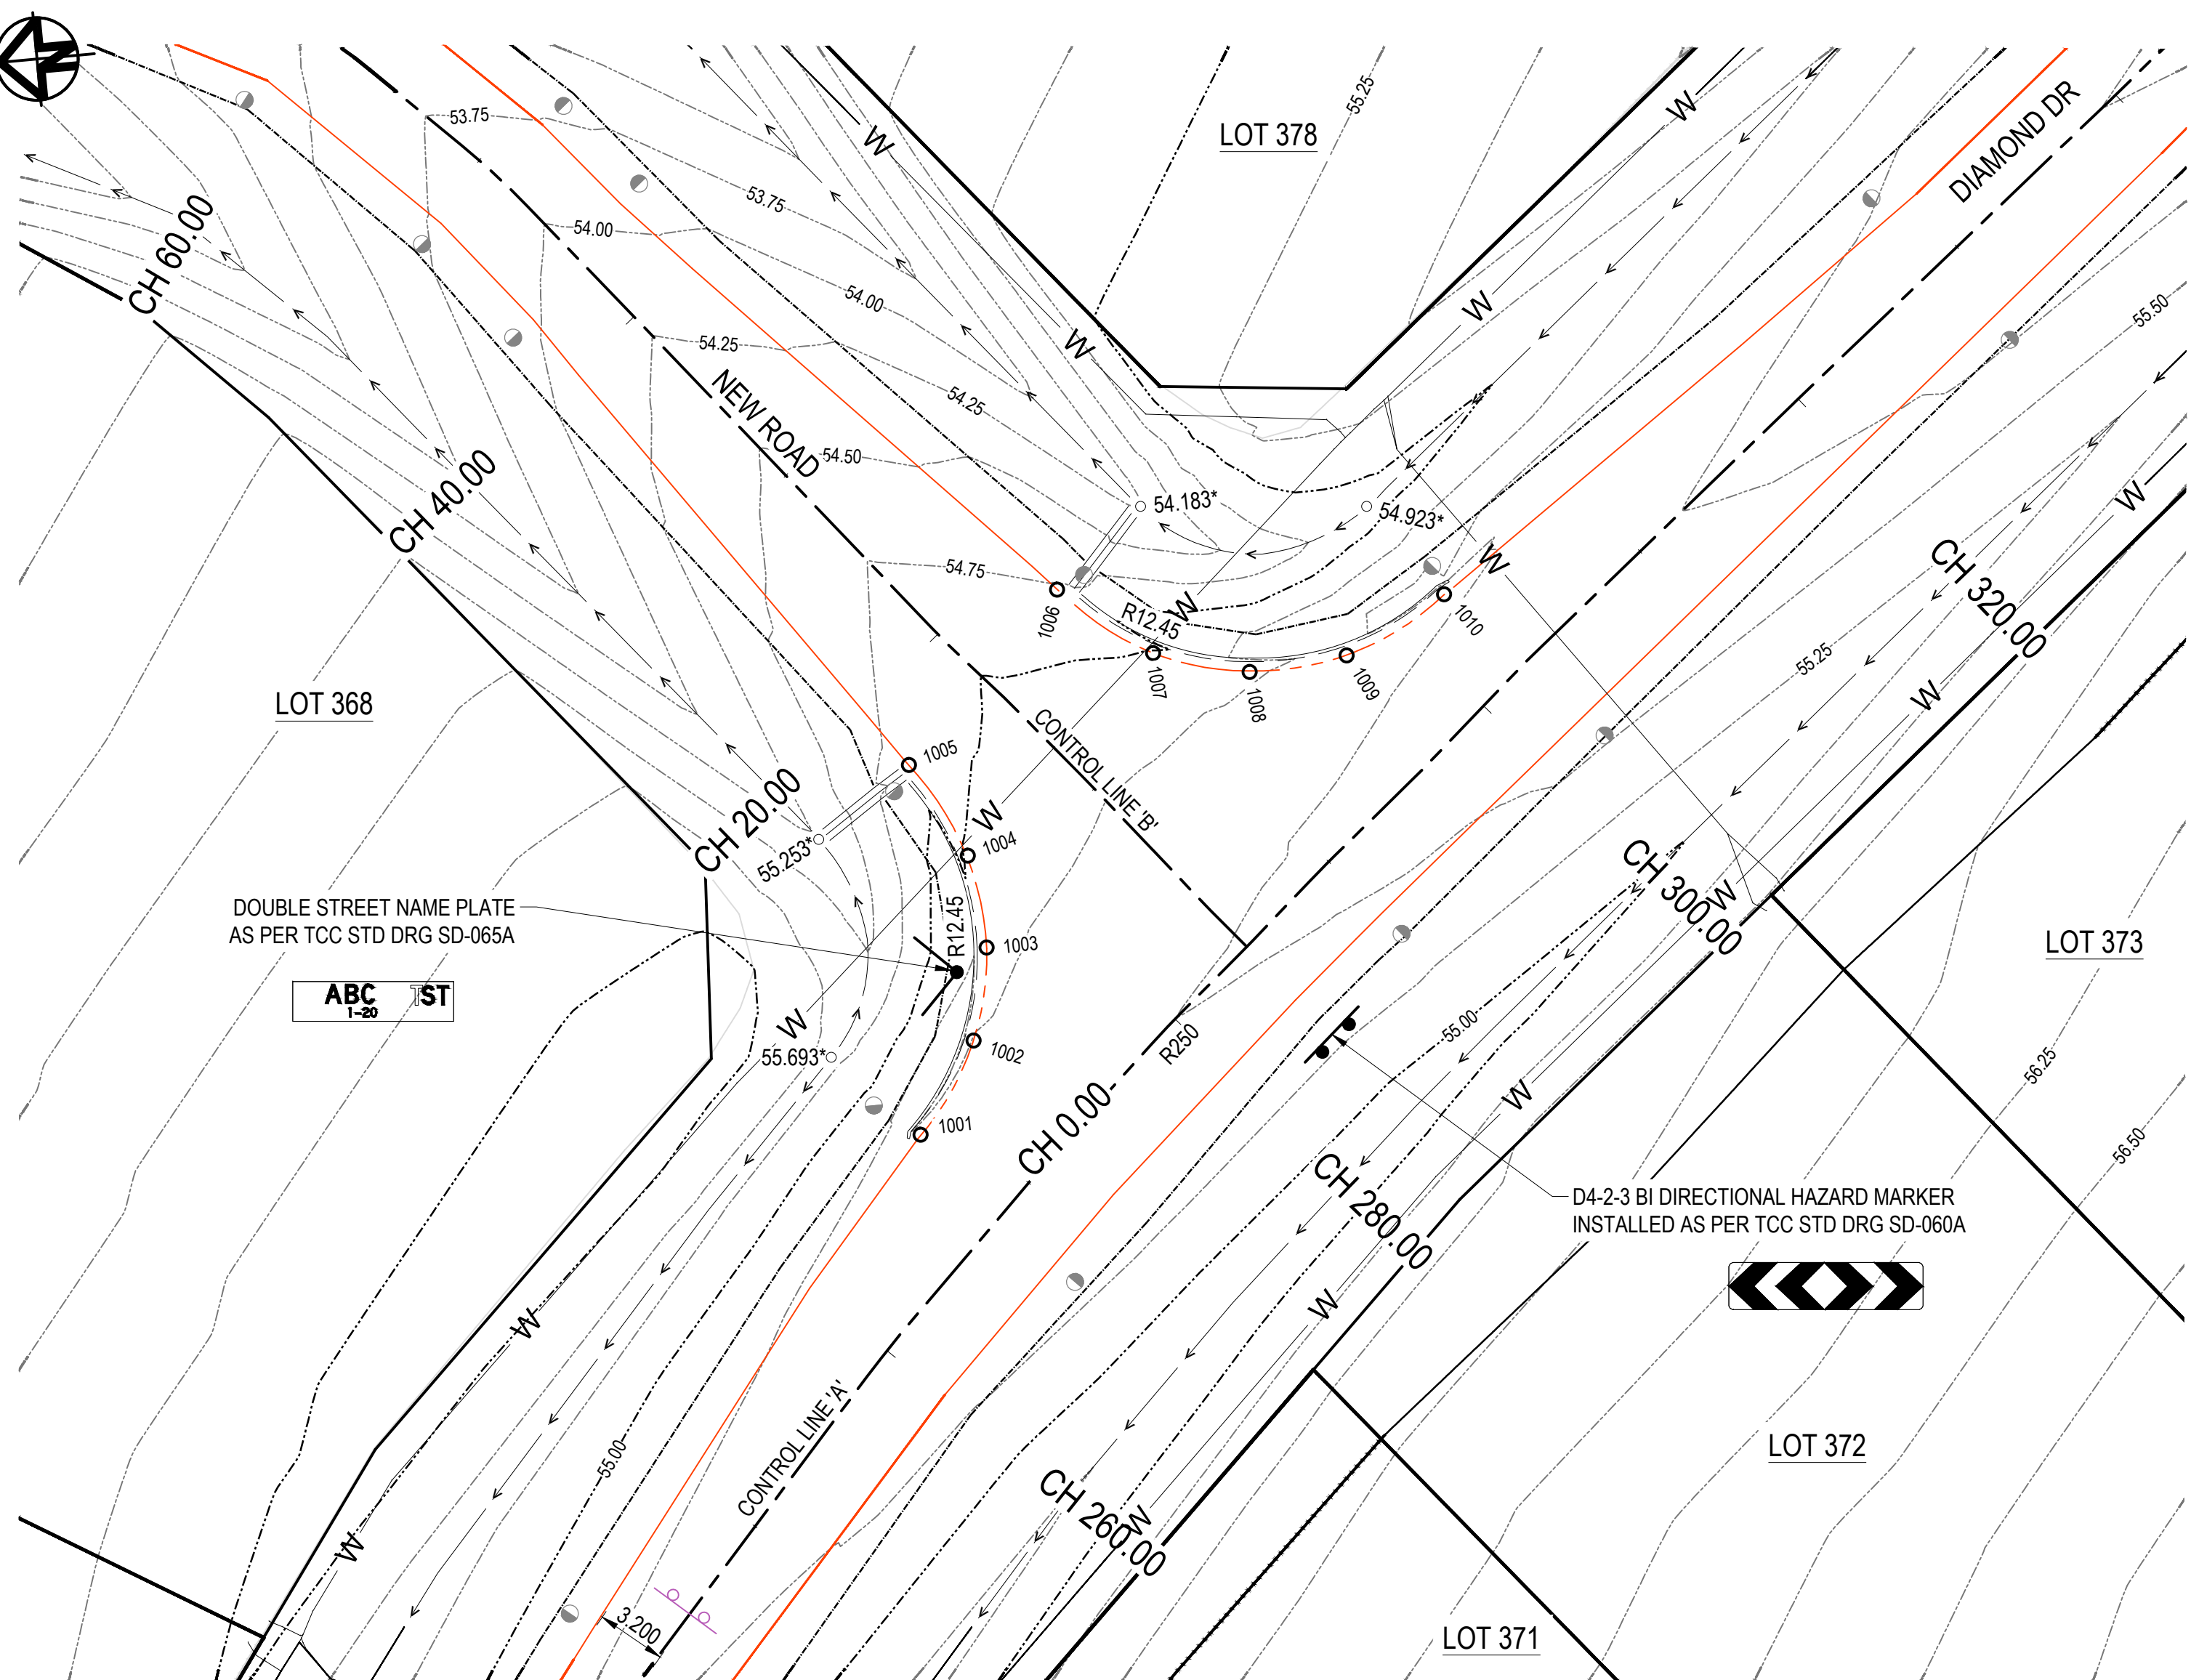

KERB RETURN SETOUT - INTERSECTION OF DIAMOND DR AND NEW ROAD
SCALE 1:250

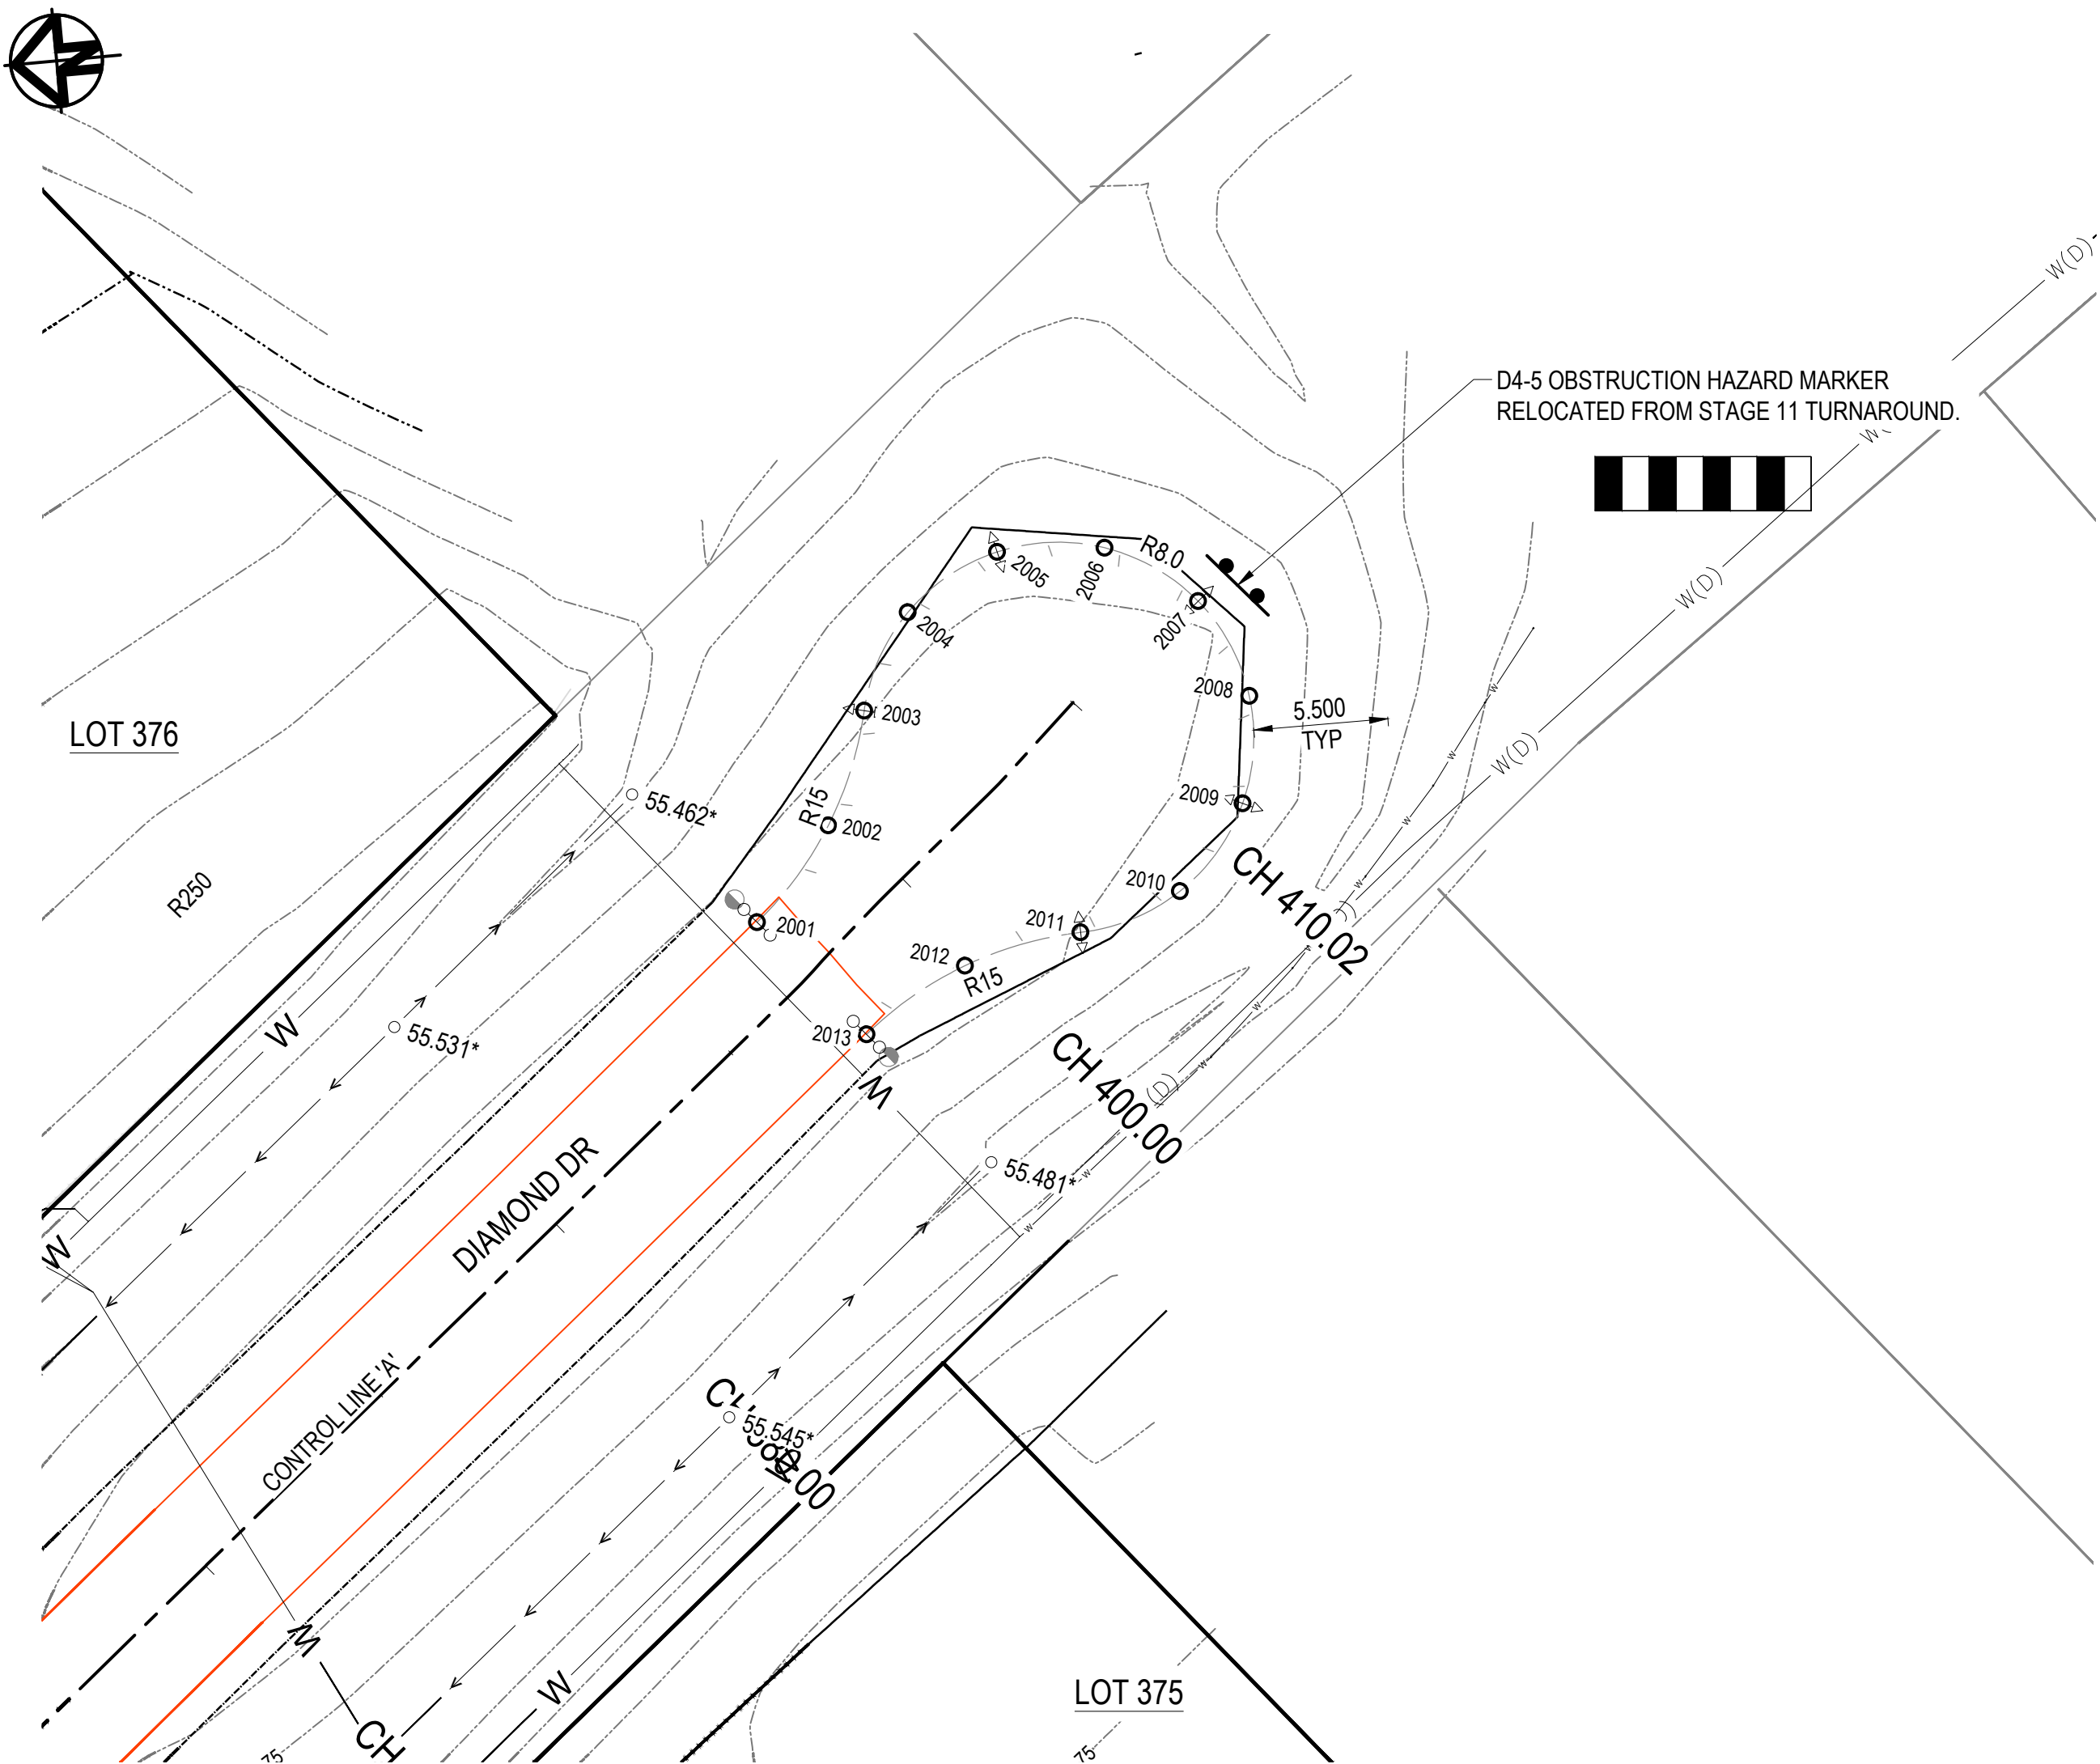

TEMPORARY CULDESAC SETOUT - DIAMOND DR
SCALE 1:250

CULDESAC SETOUT TABLE - EDGE OF ROADWAY			
POINT	EASTING	NORTHING	LEVEL
2001	58621.801	860848.500	56.032*
2002	58625.474	860845.239	56.041*
2003	58630.004	860843.341	55.990*
2004	58633.842	860841.189	55.908*
2005	58635.961	860837.333	55.899*
2006	58635.721	860832.940	55.925*
2007	58633.195	860829.338	55.970*
2008	58629.145	860827.616	55.946*
2009	58624.798	860828.297	55.942*
2010	58621.469	860831.173	55.908*
2011	58620.163	860835.375	55.996*
2012	58619.250	860840.201	56.057*
2013	58616.826	860844.473	56.065*

ROWLANDS SURVEYS PTY LTD, DO HEREBY CERTIFY THAT THIS DRAWING ACCURATELY AND CORRECTLY DESCRIBES AND RECORDS THE NATURE AND LOCATION OF THE WORKS DEPICTED BY ASTERISKS (*) HEREON AS THEY HAVE BEEN CONSTRUCTED.

BK

BENJAMIN COOK (No. 4534)


22.05.2026
DATE

I, BRETT LANGTREE OF LANGTREE CONSULTING PTY LTD, HEREBY CERTIFY THAT THE WORKS AS SHOWN ON THE AS CONSTRUCTED DRAWINGS REFLECT ANY CHANGES THAT WERE MADE DURING THE COURSE OF CONSTRUCTION.

B. Langtree

BRETT LANGTREE (RPEQ No. 11932)

22.05.2026
DATE

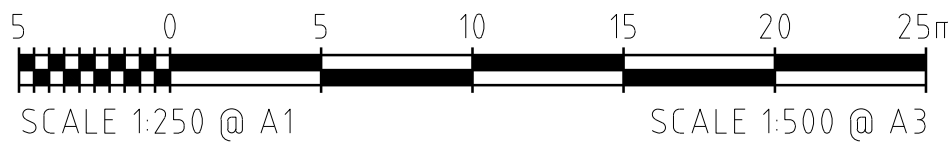

AS CONSTRUCTED

22 MAY 2026

REFER TO DRAWING C001 FOR GENERAL LEGEND

REVISIONS	1	B.S	22.05.26	AS CONSTRUCTED	HORIZ. DATUM		MT MARGARET GRID		CERTIFICATION
	0	M.V.	10.10.25	FOR CONSTRUCTION	VERT. DATUM		AHD		
	E	B.L.	19.03.25	APPROVAL ISSUE - KERB RADIUS ADDED	DRG. FILE		0944	DATE	
	D	B.L.	17.03.25	APPROVAL ISSUE - MINOR UPDATES	DESIGN		B.L.	NOV '24	
	C	B.L.	13.12.24	APPROVAL ISSUE - LABELS ADDED	DRAWN		C.B.P.	NOV '24	
No.	BY	DATE	DESCRIPTION		DRAWING INFORMATION				
COPYRIGHT © These designs and drawings are copyright and are not to be used or reproduced without the written permission of LANGTREE CONSULTING PTY LTD (ACN 29 611 368 024). The contents of this drawing are electronically generated, are confidential and may only be used for the purpose for which they were intended. This is an uncontrolled document issued for information purposes only, unless the checked sections are signed and approved. Figured dimensions take precedence over scale. Do not scale from this drawing.									




m 0400 699 979
e brett@langtreeconsulting.com.au

MT MARGARET ESTATE STAGE 12 - OPERATIONAL WORKS

NICKEL STREET
ALICE RIVER, QLD, 4817
INTERSECTION SETOUT DETAILS SHEET 1

SCALE	AS SHOWN				
SHEET	8 OF 12				
REVISION	A	B	C	D	E
	0	1			
DRG No.	0944 - ASC - C071				


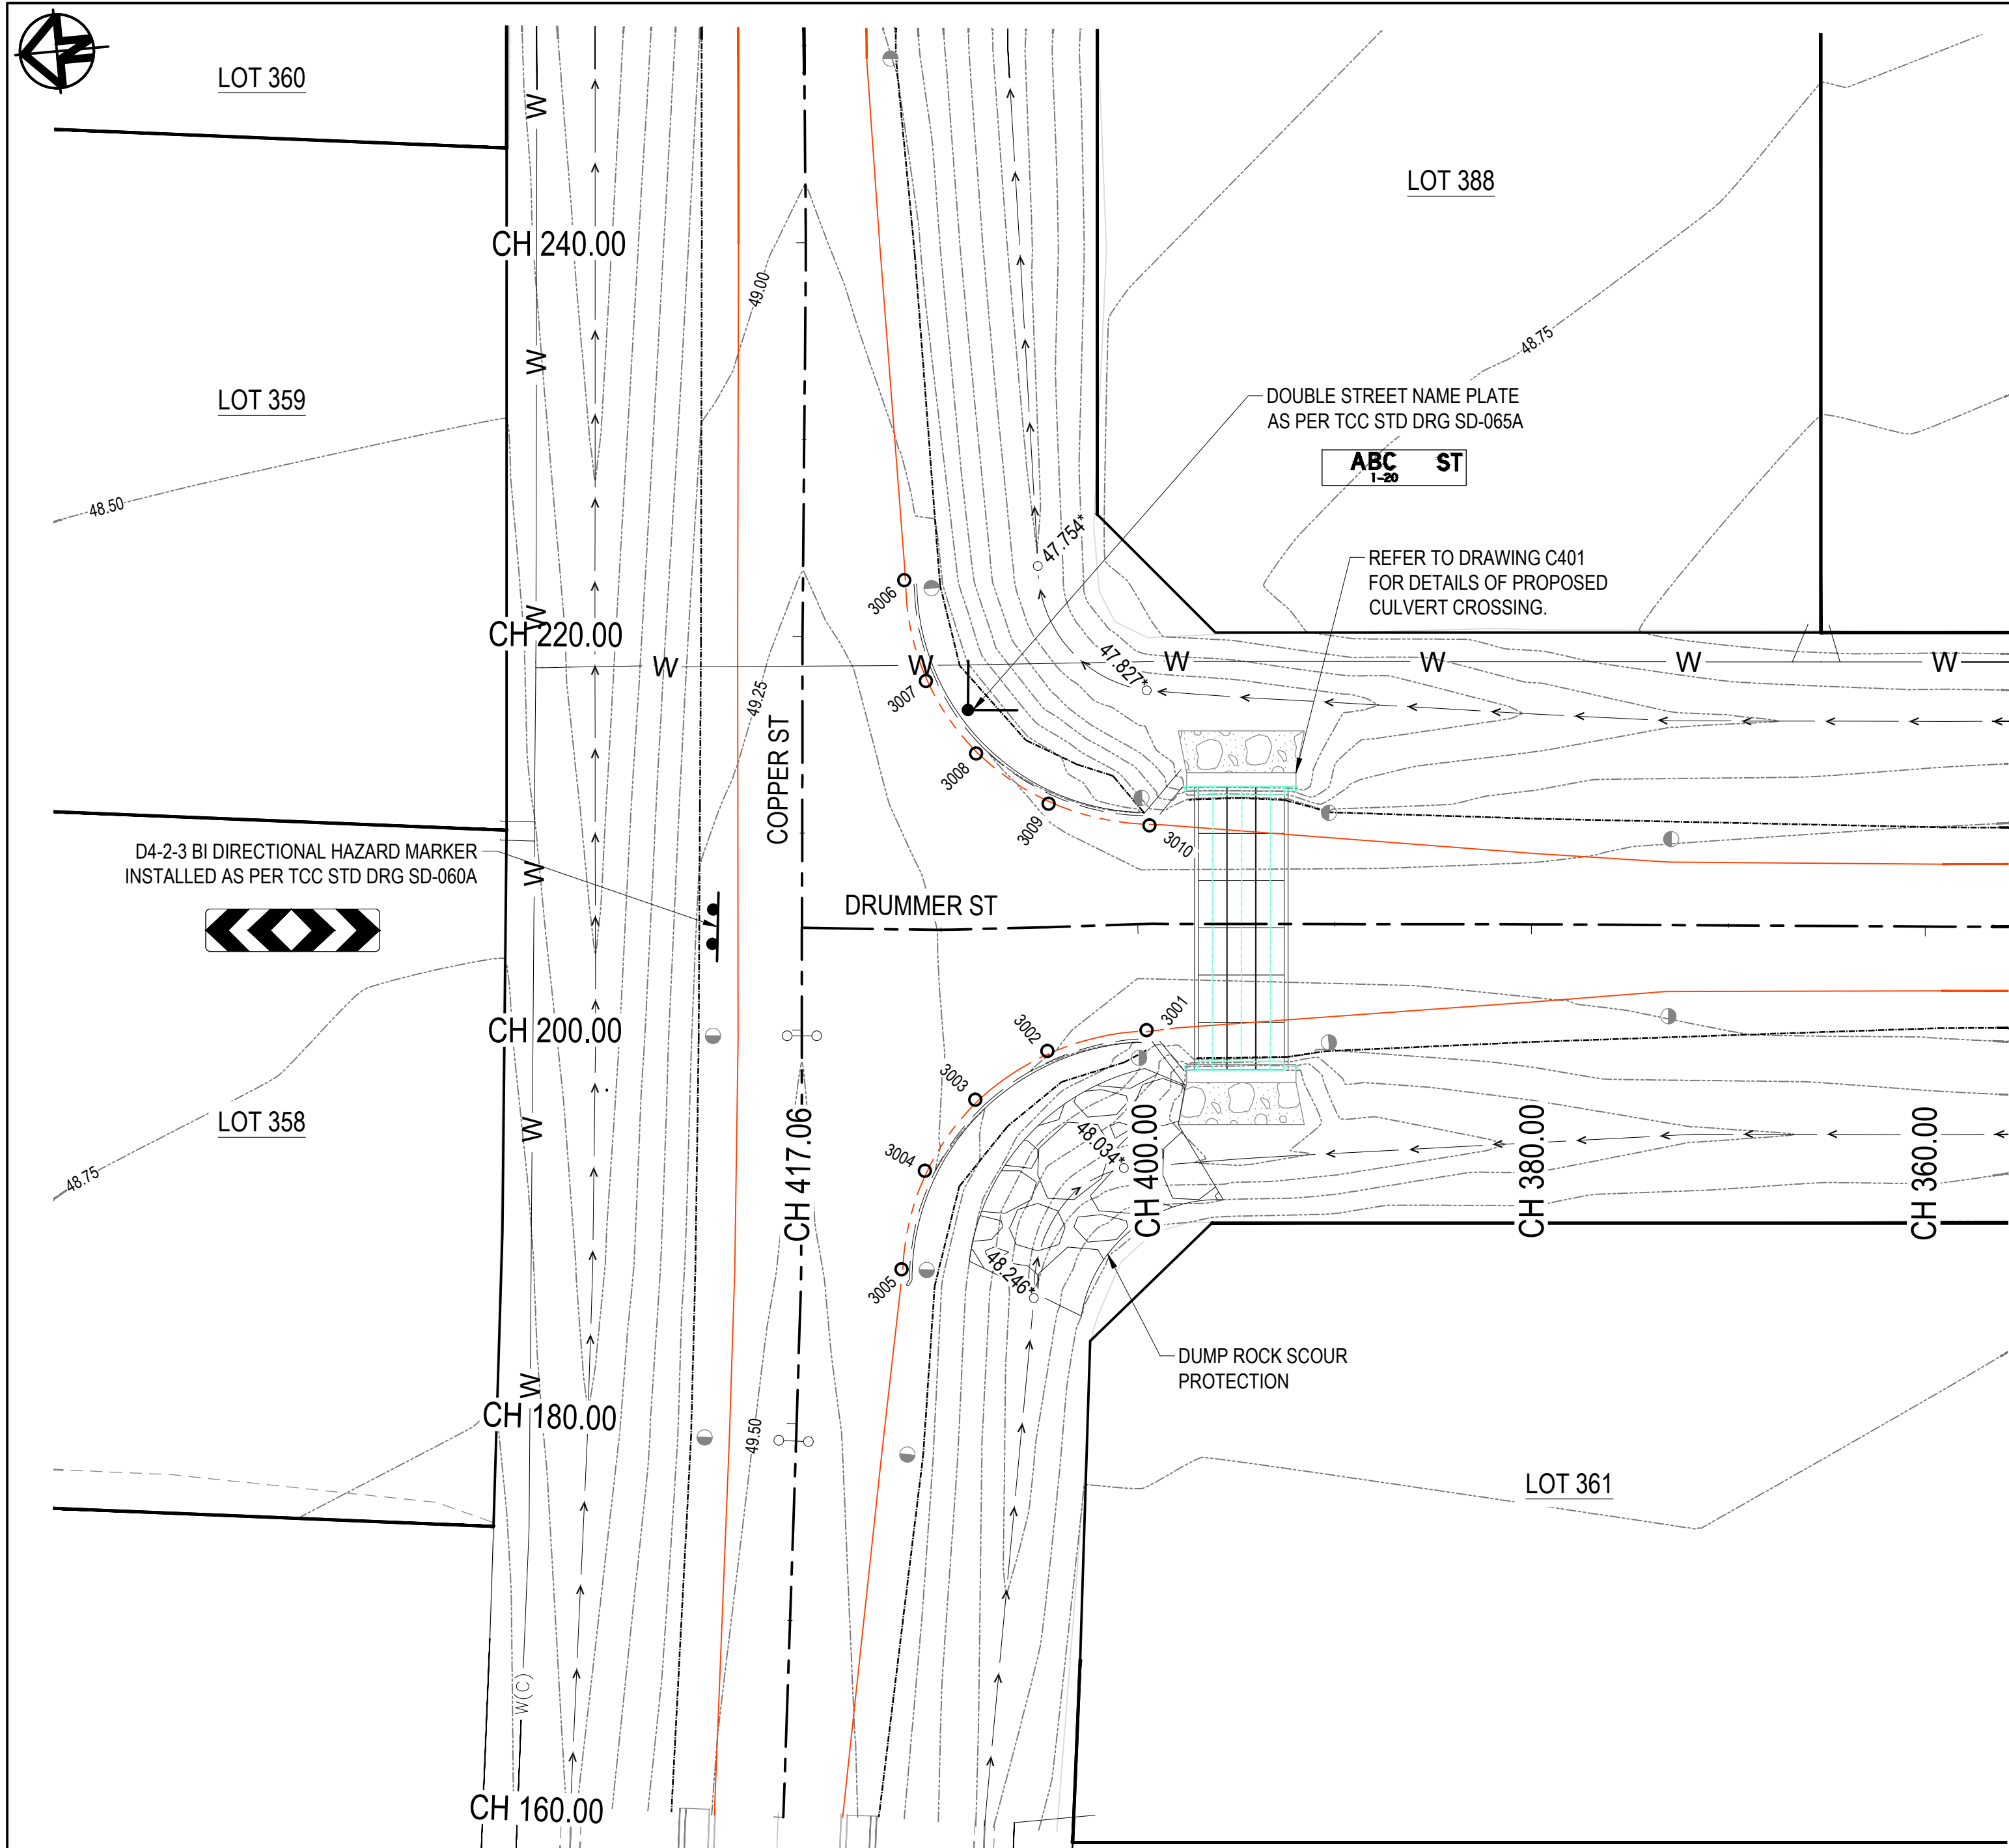


KERB RETURN SETOUT - INTERSECTION OF COPPER ST AND DRUMMER ST
SCALE 1:250

INTERSECTION SETOUT TABLE - LIP OF KERB			
POINT	EASTING	NORTHING	LEVEL
3001	58620.300	861307.016	48.911*
3002	58619.707	861312.132	49.013*
3003	58617.580	861316.006	49.159*
3004	58614.233	861318.893	49.299*
3005	58609.351	861320.537	49.370*
3006	58644.194	861317.148	49.091*
3007	58638.992	861316.526	49.125*
3008	58635.090	861314.335	49.058*
3009	58632.216	861310.906	48.966*
3010	58630.642	861305.908	48.902*

ASCON LEGEND:

- AS BUILT MINOR CONTOUR
- AS BUILT MAJOR CONTOUR
- AS BUILT ROAD SEAL
- CONCRETE INVERT BUILT IN ACCORDANCE WITH TCC STANDARD DRAWING SD-020
- DUMP ROCK SCOUR PROTECTION

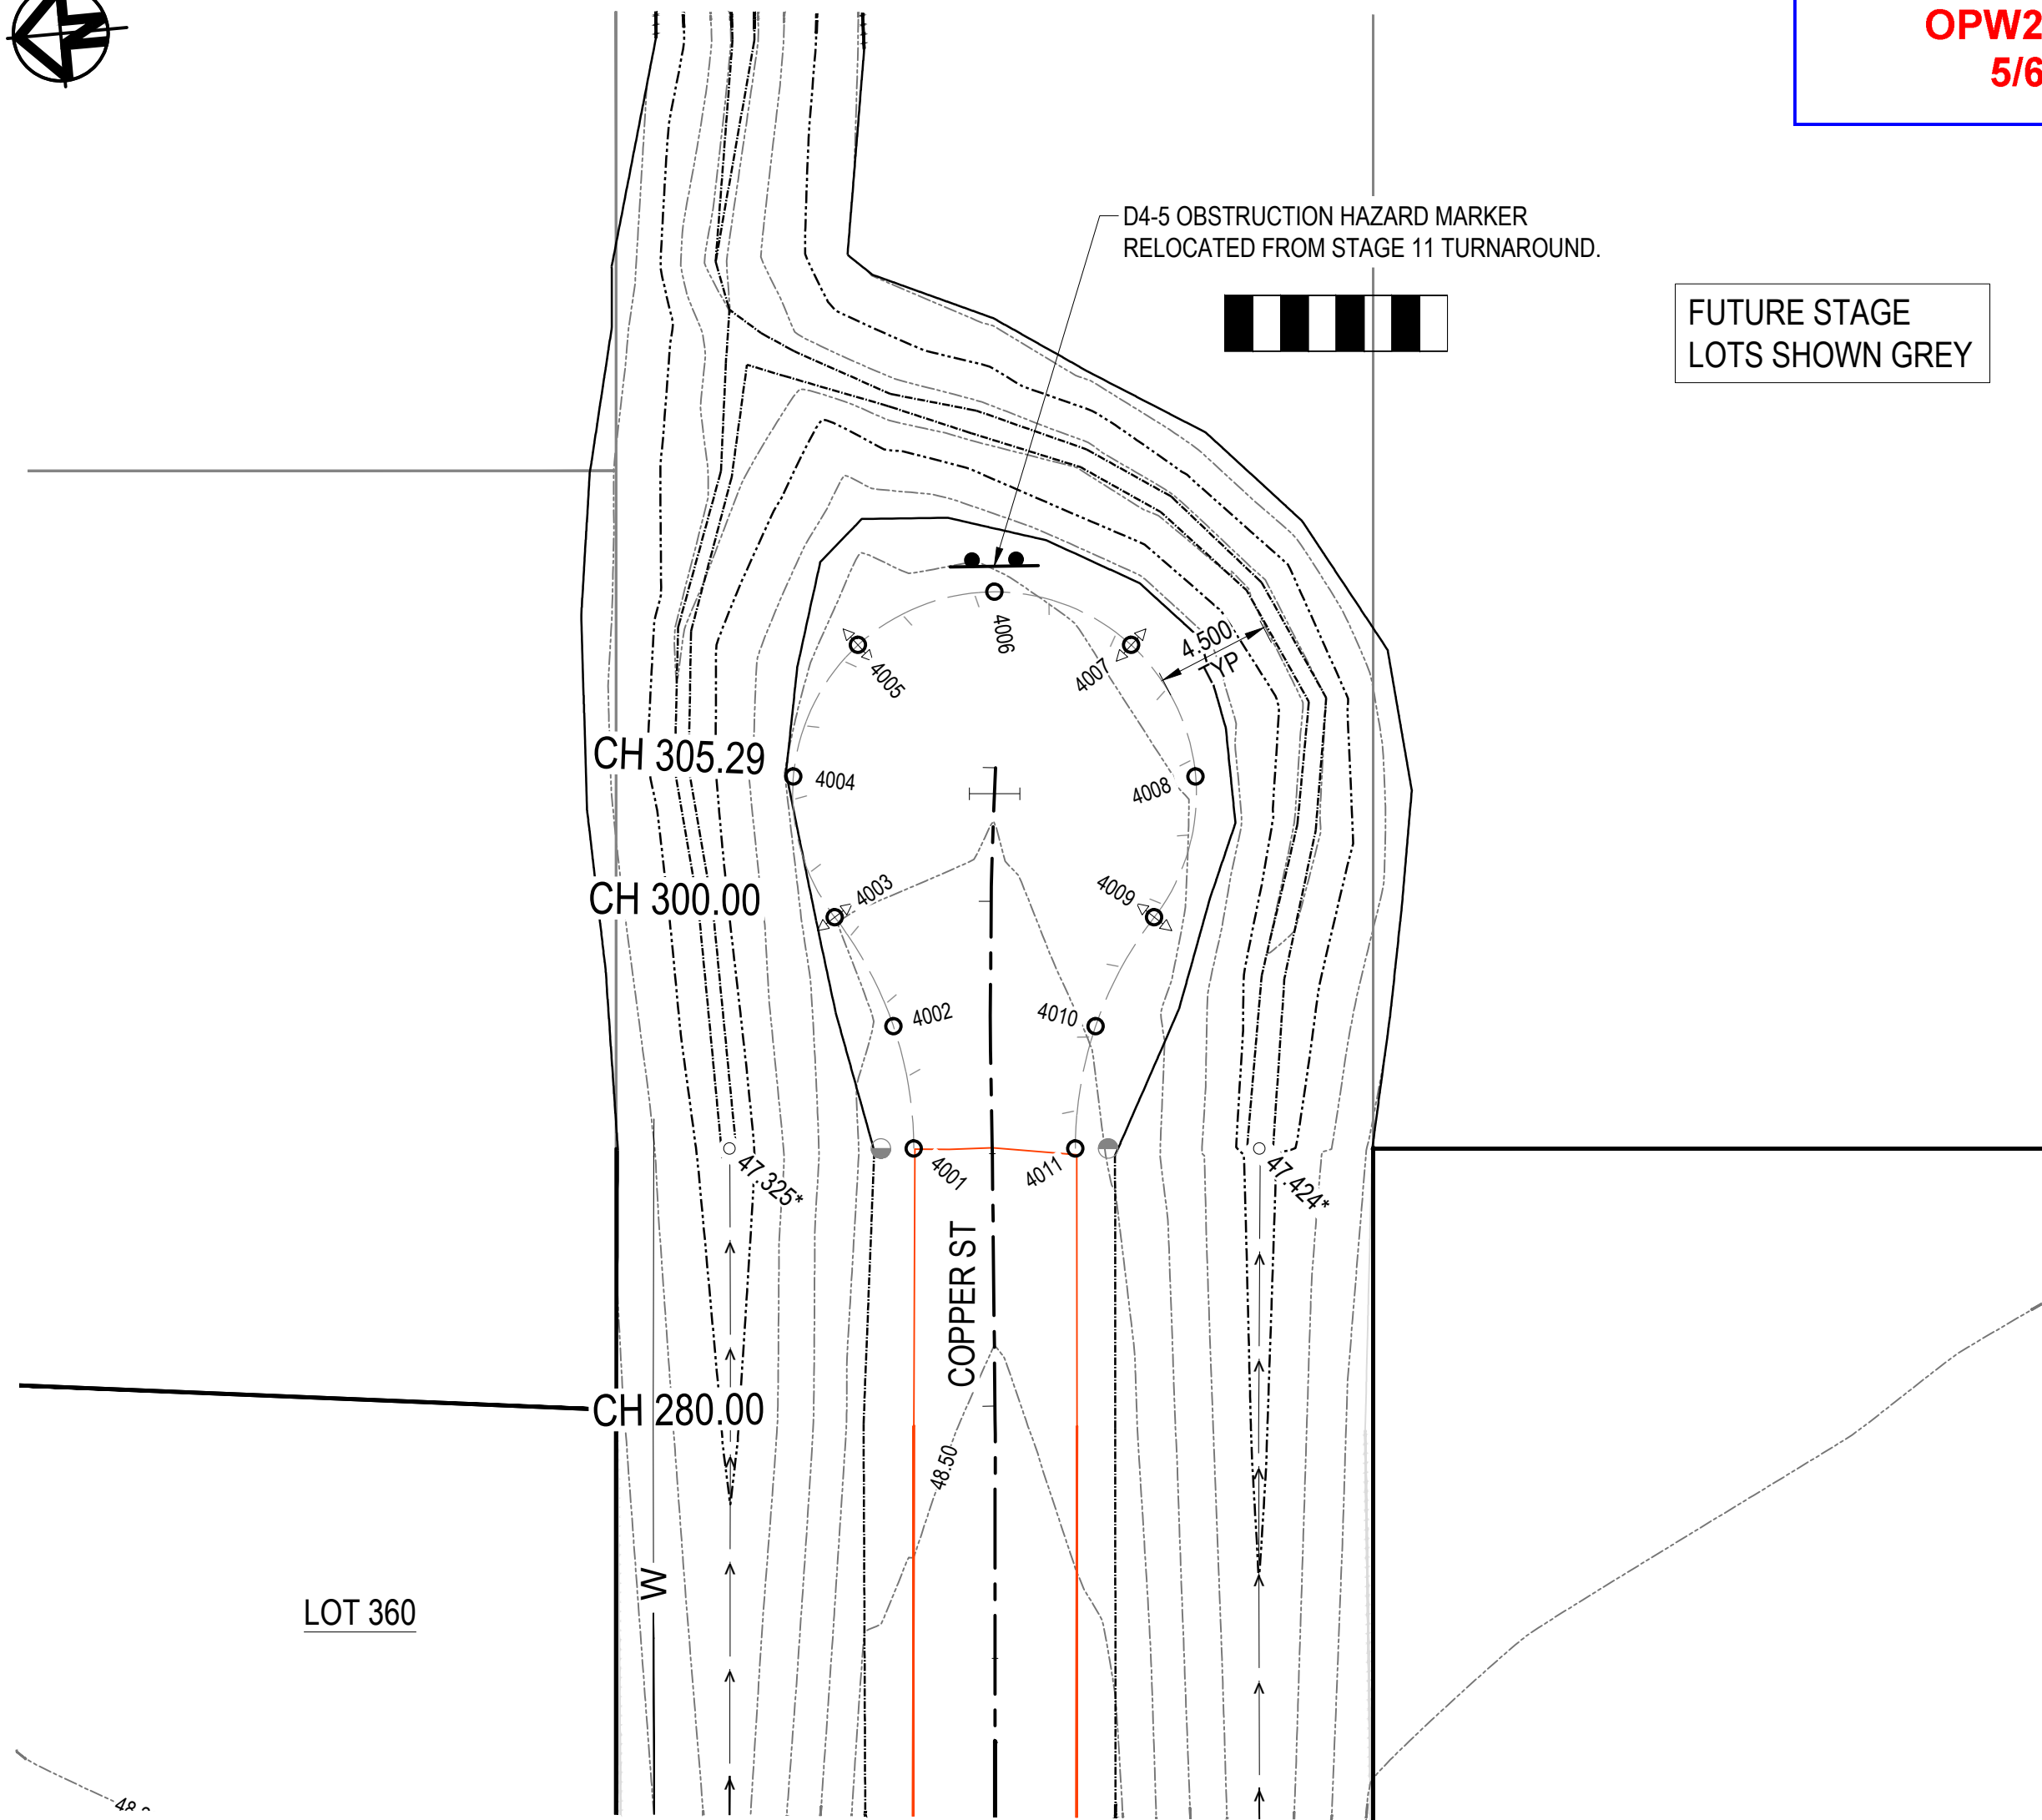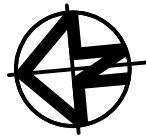

TEMPORARY CULDESAC SETOUT - COPPER ST
SCALE 1:250


CULDESAC SETOUT TABLE - EDGE OF ROADWAY			
POINT	EASTING	NORTHING	LEVEL
4001	58712.033	861319.259	48.286*
4002	58716.933	861319.610	48.308*
4003	58721.456	861321.524	48.247*
4004	58727.155	861322.641	48.045*
4005	58732.107	861319.608	48.146*
4006	58733.704	861314.024	48.078*
4007	58731.103	861308.832	47.944*
4008	58725.675	861306.767	47.970*
4009	58720.280	861308.918	48.150*
4010	58716.189	861311.636	48.236*
4011	58711.439	861312.887	48.310*

ROWLANDS SURVEYS PTY LTD, DO HEREBY CERTIFY THAT THIS DRAWING ACCURATELY AND CORRECTLY DESCRIBES AND RECORDS THE NATURE AND LOCATION OF THE WORKS DEPICTED BY ASTERISKS (*) HEREON AS THEY HAVE BEEN CONSTRUCTED.

BK
BENJAMIN COOK (No. 4534) 22.05.2026
DATE

I, BRETT LANGTREE OF LANGTREE CONSULTING PTY LTD, HEREBY CERTIFY THAT THE WORKS AS SHOWN ON THE AS CONSTRUCTED DRAWINGS REFLECT ANY CHANGES THAT WERE MADE DURING THE COURSE OF CONSTRUCTION.

B. Langtree
BRETT LANGTREE (RPEQ No. 11932) 22.05.2026
DATE

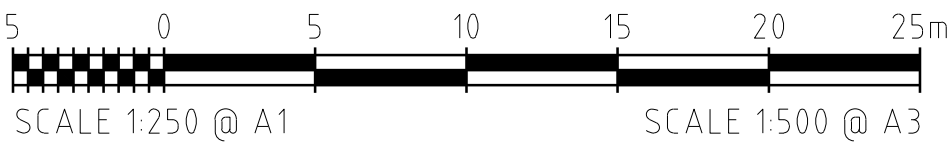

AS CONSTRUCTED
22 MAY 2026

REFER TO DRAWING C001 FOR GENERAL LEGEND

REVISIONS	No.	BY	DATE	DESCRIPTION	HORIZ. DATUM	MT MARGARET GRID	CERTIFICATION
	1	B.S	22.05.26	AS CONSTRUCTED	VERT. DATUM	AHD	
	0	M.V.	10.10.25	FOR CONSTRUCTION	DRG. FILE	0944	DATE
	F	B.L.	15.04.25	APPROVAL ISSUE - CONTOURS AMENDED	DESIGN	B.L.	NOV '24
	E	B.L.	19.03.25	APPROVAL ISSUE - KERB RADIUS ADDED	DRAWN	C.B.P.	NOV '24
				D	B.L.	17.03.25	APPROVAL ISSUE - MINOR UPDATES

m e


0400 699 979
brett@langtreeconsulting.com.au

MT MARGARET ESTATE STAGE 12 - OPERATIONAL WORKS

NICKEL STREET
ALICE RIVER, QLD, 4817

INTERSECTION SETOUT DETAILS SHEET 2


SCALE	AS SHOWN				
SHEET	9 OF 12				
REVISION	A	B	C	D	E
	F	0	1		
DRG No.	0944 - ASC - C072				

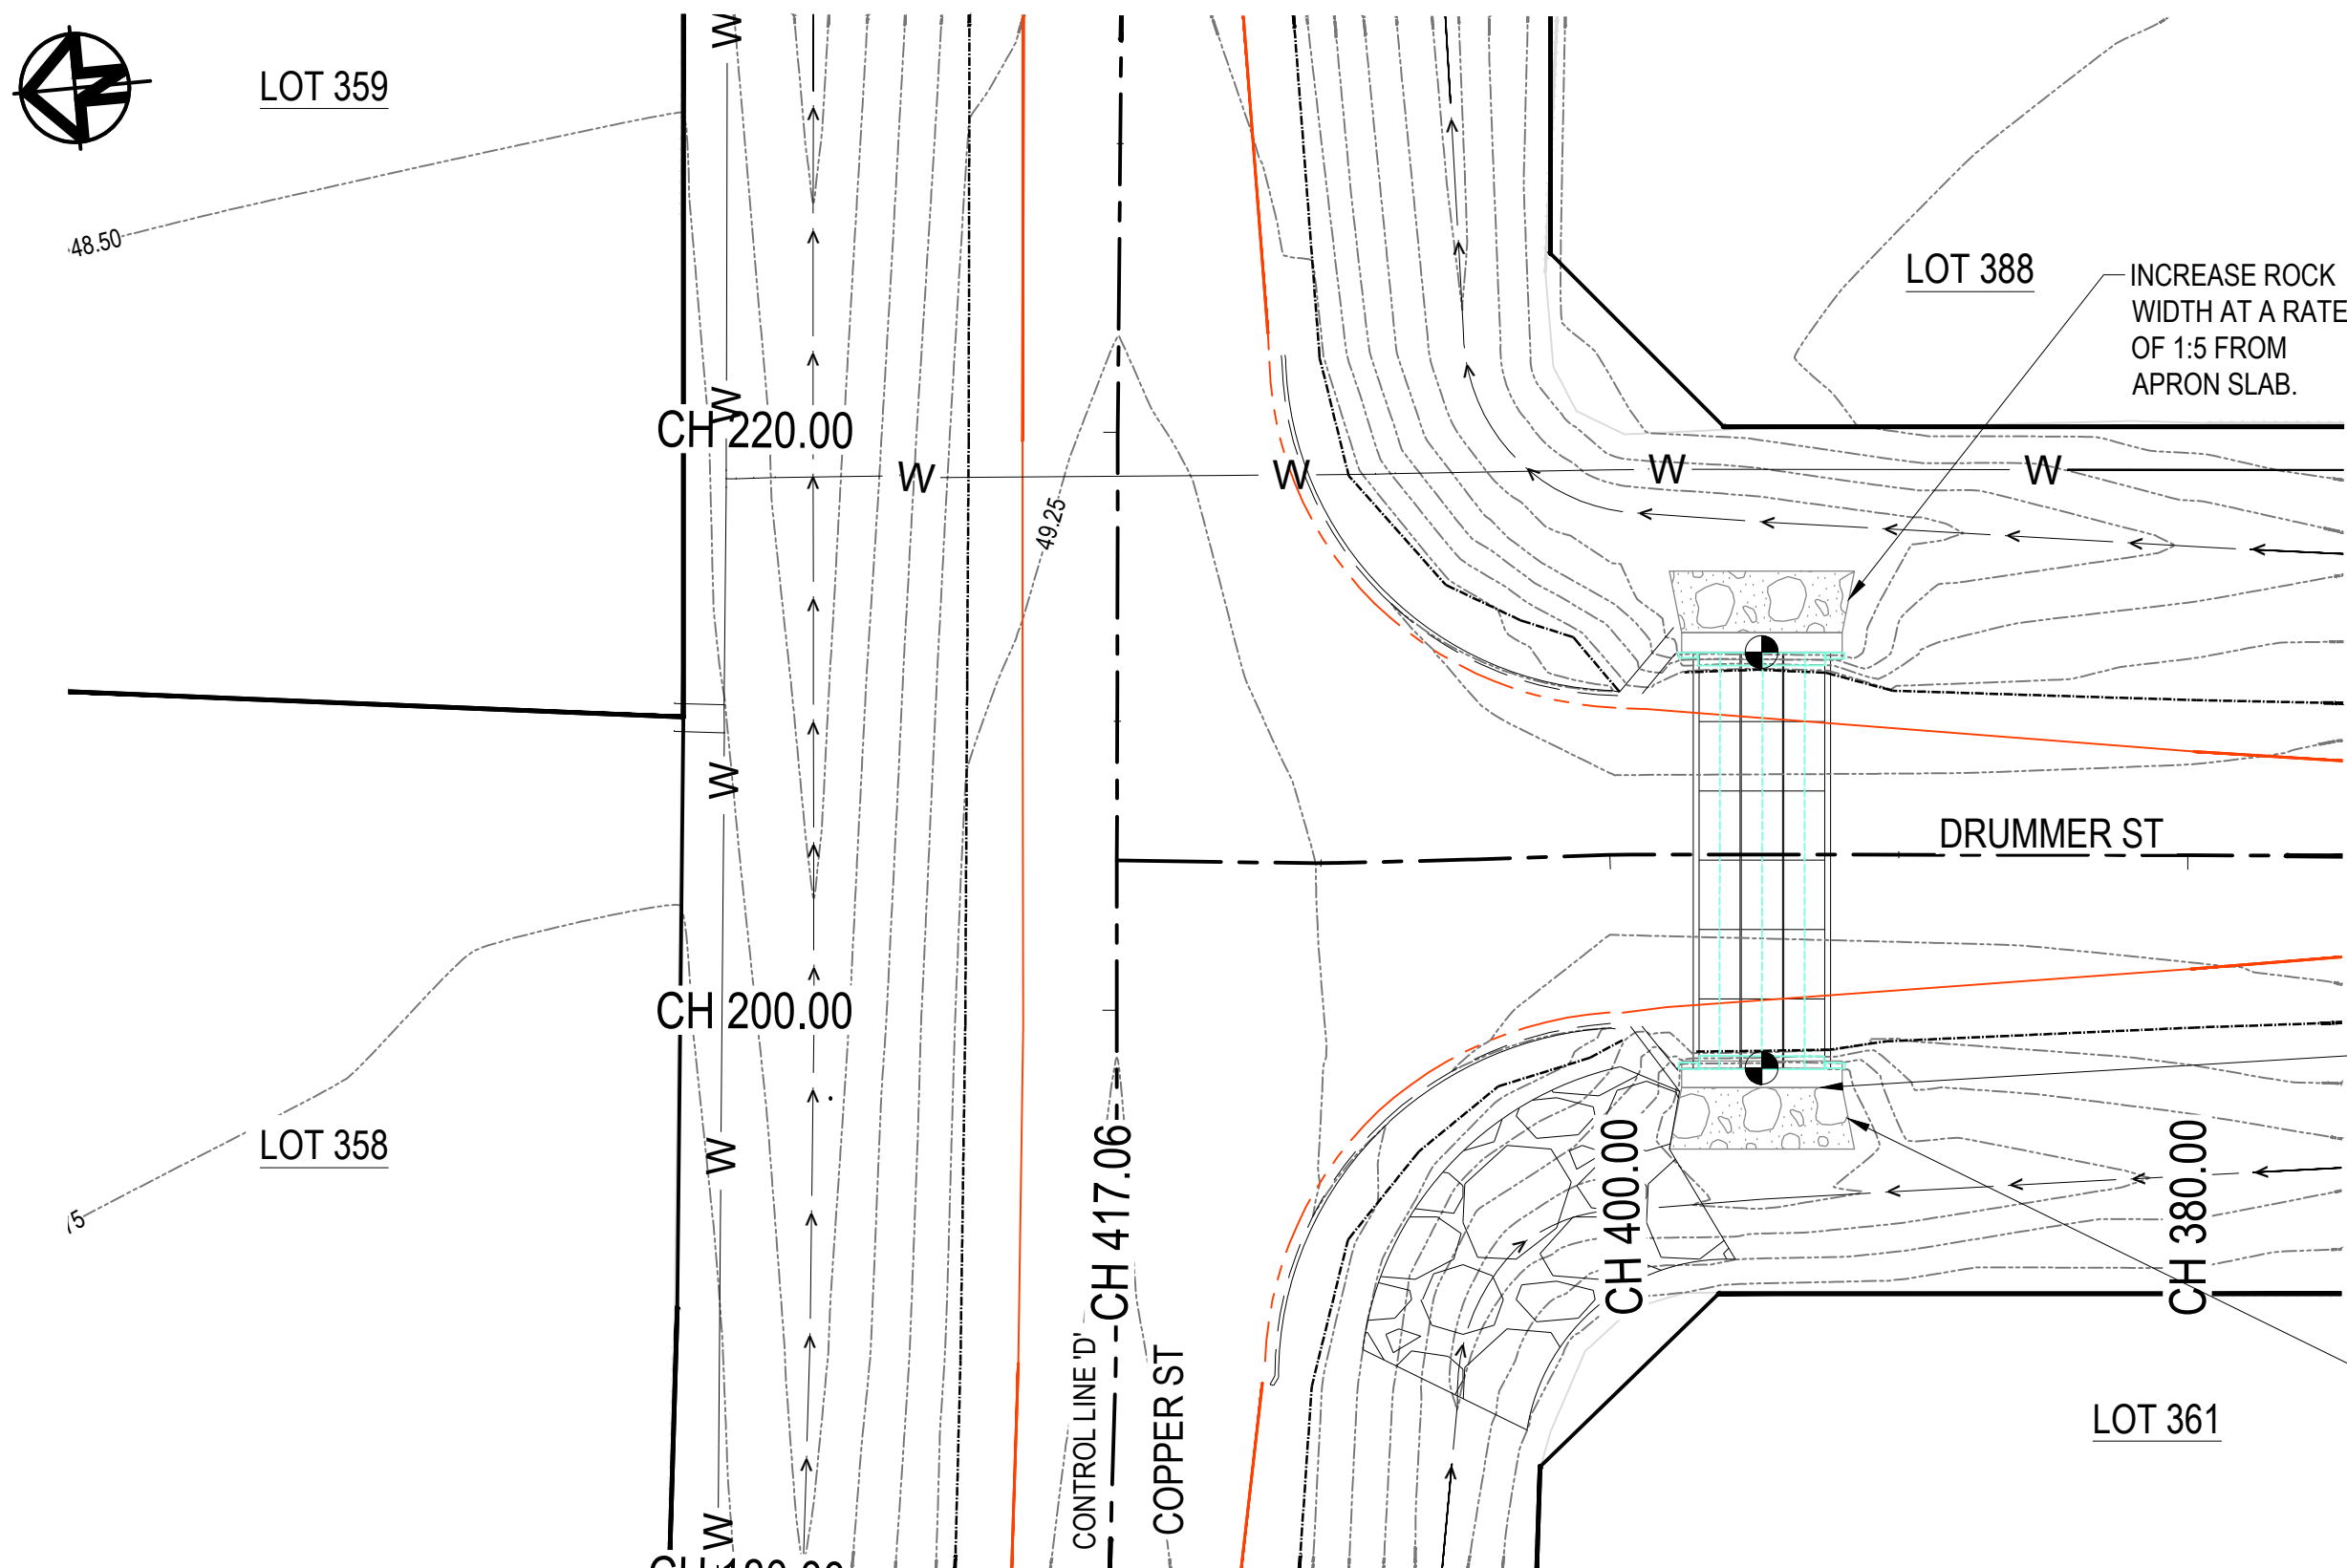


CULVERT 02 LAYOUT - INTERSECTION OF COPPER ST AND DRUMMER ST
SCALE 1:250

ASCON LEGEND:

- AS BUILT MINOR CONTOUR
- AS BUILT MAJOR CONTOUR
- AS BUILT ROAD SEAL
- CONCRETE INVERT BUILT IN ACCORDANCE WITH TCC STANDARD DRAWING SD-020
- DUMP ROCK SCOUR PROTECTION

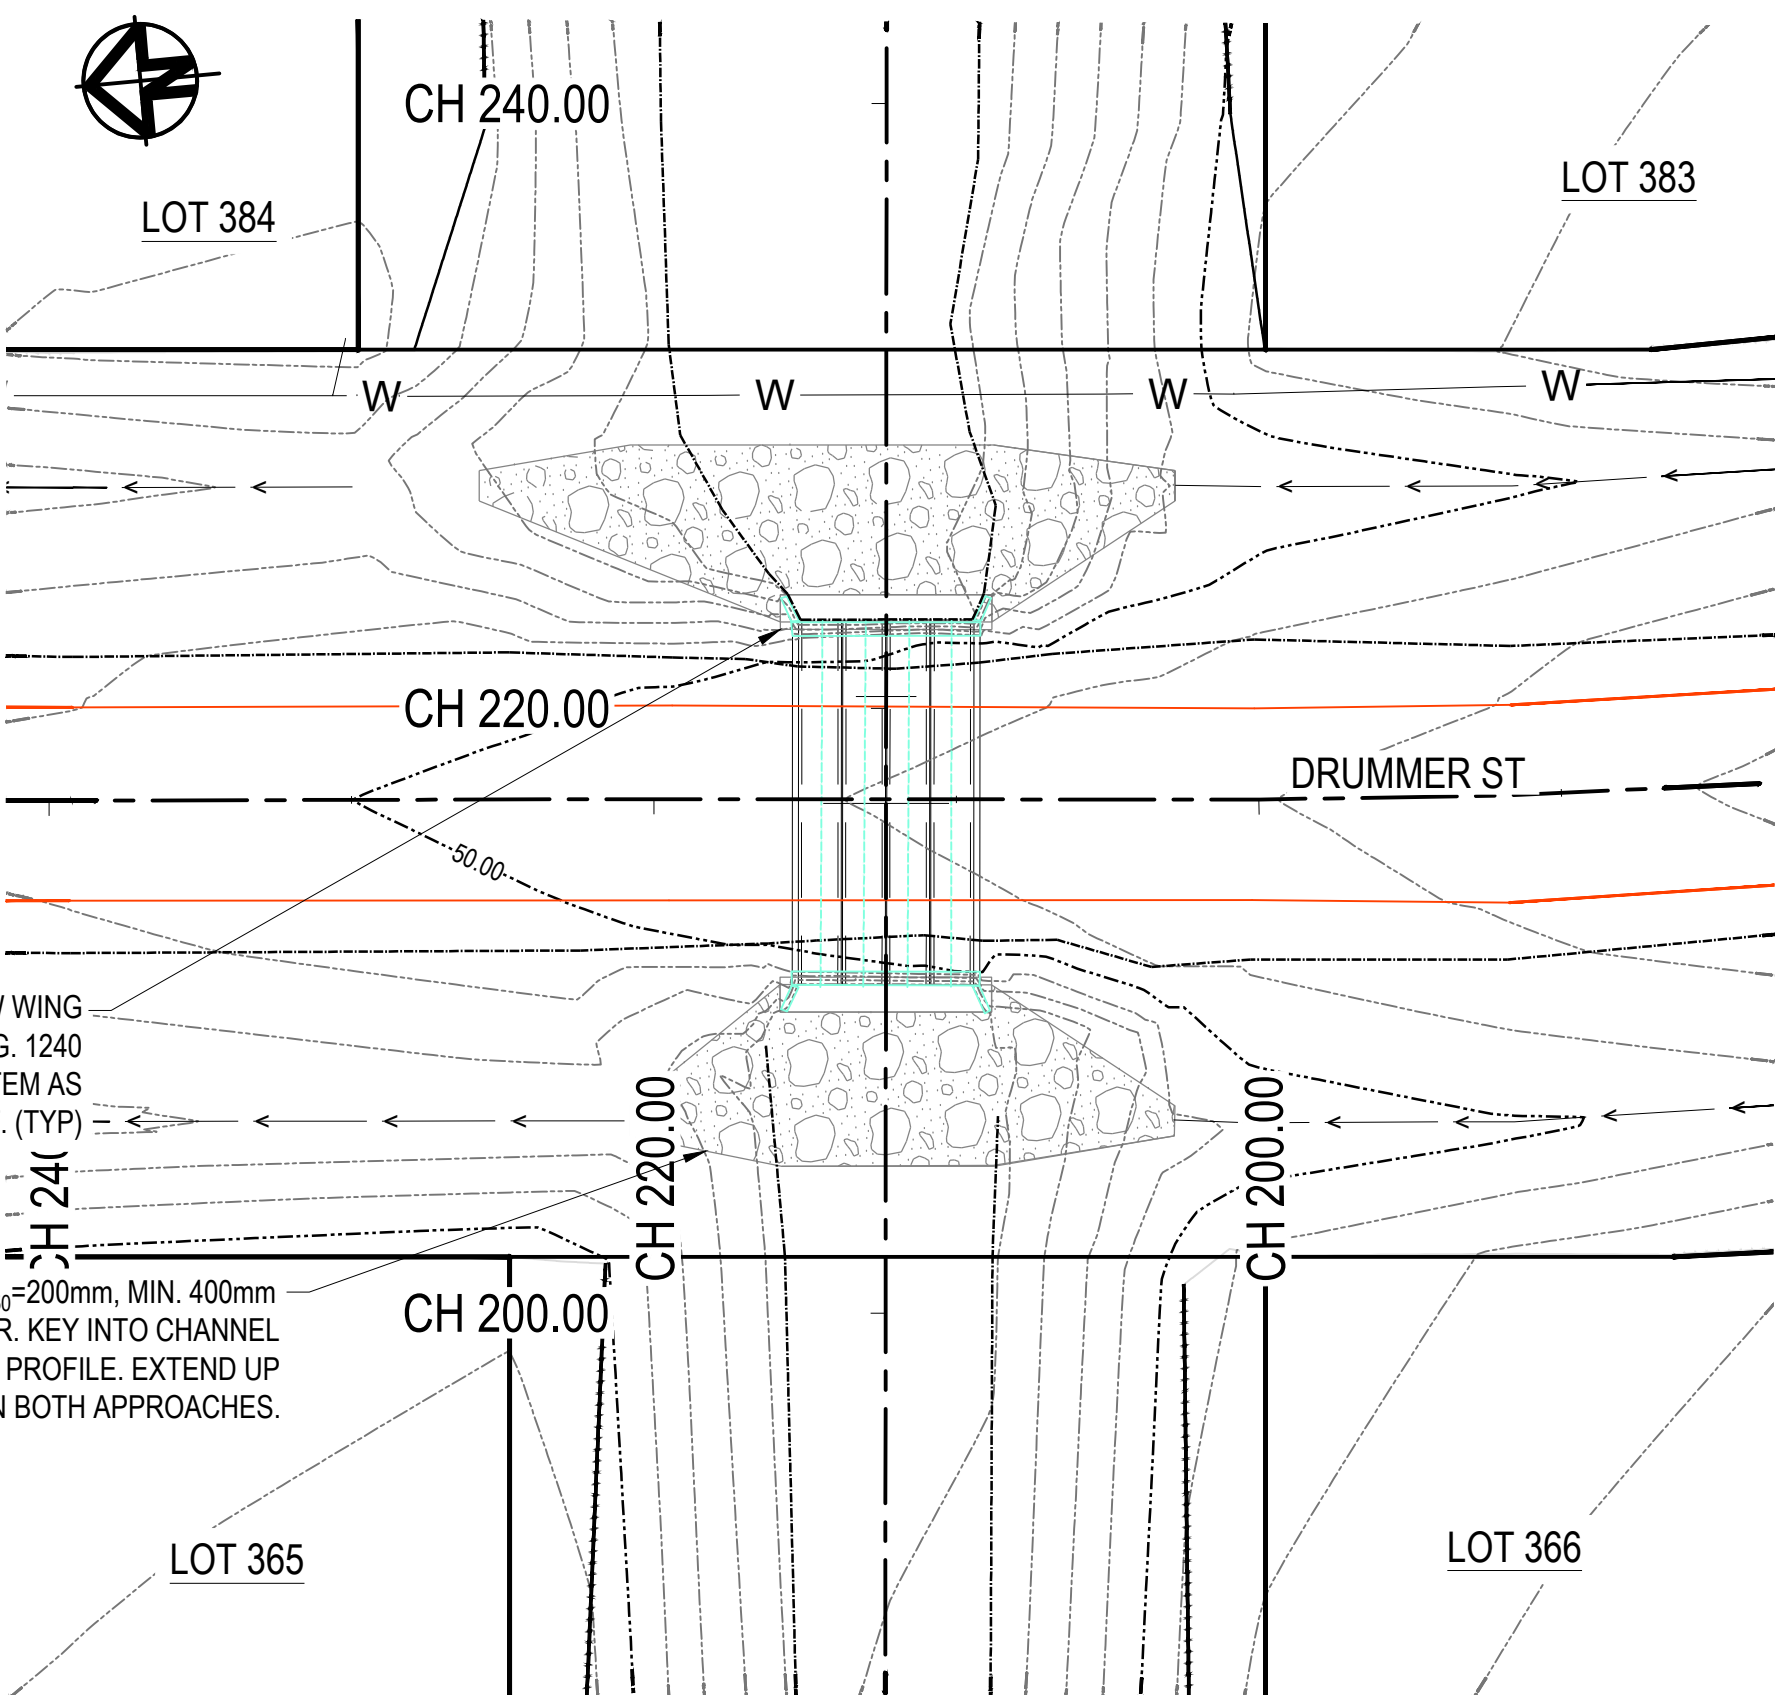

CULVERT 01 LAYOUT - DRUMMER STREET
SCALE 1:250

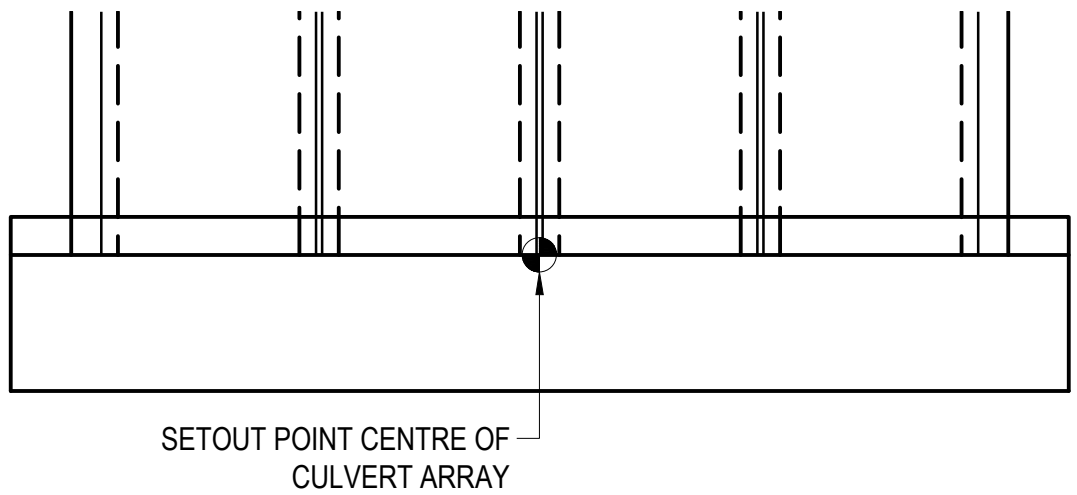

TYPICAL HEADWALL SETOUT
SCALE 1:100

ROWLANDS SURVEYS PTY LTD, DO HEREBY CERTIFY THAT THIS DRAWING ACCURATELY AND CORRECTLY DESCRIBES AND RECORDS THE NATURE AND LOCATION OF THE WORKS DEPICTED BY ASTERISKS (*) HEREON AS THEY HAVE BEEN CONSTRUCTED.


BENJAMIN COOK (No. 4534)

22.05.2026
DATE


I, BRETT LANGTREE OF LANGTREE CONSULTING PTY LTD, HEREBY CERTIFY THAT THE WORKS AS SHOWN ON THE AS CONSTRUCTED DRAWINGS REFLECT ANY CHANGES THAT WERE MADE DURING THE COURSE OF CONSTRUCTION.

BRETT LANGTREE (RPEQ No. 11932)


22.05.2026
DATE

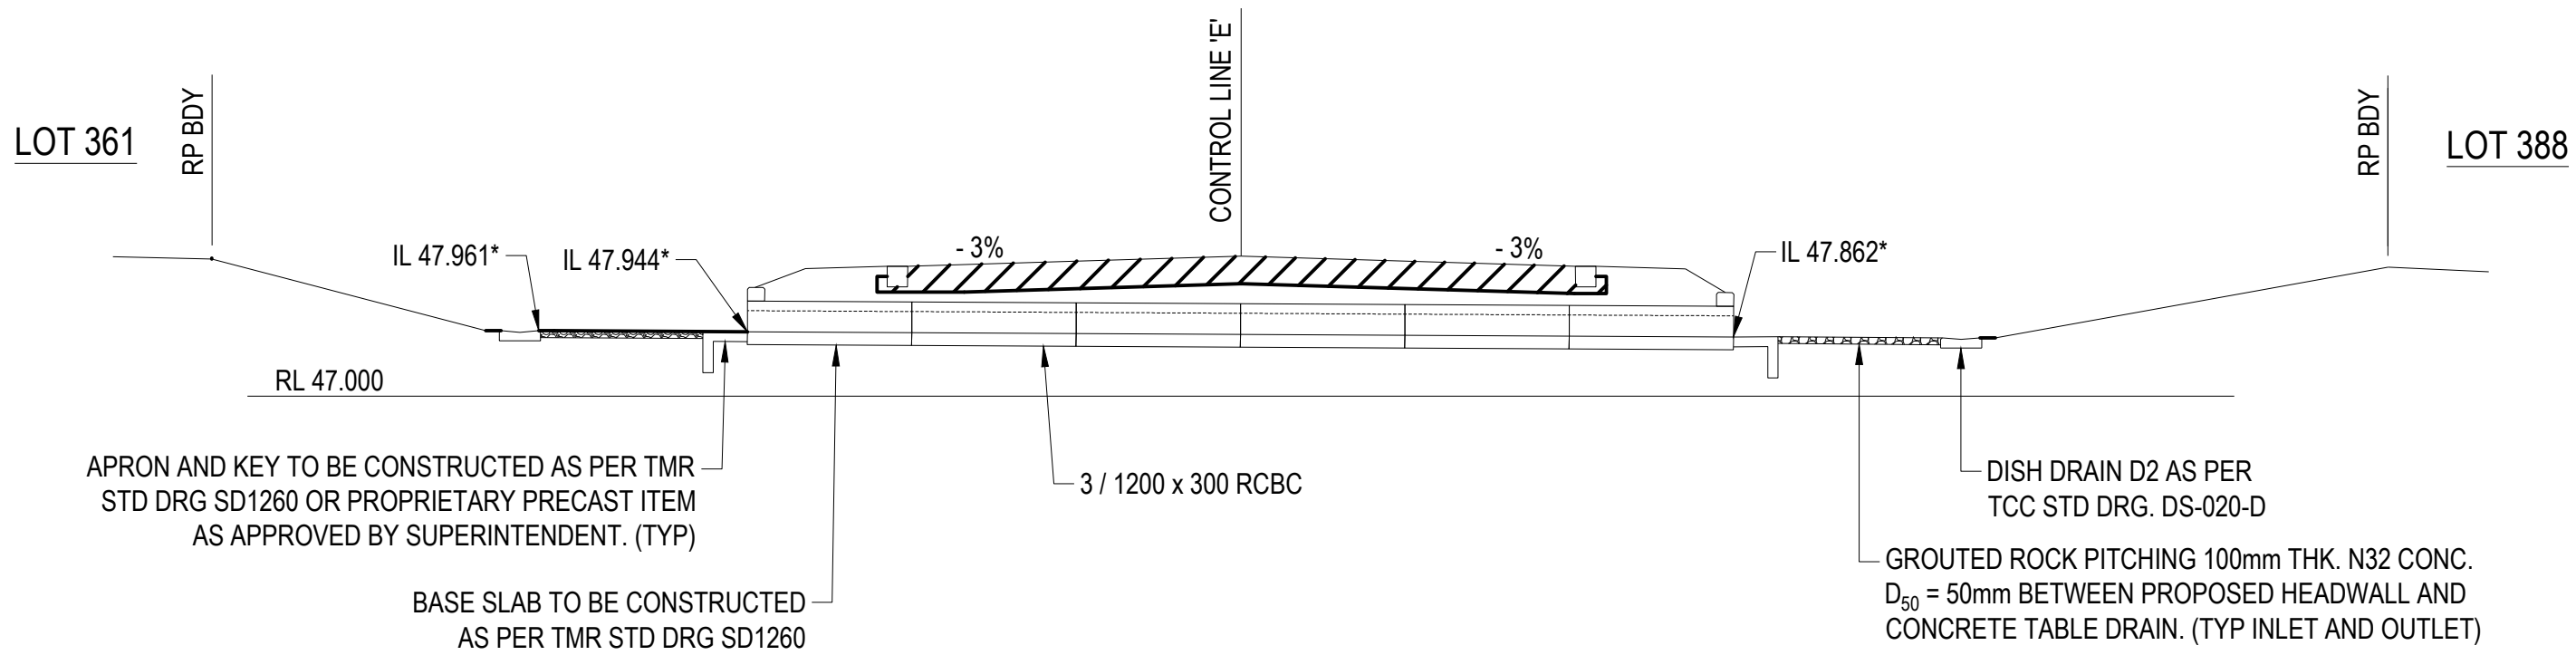

CULVERT 02 LONGITUDINAL SECTION - INTERSECTION OF COPPER ST AND DRUMMER STREET
SCALE 1:100

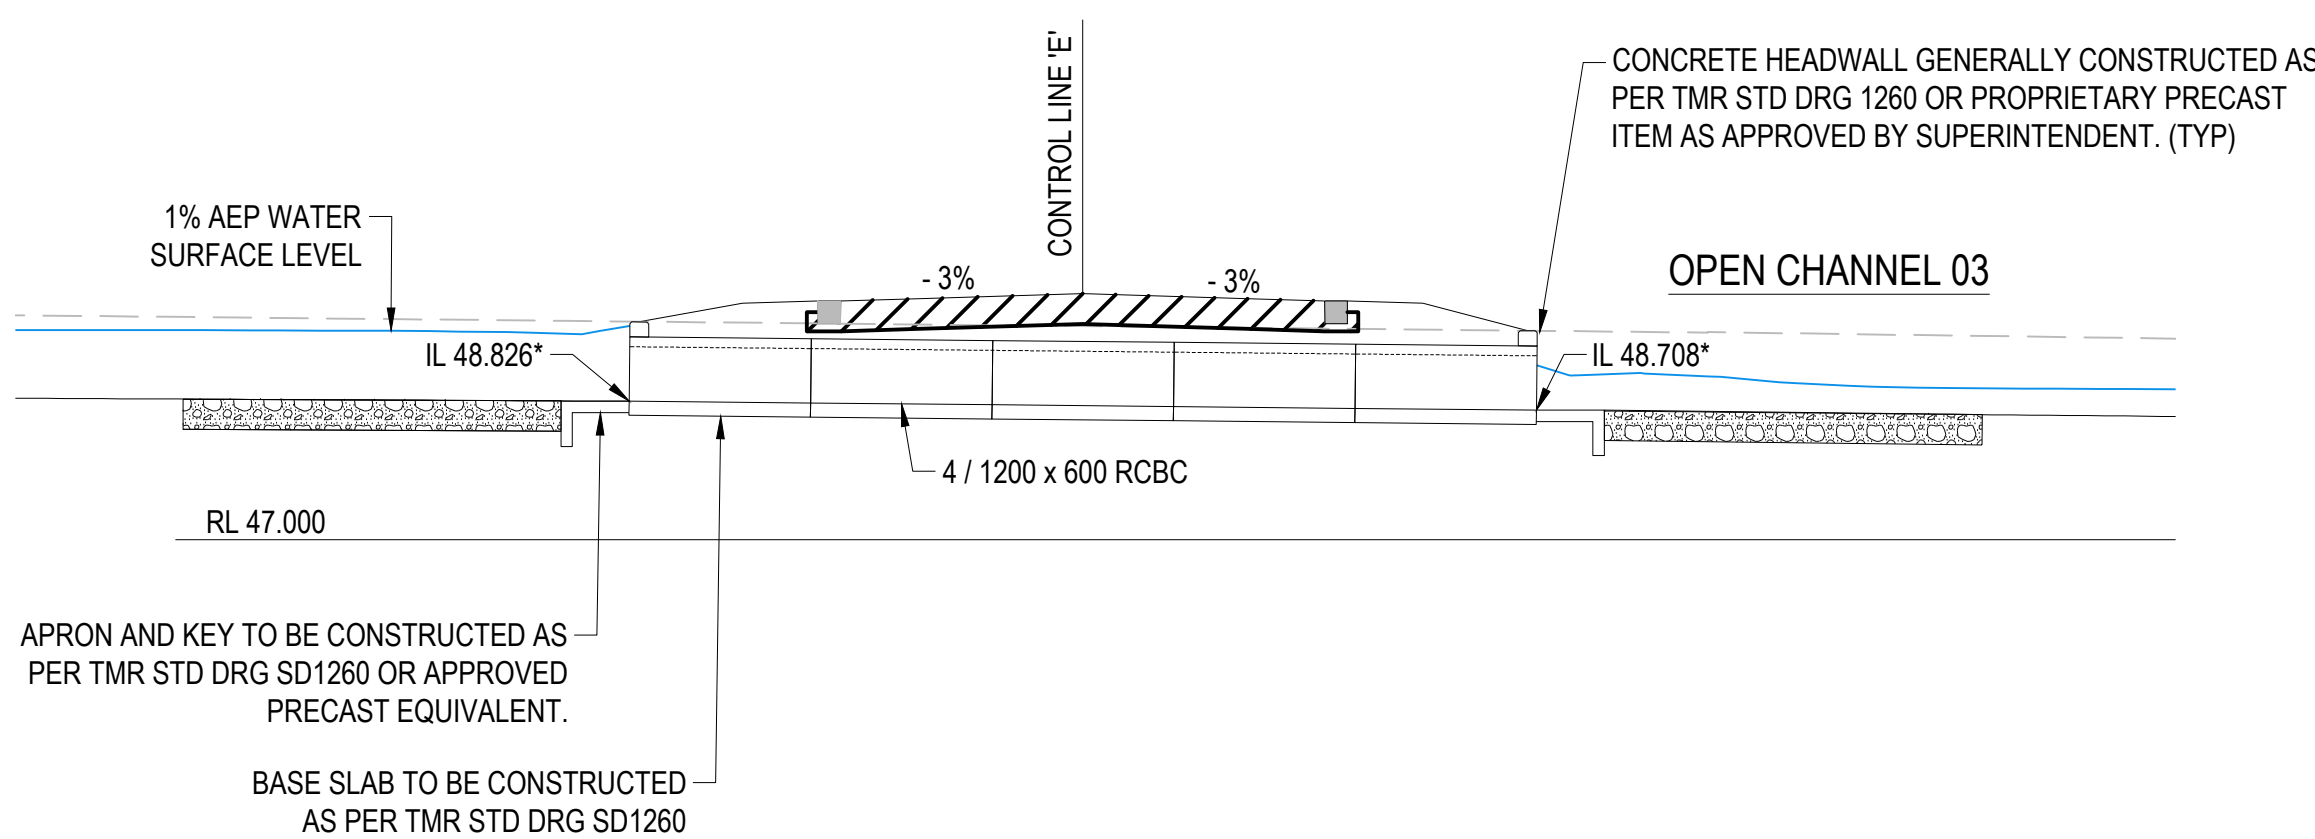

CULVERT 01 LONGITUDINAL SECTION - DRUMMER STREET
SCALE 1:100

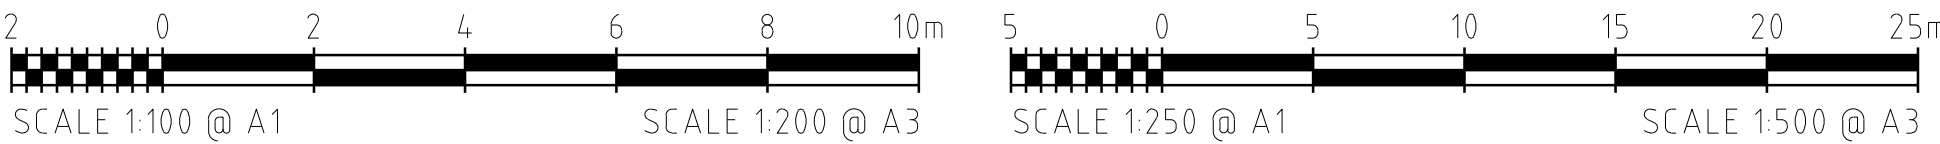


AS CONSTRUCTED
22 MAY 2026

REVISIONS	No.	BY	DATE	DESCRIPTION	HORIZ. DATUM	MT MARGARET GRID	CERTIFICATION
	1	B.S.	22.05.26	AS CONSTRUCTED	VERT. DATUM	AHD	COPYRIGHT
	0	M.V.	10.10.25	FOR CONSTRUCTION	DRG. FILE	0944	DATE
	D	B.L.	12.03.25	APPROVAL ISSUE - MINOR TEXT UPDATE	DESIGN	B.L.	NOV '24
	C	B.L.	13.12.24	APPROVAL ISSUE - SCOUR PROTECTION UPDATED	DRAWN	C.B.P.	NOV '24
	B	B.L.	06.12.24	APPROVAL ISSUE			

Langtree Consulting
m 0400 699 979
e brett@langtreeconsulting.com.au


MT MARGARET ESTATE STAGE 12 - OPERATIONAL WORKS
NICKEL STREET
ALICE RIVER, QLD, 4817
CULVERT LAYOUT AND LONGITUDINAL SECTIONS

SCALE	AS SHOWN				
SHEET	10 OF 12				
REVISION	A	B	C	D	0
DRG No.	0944 - ASC - C401				

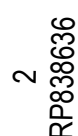


Accepted As Constructed


OPW24/0141
5/6/26

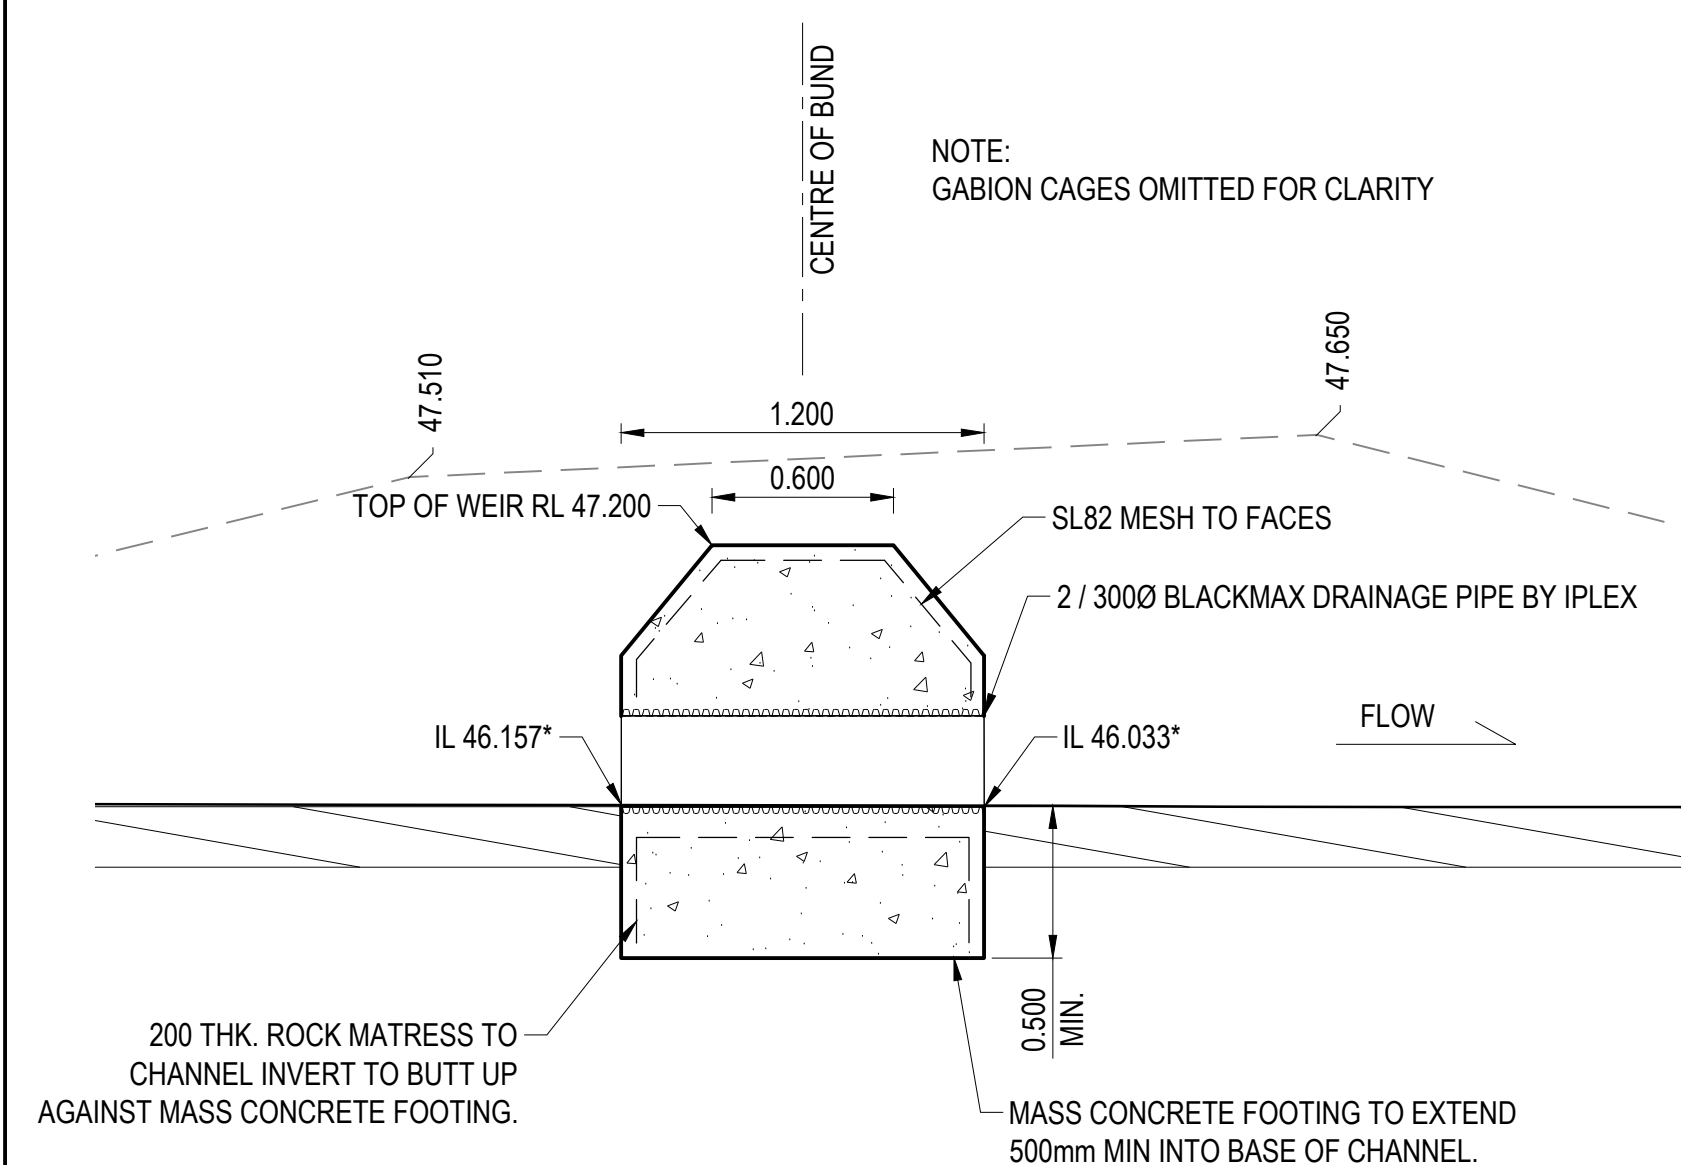

SECTION
SCALE 1:25

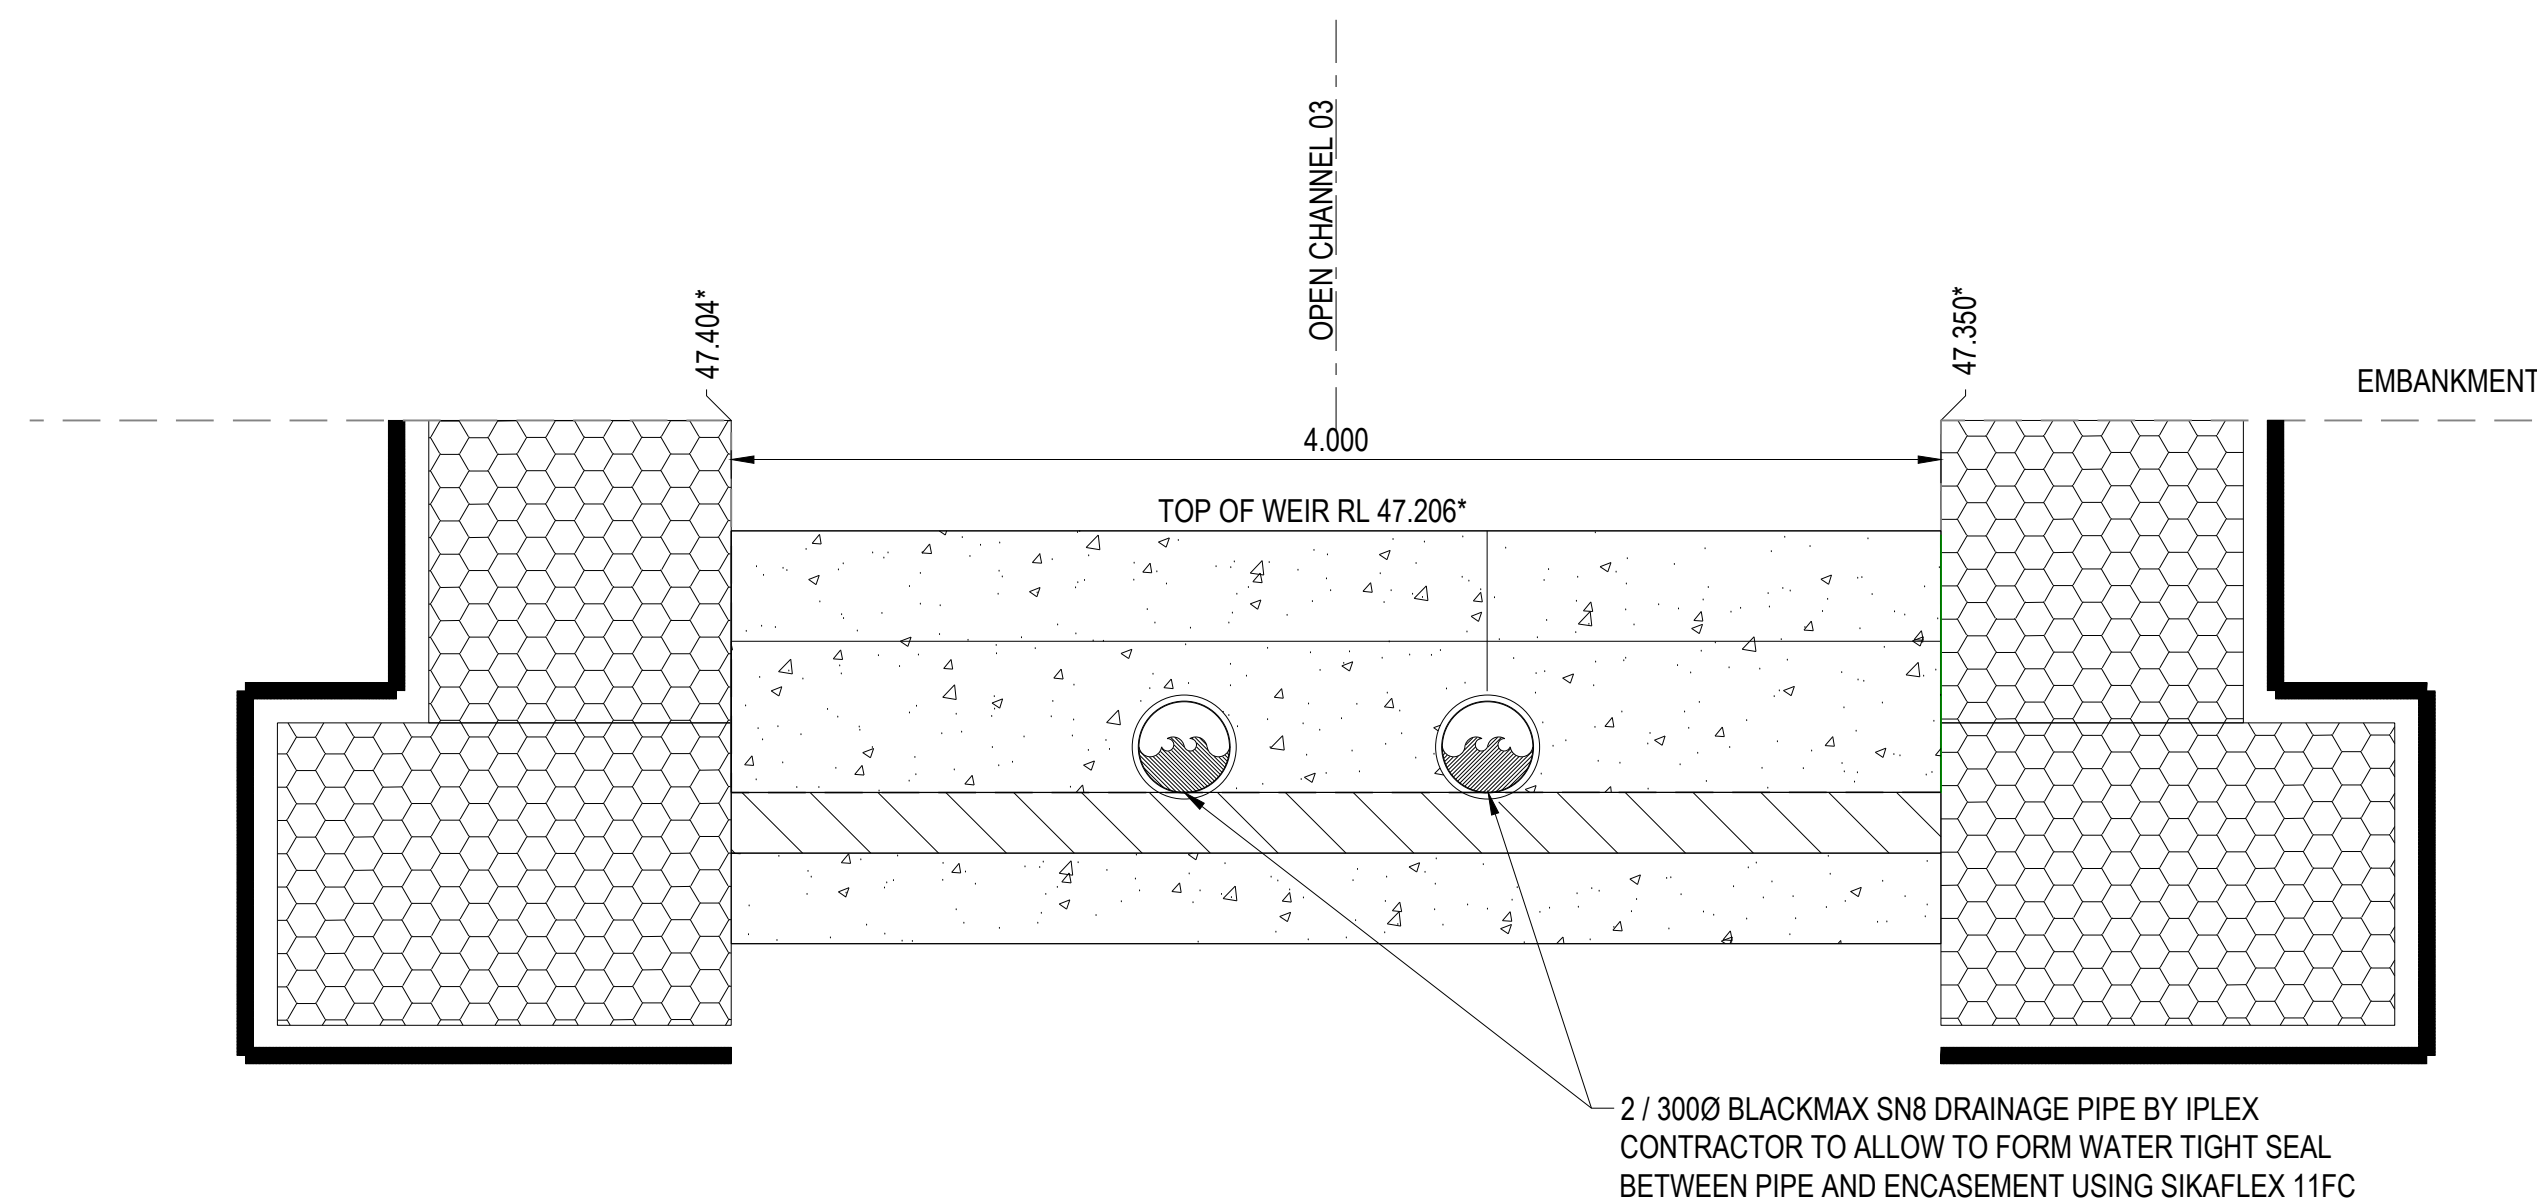

SECTION
SCALE 1:25

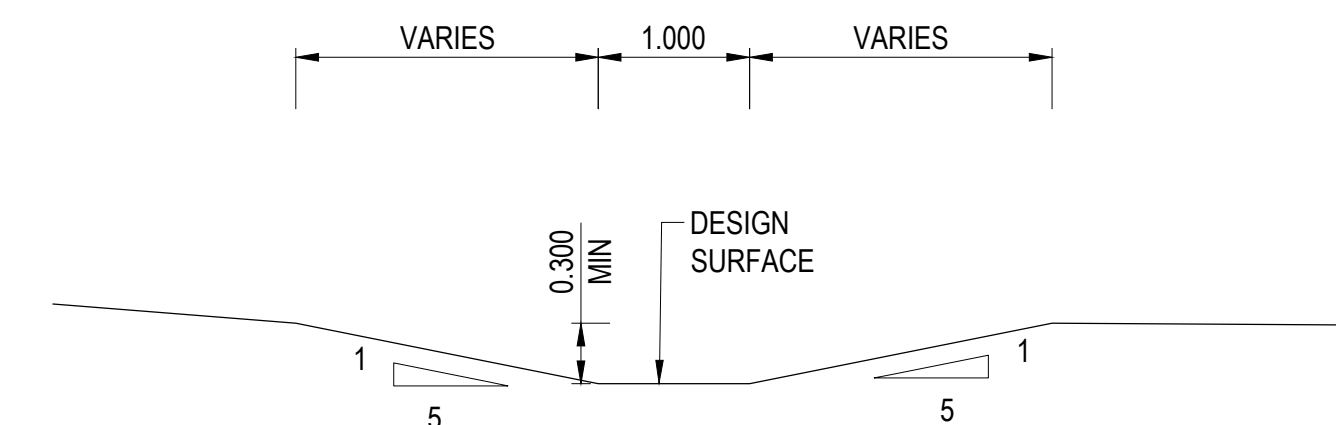

REAR OF LOT SWALE - TYPICAL SECTION

ROWLANDS SURVEYS PTY LTD, DO HEREBY CERTIFY THAT THIS
DRAWING ACCURATELY AND CORRECTLY DESCRIBES AND RECORDS
THE NATURE AND LOCATION OF THE WORKS DEPICTED BY
ASTERISKS (*) HEREON AS THEY HAVE BEEN CONSTRUCTED.


BENJAMIN COOK (No. 4534)

22.05.2026
DATE

I, BRETT LANGTREE OF LANGTREE CONSULTING PTY LTD, HEREBY CERTIFY THAT THE WORKS AS SHOWN ON THE AS CONSTRUCTED DRAWINGS REFLECT ANY CHANGES THAT WERE MADE DURING THE COURSE OF CONSTRUCTION.

BRETT LANGTREE (RPEQ No. 11932)

22.05.2026
DATE

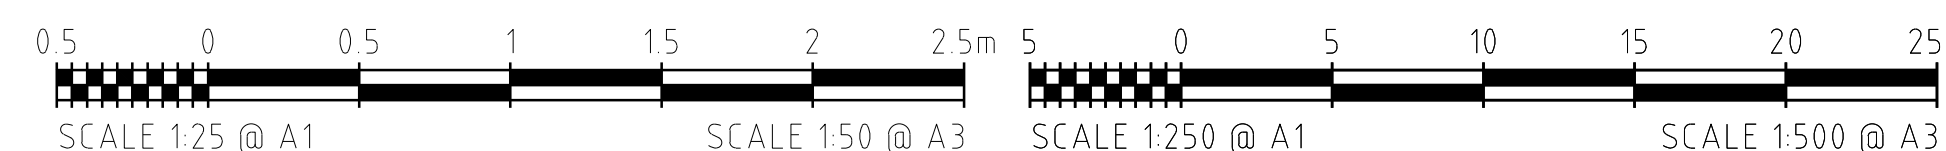

22 MAY 2026

REVISIONS	1	B.S.	22.05.26	AS CONSTRUCTED	HORIZ. DATUM		MT MARGARET GRID		CERTIFICATION		 m e 0400 699 979 brett@langtreeconsulting.com.au MT MARGARET ESTATE STAGE 12 - OPERATIONAL WORKS NICKEL STREET ALICE RIVER, QLD, 4817 , DRAINAGE DETAILS	SCALE	AS SHOWN			
	0	M.V.	10.10.25	FOR CONSTRUCTION	VERT. DATUM		AHD		COPYRIGHT © These designs and drawings are copyright and are not to be used or reproduced without the written permission of LANGTREE CONSULTING PTY LTD (ACN 29 611 368 024). The contents of this drawing are electronically generated, are confidential and may only be used for the purposes for which they were intended. This is an uncontrolled document issued for information purposes only, unless the checked sections are signed and approved. Figured dimensions take precedence over scale. Do not scale from this drawing.	SHEET		11 OF 12				
	C	B.L.	31.03.25	IAD SWALE DETAIL UPDATE	DRG. FILE		0944	DATE		REVISION		A	B	C	0	1
	B	B.L.	06.12.24	APPROVAL ISSUE	DESIGN		B.L.	NOV '24								
	A	B.L.	18.11.24	PRELIMINARY ISSUE	DRAWN		C.B.P.	NOV '24								
	No.	BY	DATE	DESCRIPTION								DRG No.	0944 - ASC - C402			

